

PREPARED FOR
BASSO BUILDERS
405 SKYLINE DR.
LAKE GENEVA WI. 53147

PLAT OF SURVEY

-OF-

LOTS 7495 THRU 7498 BLOCK 128, LAKE COMO BEACH
SUBDIVISION, TOWN 2 NORTH, RANGE 17 EAST,
WALWORTH COUNTY, WISCONSIN.

KROTT SURVEYING INC.




N3705 WILLOW BEND LANE

LAKE GENEVA WI. 53147

PHONE # (262)248-3697

FAX # (262)249-0639

C.L. POPLAR ROAD
(40' WIDE)

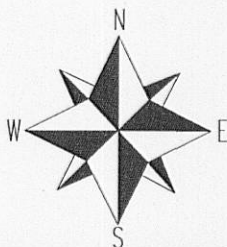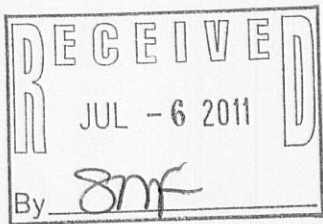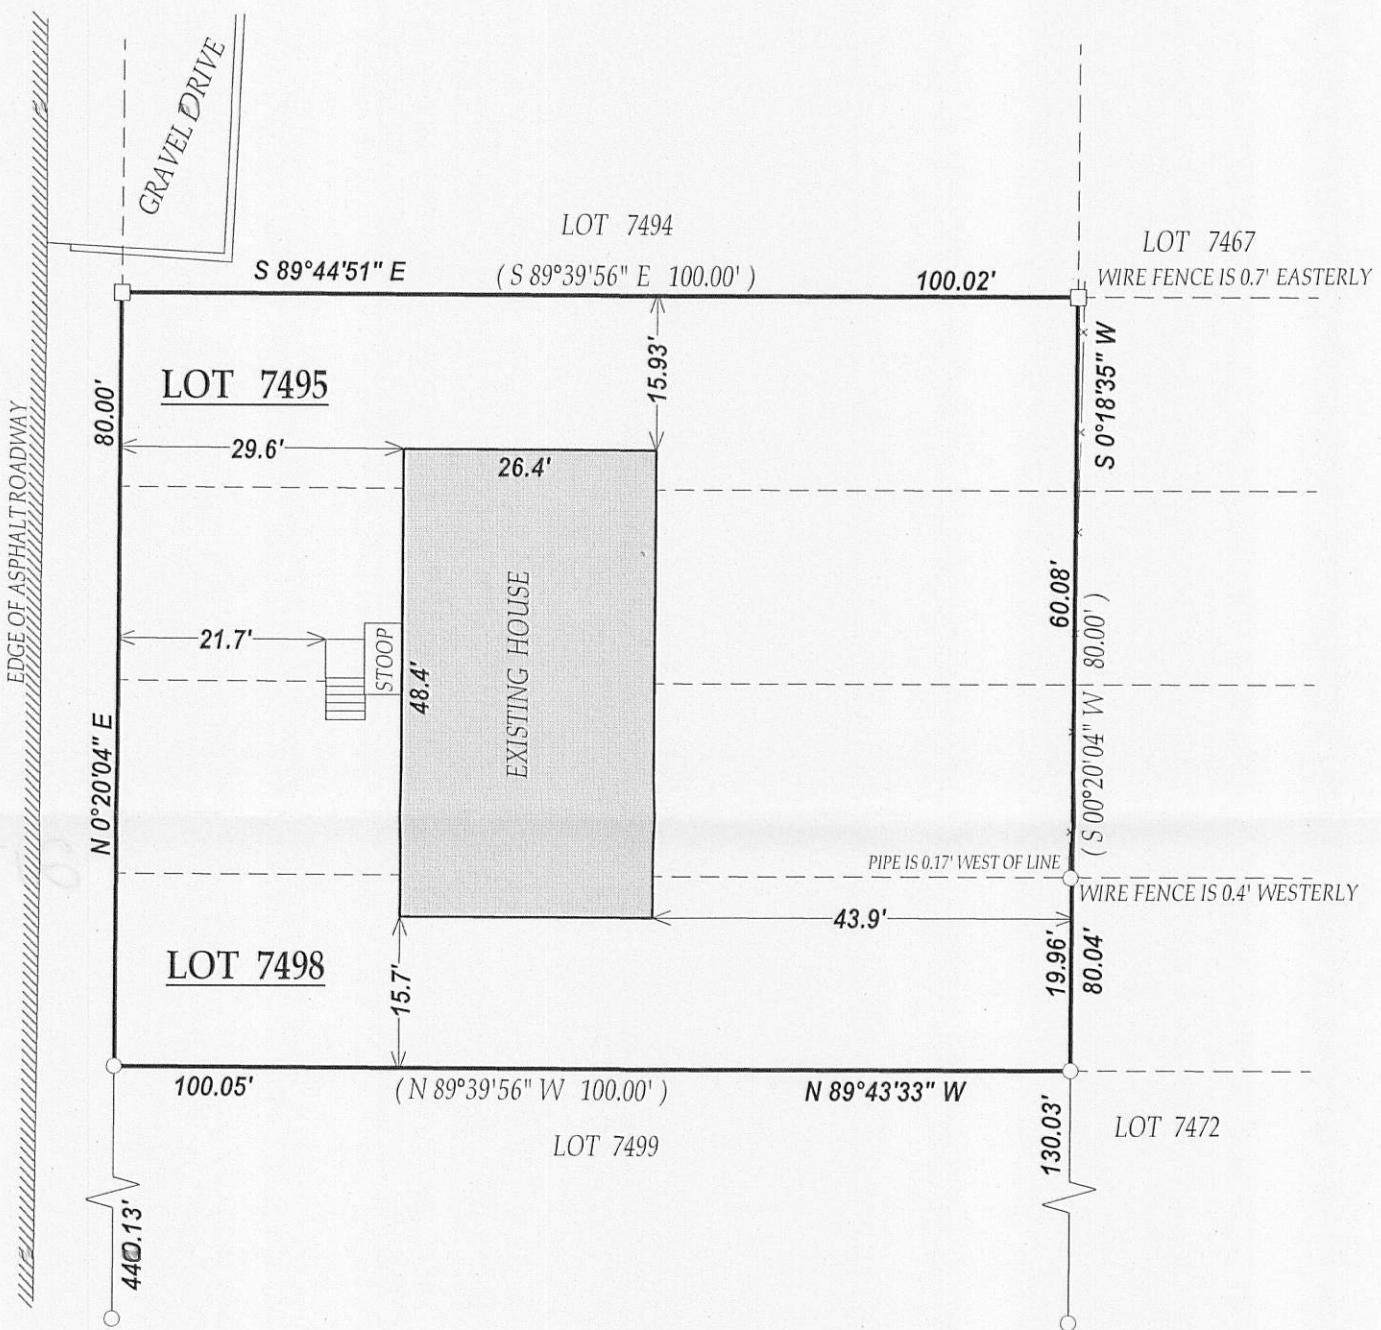

SCALE 1" = 20'

0 20 40 60 80

NOTE: BEARINGS BASIS IS THE RECORDED SUB PLAT
BEARINGS REFERENCED TO THE EAST R-O-W OF POPLAR RD.

"I hereby certify that I have surveyed the above described property and that
the above map is a true representation thereof and shows the size and
location of all visible structures, apparent easements and encroachments
if any."

This survey is made for the present owners of the property, and those who
purchase, mortgage, or guarantee the title thereto, within one year from
the date hereof.



DATE OF LAST REVISION 04 / 25 / 2011.

John P. Krott

JOHN KROTT S - 2258

Wisconsin Registered Land Surveyor
(original if signed in red)

DATED THIS 15th DAY OF APRIL 2009.

(xx) RECORDED AS

TAX ID # JLCB01592

JOB # 09-031AB

JLCB-1592

217-3724