

PREPARED FOR
FRED GELDERMAN
REMAX GENEVA REALTY
101 BROAD ST.
SUITE 102
LAKE GENEVA WI 53147


PLAT OF SURVEY

-OF-

LOTS 24 THRU 27, INCLUSIVE, IN BLOCK 15 IN SUNSET HILLS B SUBDIVISION,
SITUATED IN SECTION 33, TOWN 2 NORTH, RANGE 17 EAST, TOWN OF GENEVA,
WALWORTH COUNTY, WISCONSIN.

KROTT SURVEYING INC.

N3705 WILLOW BEND LANE
LAKE GENEVA WI, 53147
PHONE # (262)248-3697
FAX # (262)249-0639

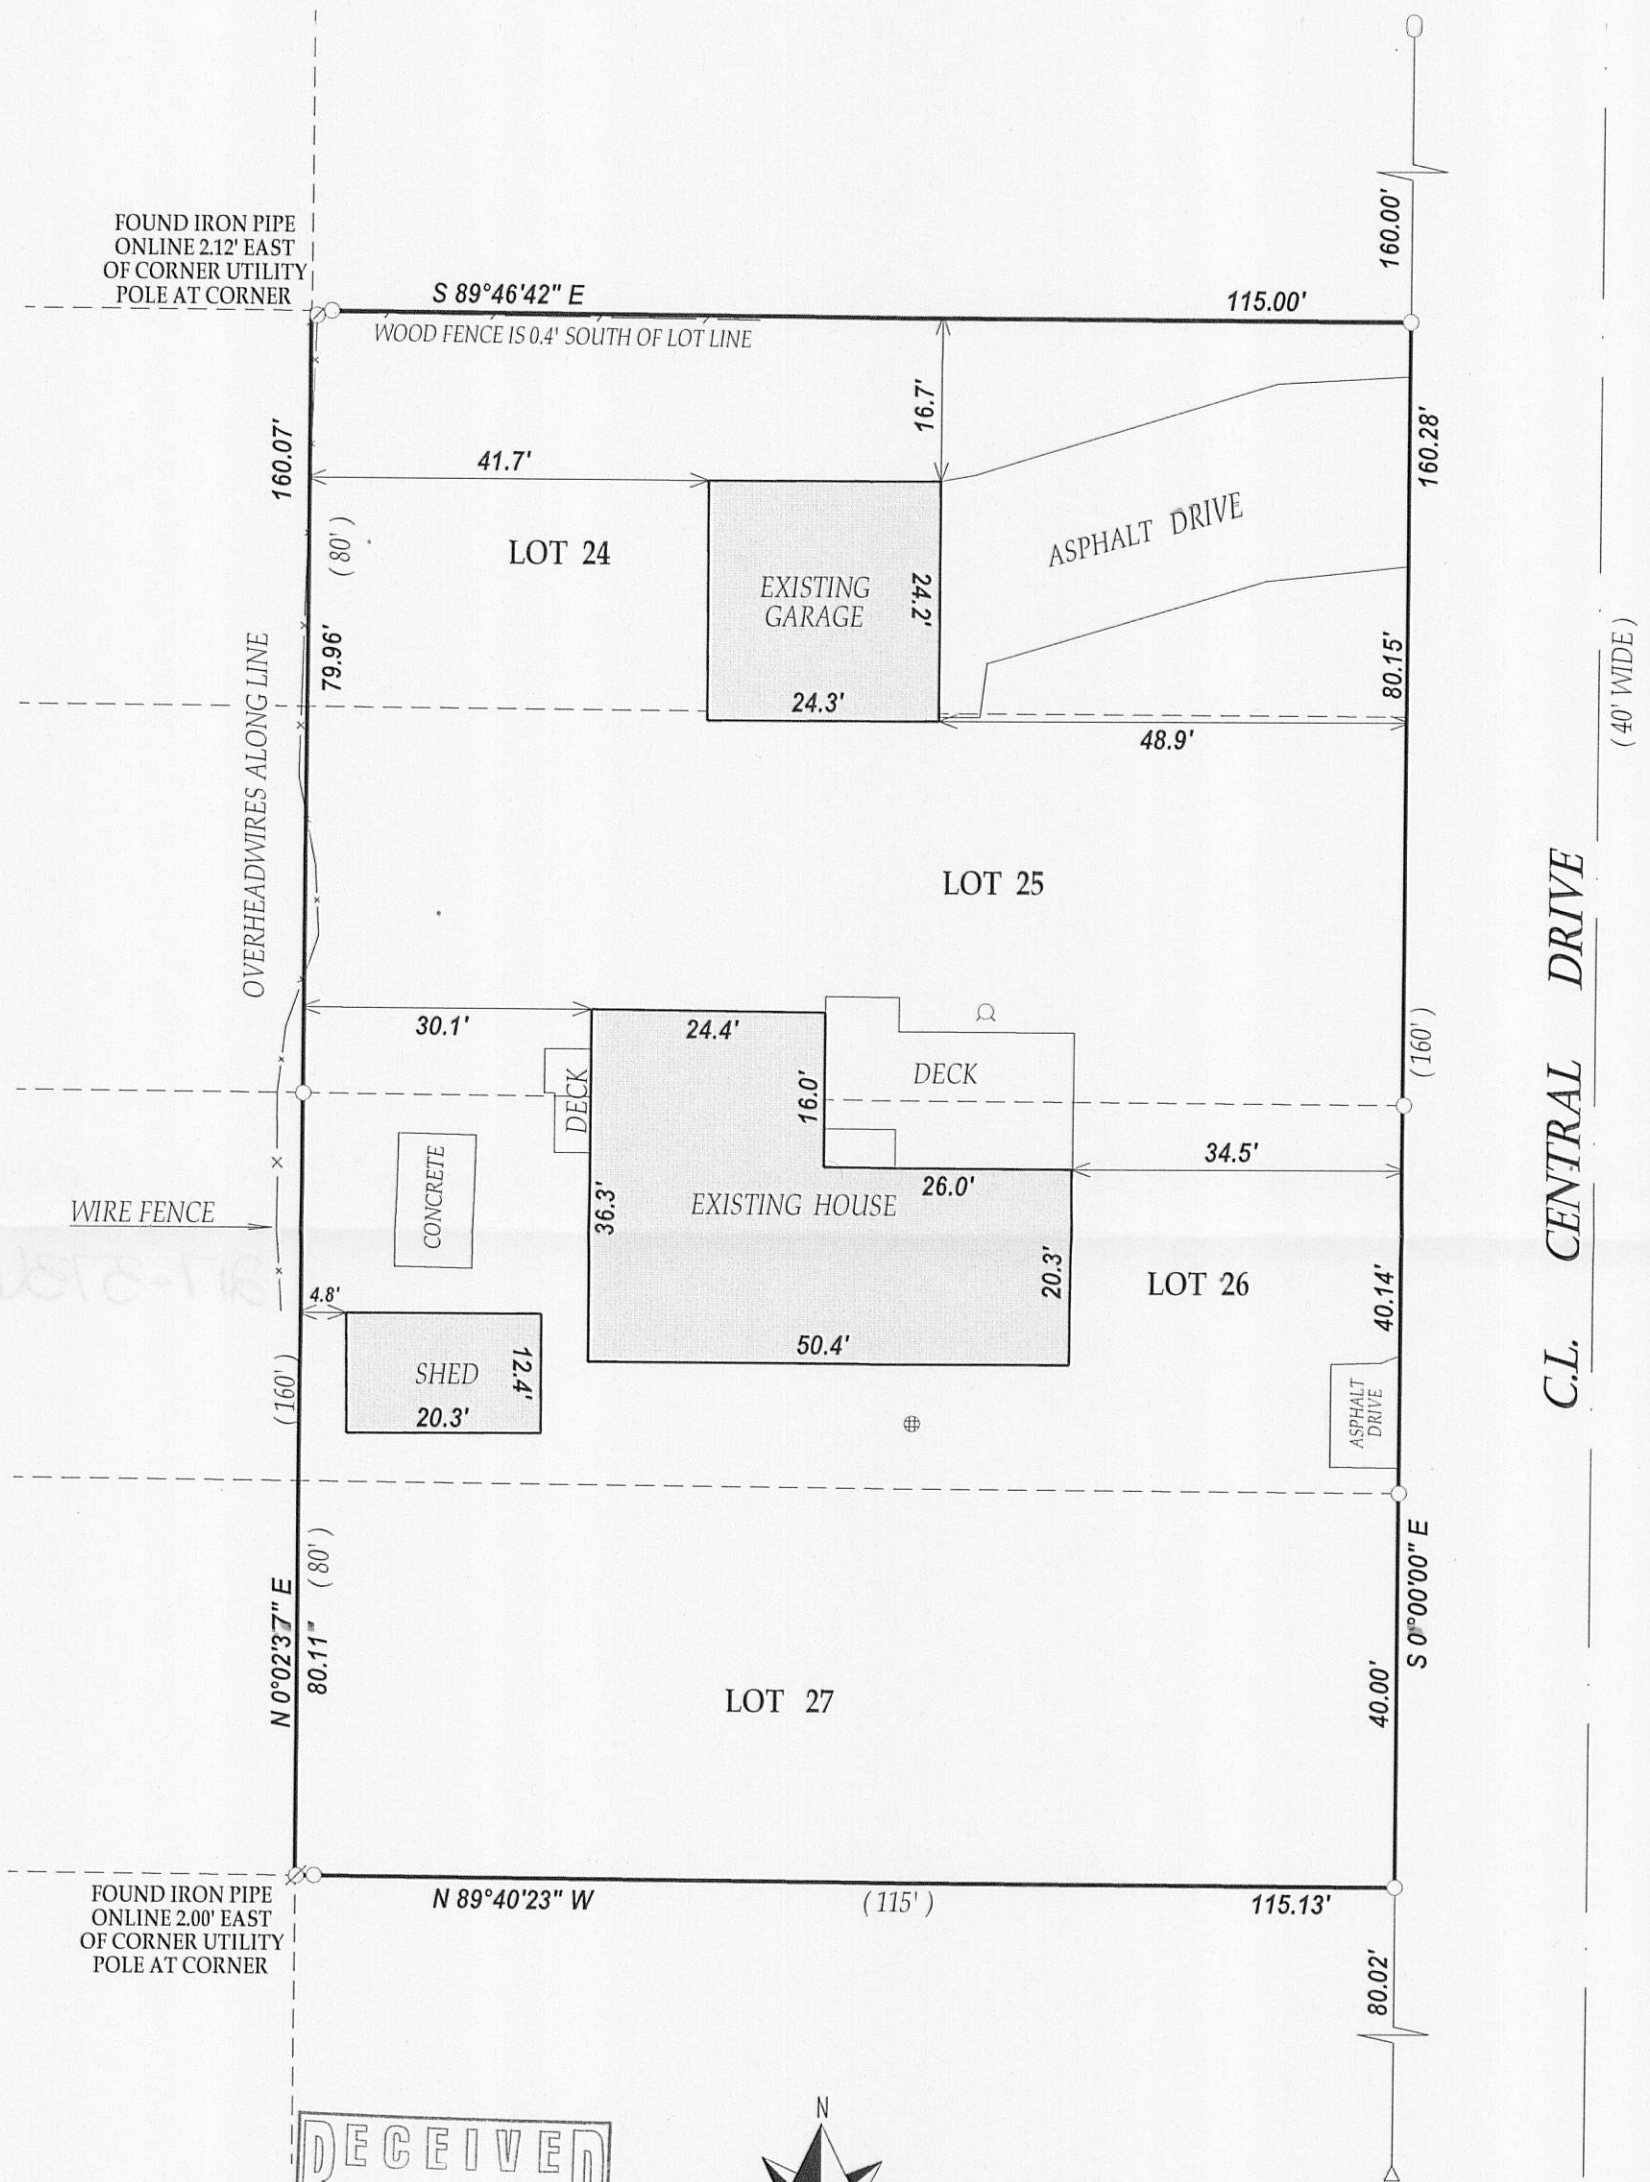

DATED THIS 12th DAY OF AUGUST 2011.

John P. Krott
JOHN KROTT S - 2258
Wisconsin Registered Land Surveyor
(original if signed in red)

JSH - 43 JSH - 44

217-3736