


7 RIDGWAY COURT- P.O. BOX 437
ELKHORN, WISCONSIN 53121
PHONE (262) 723-2098
FAX (262) 723-5886

PLAT OF SURVEY
LOT 1 OF BLOCK 27 SUNSET HILLS UNIT B
LOCATED IN THE SW 1/4 SEC. 33, TOWN 2 NORTH, RANGE 17 EAST
WALWORTH COUNTY, WISCONSIN.

ORDERED BY: HAROLD & JOYCE LARSEN
N2639 LAKE VIEW DRIVE
LAKE GENEVA, WI. 53147

RECEIVED
AUG 24 2011
By *SMR*

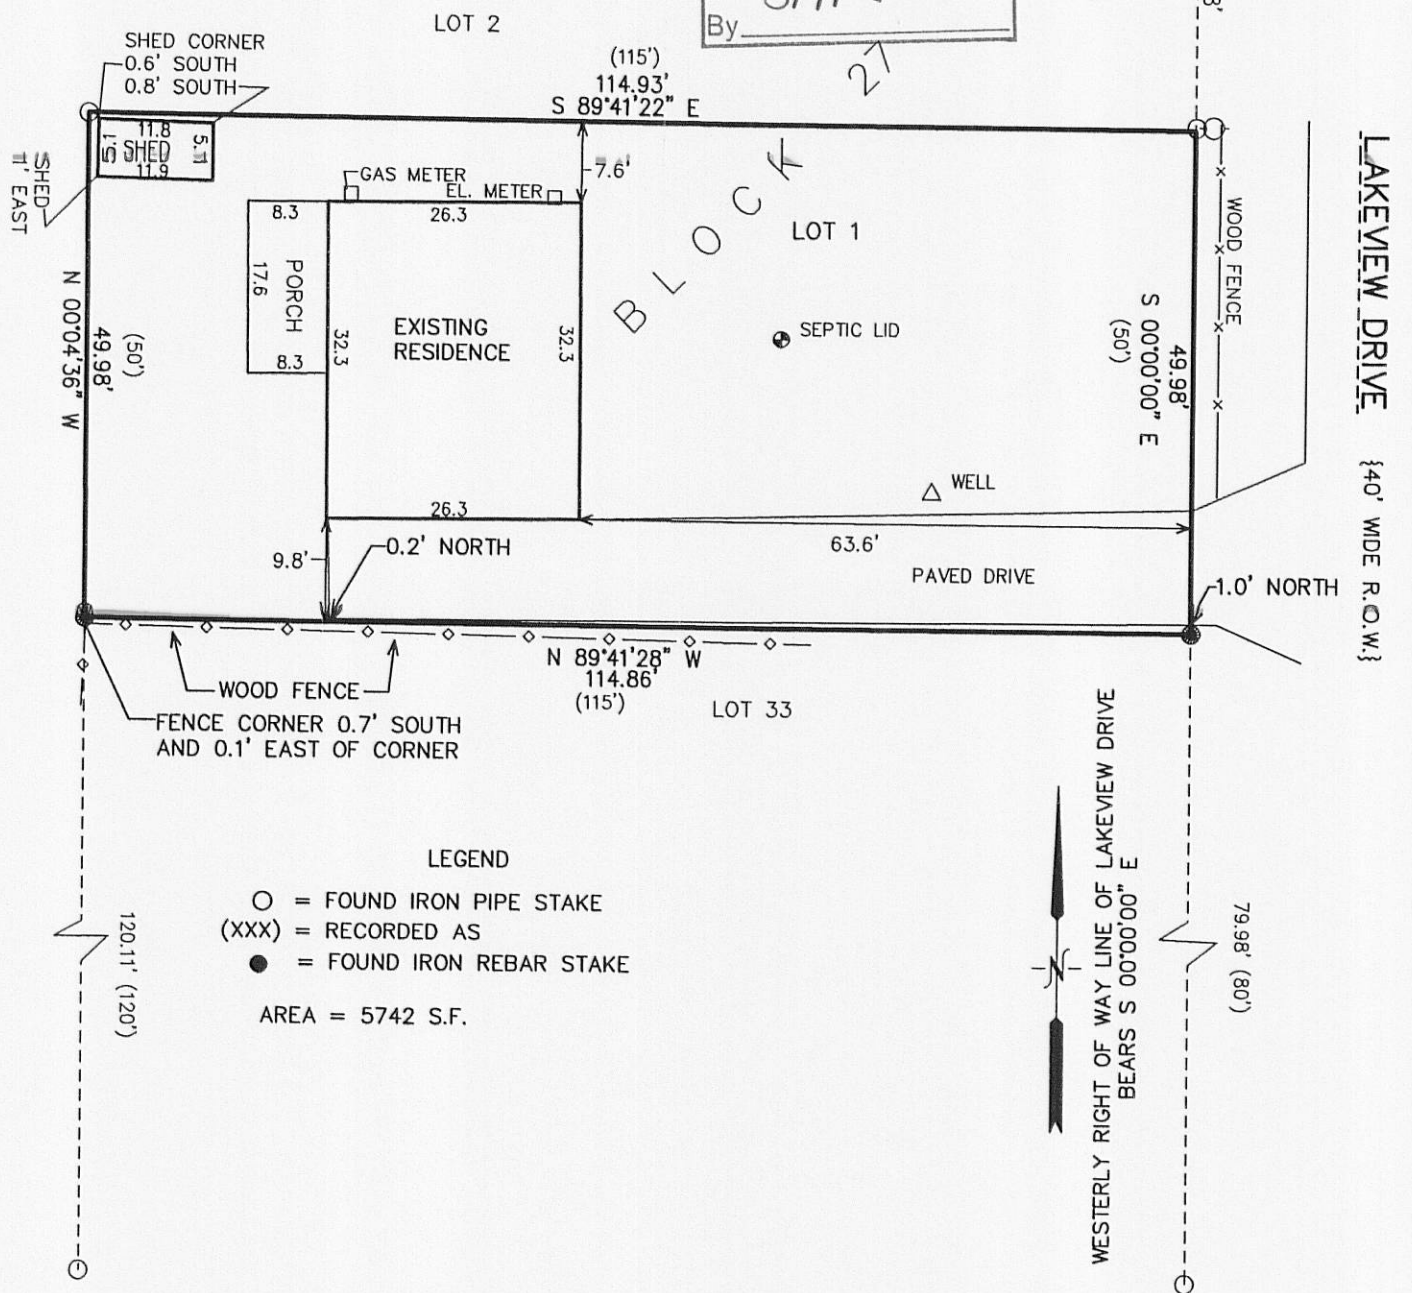

NOTE: COPIES OF THIS MAP TO WHICH THE FOLLOWING CERTIFICATE WILL APPLY SHOW SURVEYOR'S ORIGINAL SEAL AND SIGNATURE IN RED INK. COPIES BY ANY OTHER MEANS MAY HAVE ALTERATIONS WHICH DO NOT REPRESENT THE SURVEYOR'S WORK PRODUCT.

I HEREBY CERTIFY THAT THE ABOVE DESCRIBED PROPERTY HAS BEEN SURVEYED UNDER MY DIRECTION AND THAT THE ABOVE MAP IS A TRUE REPRESENTATION THEREOF AND SHOWS THE SIZE AND LOCATION OF THE PROPERTY AND ITS EXTERIOR BOUNDARIES. THIS SURVEY IS MADE FOR THE USE OF THE PRESENT OWNERS OF THE PROPERTY, AND ALSO THOSE WHO PURCHASE, MORTGAGE, OR GUARANTEE THE TITLE THERETO WITHIN ONE YEAR FROM THE DATE HEREOF.

DATED: JULY 19, 2011

PETER S. GORDON R.L.S. 2101

PROJECT NO. 8402

DATED: 07-18-2011

SHEET 1 OF 1 SHEETS

MAP SCALE IN FEET ORIGINAL 1" = 20'

217-3739