

PLAT OF SURVEY
LOTS 7383 THRU 7397 OF BLOCK 126
LAKE COMO BEACH
LOCATED IN SEC. 28, T2N, R17E
WALWORTH COUNTY, WISCONSIN

B L O C K 126


OPAL ROAD 40' WIDE

MAP SCALE IN FEET ORIGINAL 1" = 20'

ASSIGNED EAST LINE OPAL ROAD
N 00°00'00"E

LEGEND

- = FOUND IRON PIPE STAKE
- = SET IRON REBAR STAKE
- = FOUND IRON REBAR STAKE
- (xxx) = RECORDED AS
- VERTICAL DATUM USGS
- [856.8] = PROPOSED DRIVE GRADE
(2% LOWER THAN EOP)

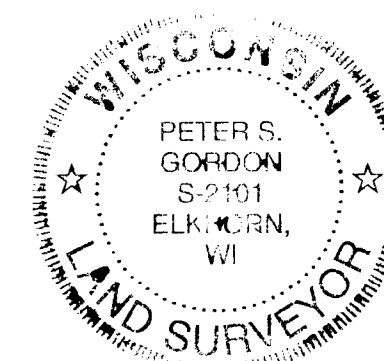

NOTE: COPIES OF THIS MAP TO WHICH THE FOLLOWING
CERTIFICATE WILL APPLY SHOW SURVEYOR'S ORIGINAL SEAL
AND SIGNATURE IN RED INK. COPIES BY ANY OTHER MEANS
MAY HAVE ALTERATIONS WHICH DO NOT REPRESENT THE
SURVEYOR'S WORK PRODUCT.

I HEREBY CERTIFY THAT THE ABOVE DESCRIBED PROPERTY HAS
BEEN SURVEYED UNDER MY DIRECTION AND THAT THE ABOVE MAP
IS A TRUE REPRESENTATION THEREOF AND SHOWS THE SIZE AND
LOCATION OF THE PROPERTY AND ITS EXTERIOR BOUNDARIES.
THIS SURVEY IS MADE FOR THE USE OF THE PRESENT OWNERS
OF THE PROPERTY, AND ALSO THOSE WHO PURCHASE, MORTGAGE,
OR GUARANTEE THE TITLE THERETO WITHIN ONE YEAR FROM THE
DATE HEREOF.

DATED: DECEMBER 5, 2001
REVISED 08-25-2011
TO SHOW PROPOSED RESIDENCE
REVISED 10-04-2011
TO SHOW ASBUILT & ADDITIONAL
GRADING INFO TO USGS DATUM
PETER S. GORDON R.L.S. 2101

WORK ORDERED BY:
JORDT BUILDERS
168 ELKHORN ROAD
WILLIAMS BAY, WI. 53191


FARRIS, HANSEN & ASSOCIATES, INC.
Engineering, Architecture, Surveying
7 Ridgeway Court P.O. Box 437
ELKHORN, WISCONSIN 53121
Office: (262) 723-2098
Fax: (262) 723-5886

REVISIONS

PROJECT NO.
5927
DATE:
12-05-01
SHEET NO.
1 OF 1

BENCH MKR
"X" ON HYDRANT
859.76'

100 YEAR FLOOD ELEVATION FOR
LAKE COMO PER FIRM PANEL 55127C0330D
DATED OCT. 2, 2009
EL. = 852'

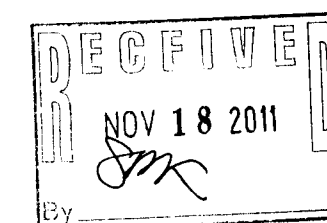

JLCB - 1568

217.3745