



PREPARED FOR
DANA MONTANA
5065 HIGHWAY "50"
DELAVAN WI 53115

PLAT OF SURVEY

KROTT SURVEYING INC.

N3705 WILLOW BEND LANE
LAKE GENEVA WI. 53147
PHONE # (262)248-3697
FAX # (262)249-0639

-OF-
LOTS 1649 THRU 1660 AND LOTS 1665 THRU 1676 BLOCK 27,
LAKE COMO BEACH SUBDIVISION, TOWN 2 NORTH, RANGE
17 EAST, WALWORTH COUNTY, WISCONSIN.

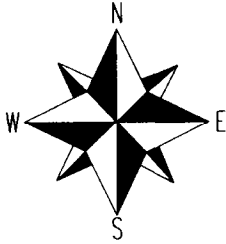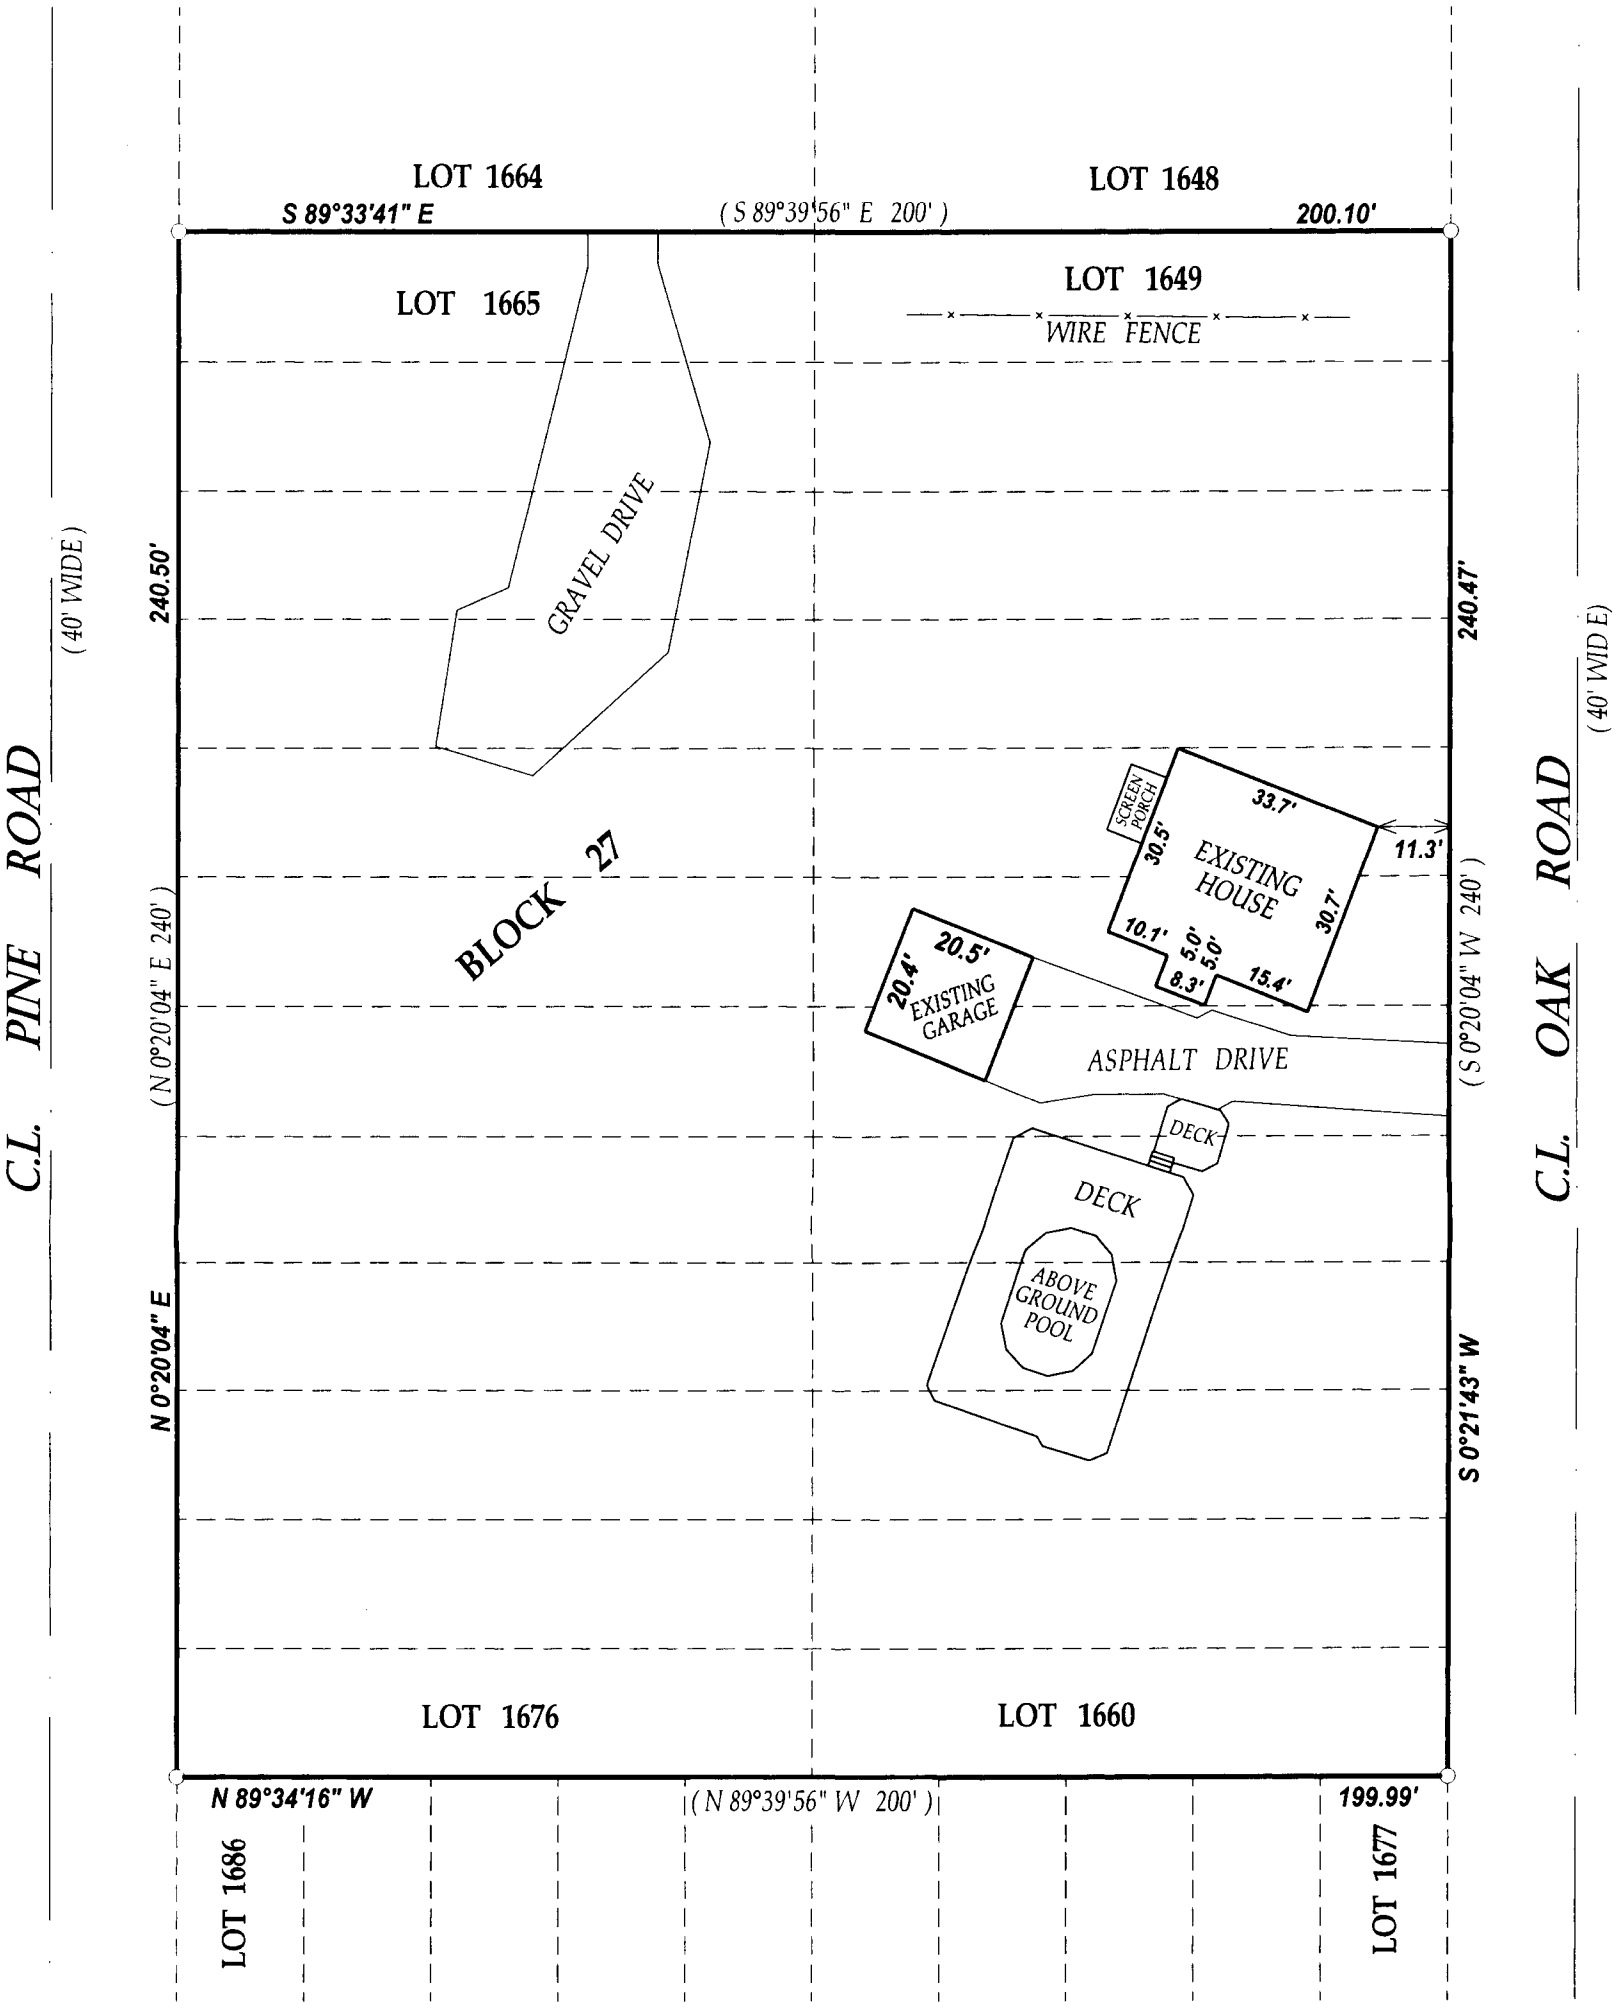


SCALE 1" = 30'



NOTE: BEARINGS ARE REFERENCED TO THE RECORD PLAT.

I have surveyed the above-described property and the above map is a true representation thereof and shows the size and location of the property, its exterior boundaries, the location and dimensions of all structures thereon, fences apparent easements and roadways and visible encroachments, if any.


This survey is made for the exclusive use of the present owners of the property, and also those who purchase, mortgage, or insure the title thereto within one (1) year from date hereof; and as to them I warrant the accuracy of said survey map.

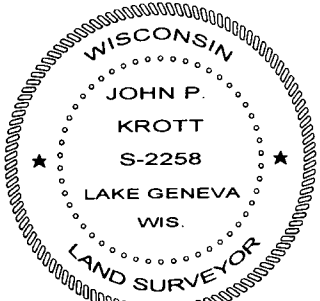

DATED THIS 17th DAY OF OCTOBER 2011.

John P. Krott

JOHN KROTT S - 2258
Wisconsin Registered Land Surveyor
(original if signed in red)

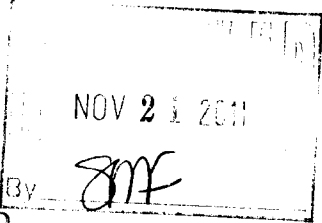

LEGEND

○ FOUND IRON PIPE

(XX) RECORDED AS
TAX ID # JLCB00258
JOB # 11-152

217 - 3755