

PREPARED FOR:
RALPH SEARLES
N3027 CANARY RD.
LAKE GENEVA, WI 53147

PLAT OF SURVEY

-OF-

KROTT SURVEYING INC.



N3705 WILLOW BEND LANE
LAKE GENEVA WI. 53147
PHONE # (262)248-3697
FAX # (262)249-0639

PARCEL "A" LOTS 11934 THRU 11939, BLOCK 214 OF THE FIFTH MAP OF LAKE COMO BEACH
A SUBDIVISION, LOCATED IN TOWN 2 NORTH, RANGE 17 EAST, WALWORTH
COUNTY, WISCONSIN.

PARCEL "B" LOTS 11940 THRU 11949, BLOCK 214 OF THE FIFTH MAP OF LAKE COMO BEACH
A SUBDIVISION, LOCATED IN TOWN 2 NORTH, RANGE 17 EAST, WALWORTH
COUNTY, WISCONSIN.

PARCEL "C" LOTS 11940 THRU 11944, BLOCK 214 OF THE FIFTH MAP OF LAKE COMO BEACH
A SUBDIVISION, LOCATED IN TOWN 2 NORTH, RANGE 17 EAST, WALWORTH
COUNTY, WISCONSIN.

NOTE: PARCEL "C" IS TO BE TAKEN
AWAY FROM PARCEL "B" AND ADDED
TO PARCEL "A"

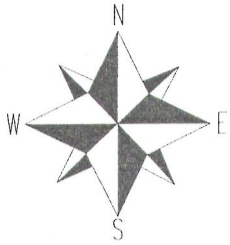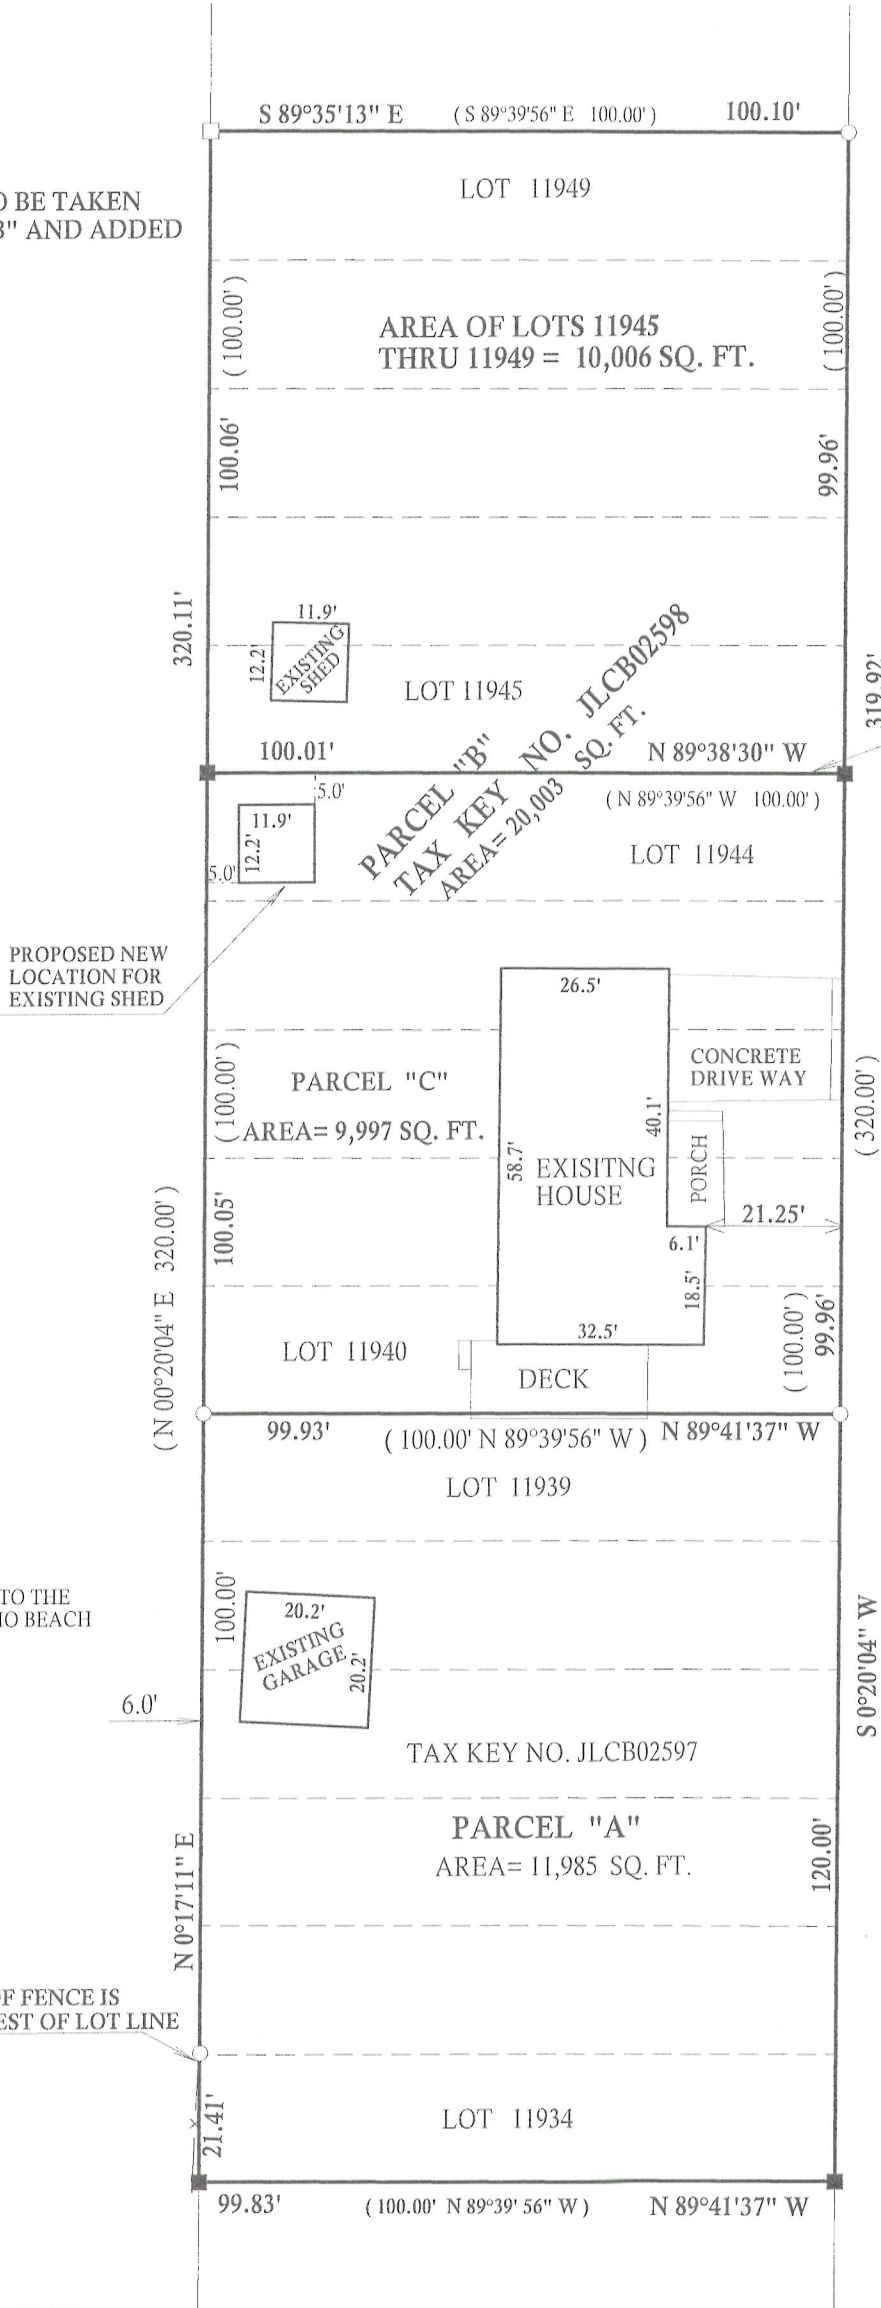

SCALE 1" = 30'

BEARINGS ARE REFERENCED TO THE
RECORDED PLAT OF LAKE COMO BEACH

LEGEND

- FOUND IRON PIPE
- SET IRON BAR
- (XX) RECORDED AS

JOB # 12-078

TAX ID # JLCB02597

PROPOSED LOT LINE FOR
TAX KEY # JLCB 02597



I have surveyed the above-described property and the above map is
a true representation thereof and shows the size and location of the
property, its exterior boundaries, the location and dimensions of all
structures thereon, fences apparent easements and roadways and
visible encroachments, if any.

This survey is made for the exclusive use of the present owners of
the property, and also those who purchase, mortgage, or insure the
title thereto within one (1) year from date hereof; and as to them I
warrant the accuracy of said survey map.



DATED THIS 26th, DAY OF JUNE, 2012

John P. Krott
JOHN KROTT S - 2258
Wisconsin Registered Land Surveyor
(original if signed in red)

217-3802