

PREPARED FOR
ALICIA LECH
4743 S. LARAMIE AVE.
CHICAGO IL. 60638

PLAT OF SURVEY

-OF-



KROTT SURVEYING INC.

N3705 WILLOW BEND LANE
LAKE GENEVA WI. 53147
PHONE # (262)248-3697
FAX # (262)249-0639

LOTS 11455 THRU 11460 BLOCK 206 OF THE FIFTH MAP OF LAKE COMO BEACH
SUBDIVISION LOCATED IN THE NORTHEAST 1/4 OF SECTION 29 TOWN 2 NORTH,
RANGE 17 EAST, WALWORTH COUNTY, WISCONSIN.

C.L. APRICOT ROAD

(40' WIDE)

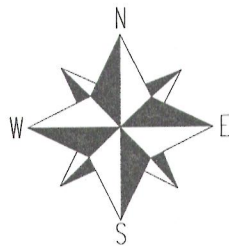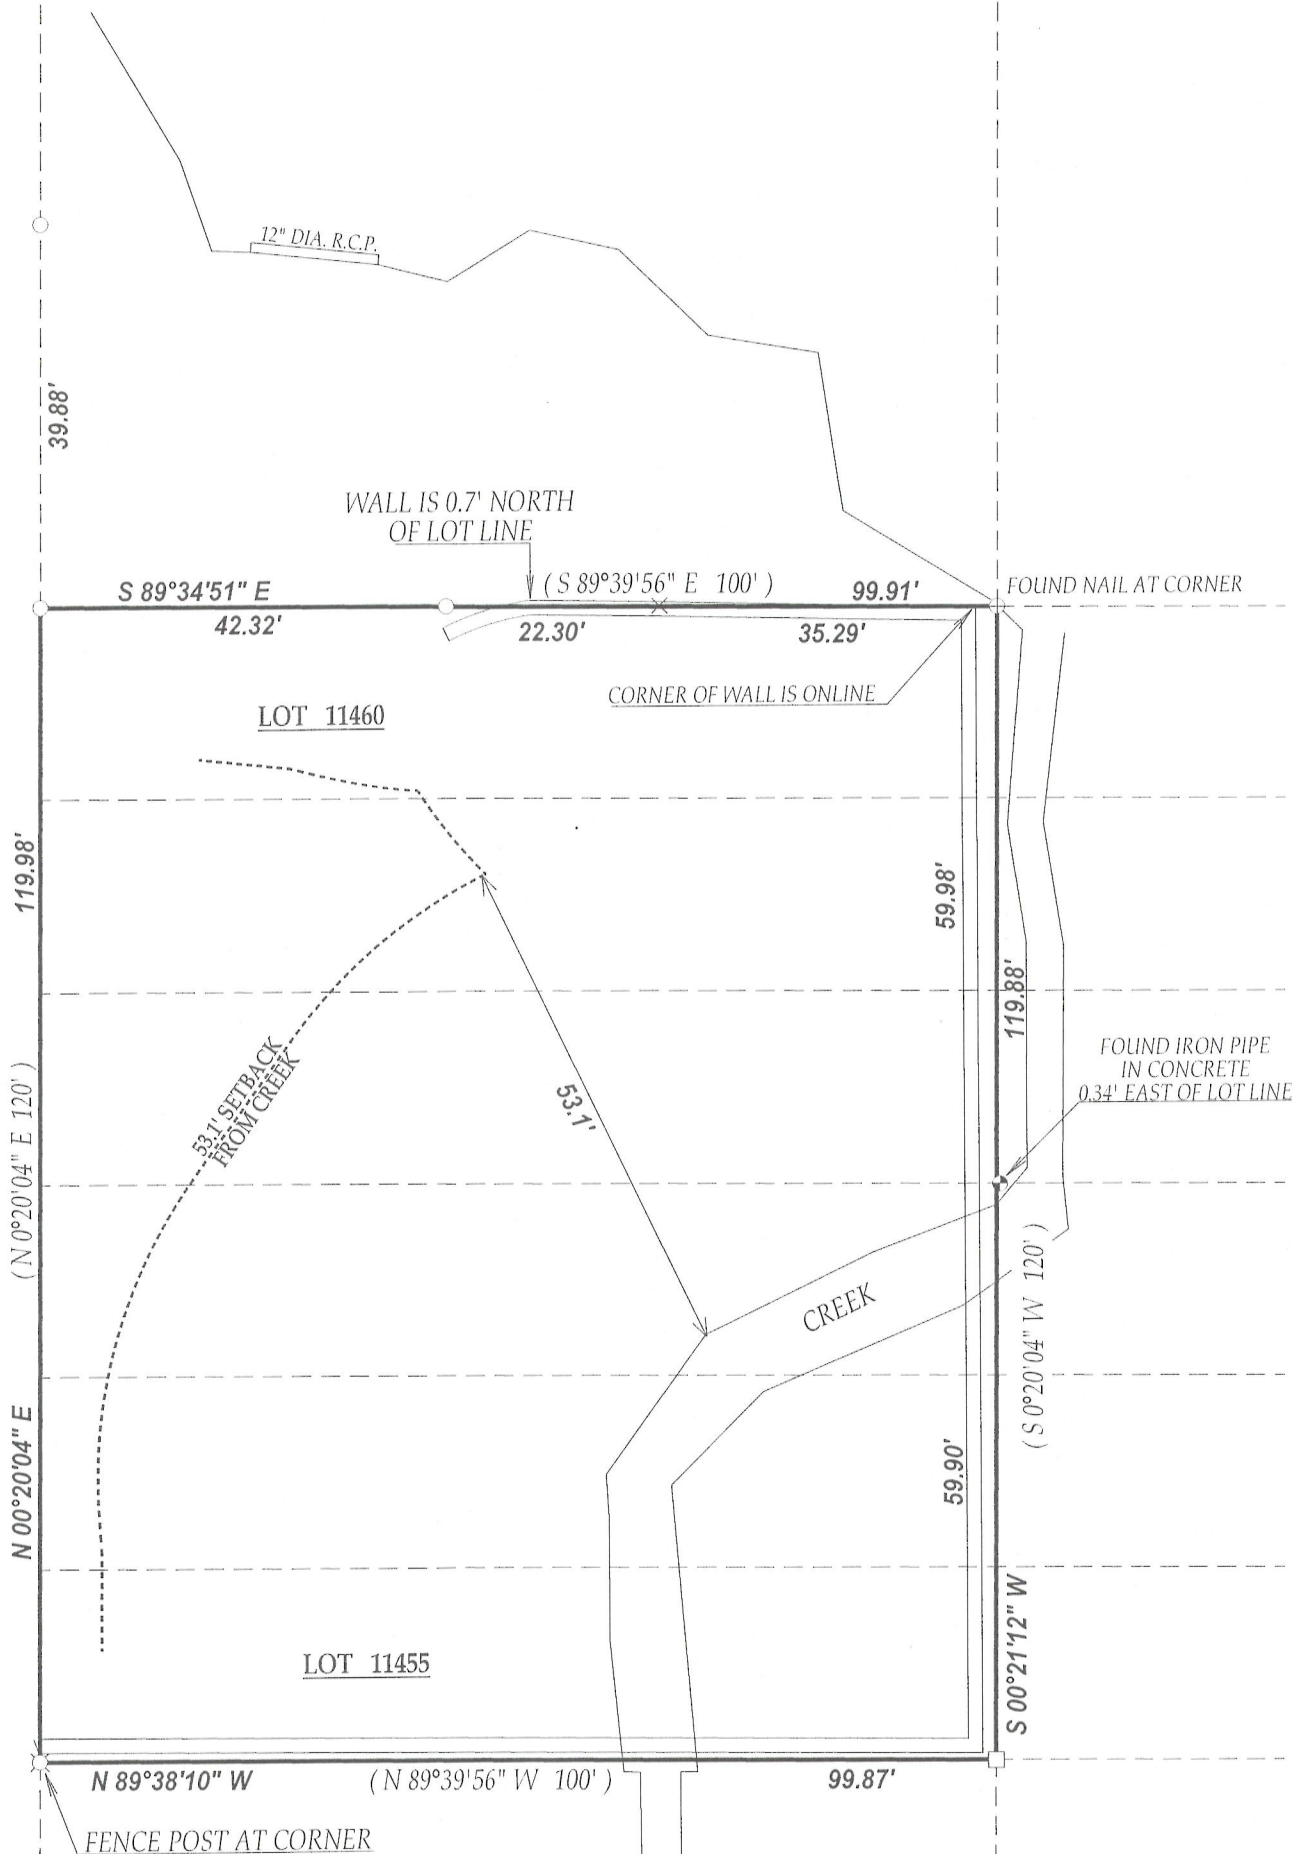


LEGEND

- FOUND IRON PIPE
- FOUND IRON BAR
- × FOUND CUT CROSS

(XX) RECORDED AS



TAX ID # JLCB02491

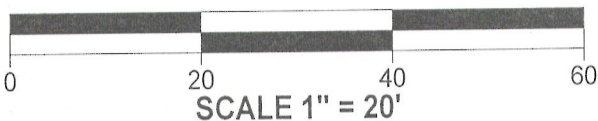

EXISTING HOUSE

I have surveyed the above-described property and the above map is a true representation thereof and shows the size and location of the property, its exterior boundaries, the location and dimensions of all structures thereon, fences apparent easements and roadways and visible encroachments, if any.

This survey is made for the exclusive use of the present owners of the property, and also those who purchase, mortgage, or insure the title thereto within one (1) year from date hereof; and as to them I warrant the accuracy of said survey map.

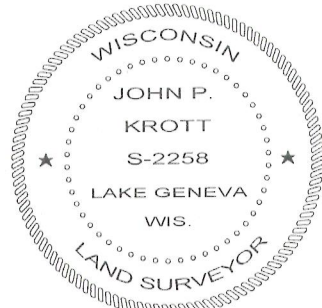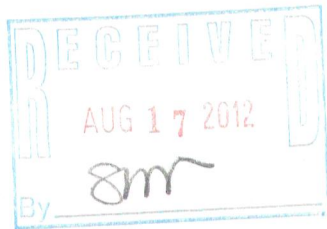

DATED THIS 12th DAY OF JULY 2012

John P. Krott

JOHN KROTT S - 2258
Wisconsin Registered Land Surveyor
(original if signed in red)