


SITE, GRADING, DRAINAGE & EROSION CONTROL PLAN

LOT 15 OF LAKE FOREST ESTATES
TOWN OF GENEVA, WALWORTH COUNTY, WISCONSIN

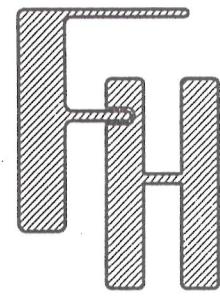

LOT 15 LAKE FOREST ESTATES
TOWN OF GENEVA, WALWORTH COUNTY, WISCONSIN

WORK ORDERED BY/BUILDER:
JASON KONRAD
2523 KNOB HILL ROAD
JOHNSBURG, IL. 60051

FARRIS, HANSEN & ASSOCIATES, INC.
ENGINEERING - ARCHITECTURE - SURVEYING
7 RIDGWAY COURT P.O. BOX 437
ELKHORN, WISCONSIN 53121
OFFICE: (262) 723-2098 FAX: (262) 723-5886

REVISIONS
06-27-2012
ADD REC. BORINGS

PROJECT NO.
4176.15
DATE
06-06-2012
SHEET NO.
1 OF 1

LAKE FOREST CIRCLE
66' WIDE

68.28
R=643.00
C=68.25
S 08° 28' 12" E

25' STREET YARD

353.87
R=797.00
C=350.97
S 01° 09' 13" W

88.10
R=89.00
C=88.10
S 53° 28' 29" W

LOT 15
2.45 AC.

LAKE FOREST LANE
66' WIDE

84.44
R=58.00
C=84.06
S 83° 42' 29" W

85.21
R=110.00
C=85.08
S 80° 03' 10" W

AS BUILT FOUNDATION LOCATED 08-28-2012


RECORD POSITION SOIL
BORING FROM 1994

RECORD POSITION SOIL
BORING FROM 1994

RECORD POSITION SOIL
BORING FROM 1994

LEGEND
● = FOUND IRON REBAR STAKE
(XXX) = RECORDED AS

CURRENT ZONING = C-3

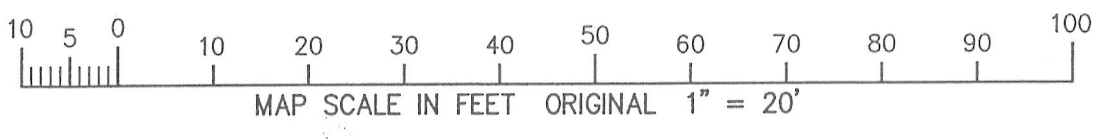

NOTE: COPIES OF THIS MAP TO WHICH THE FOLLOWING CERTIFICATE WILL APPLY SHOW THE SURVEYOR'S ORIGINAL SEAL AND SIGNATURE IN RED INK. COPIES BY ANY OTHER MEANS MAY HAVE ALTERATIONS WHICH DO NOT REPRESENT THE SURVEYOR'S WORK PRODUCT.

I HEREBY CERTIFY THAT THIS PLAT IS A TRUE AND ACCURATE REPRESENTATION OF THE LOCATION OF THE PROPOSED RESIDENCE IN RELATION TO THE NORTHEAST, AND SOUTHEAST CORNERS OF LOT 15 OF LAKE FOREST ESTATES TO THE BEST OF MY PROFESSIONAL KNOWLEDGE AND BELIEF. NOTE: THIS IS NOT A SURVEY AS DEFINED IN CHAPTER A-E 7 OF WISCONSIN ADMINISTRATIVE CODE.

DATED: JULY 10, 2012
PETER S. GORDON RLS 2101
REVISED 08-29-2012
TO SHOW SIZE & LOCATION OF AS BUILT FOUNDATION



217-3821

8/29/2012 x:\Projects\4176\Indef\Lot_15\Draw\ASBUILT

JLFE-15