




PLAT OF SURVEY & TOPOGRAPHICAL MAPPING

LOTS 11196-11205 & 11234-11238, BLK. 202 OF LAKE COMO SUBDIVISION

LOCATED IN PART OF THE NORTHEAST 1/4 OF SECTION 29, TOWN 2 NORTH,
RANGE 17 EAST, WALWORTH COUNTY, WISCONSIN

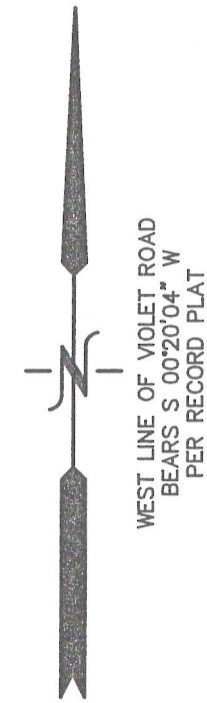

WILLOW ROAD
{40' WIDE R.O.W.}

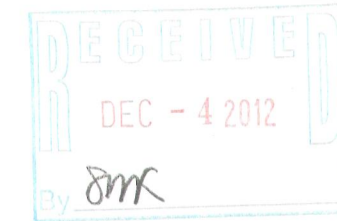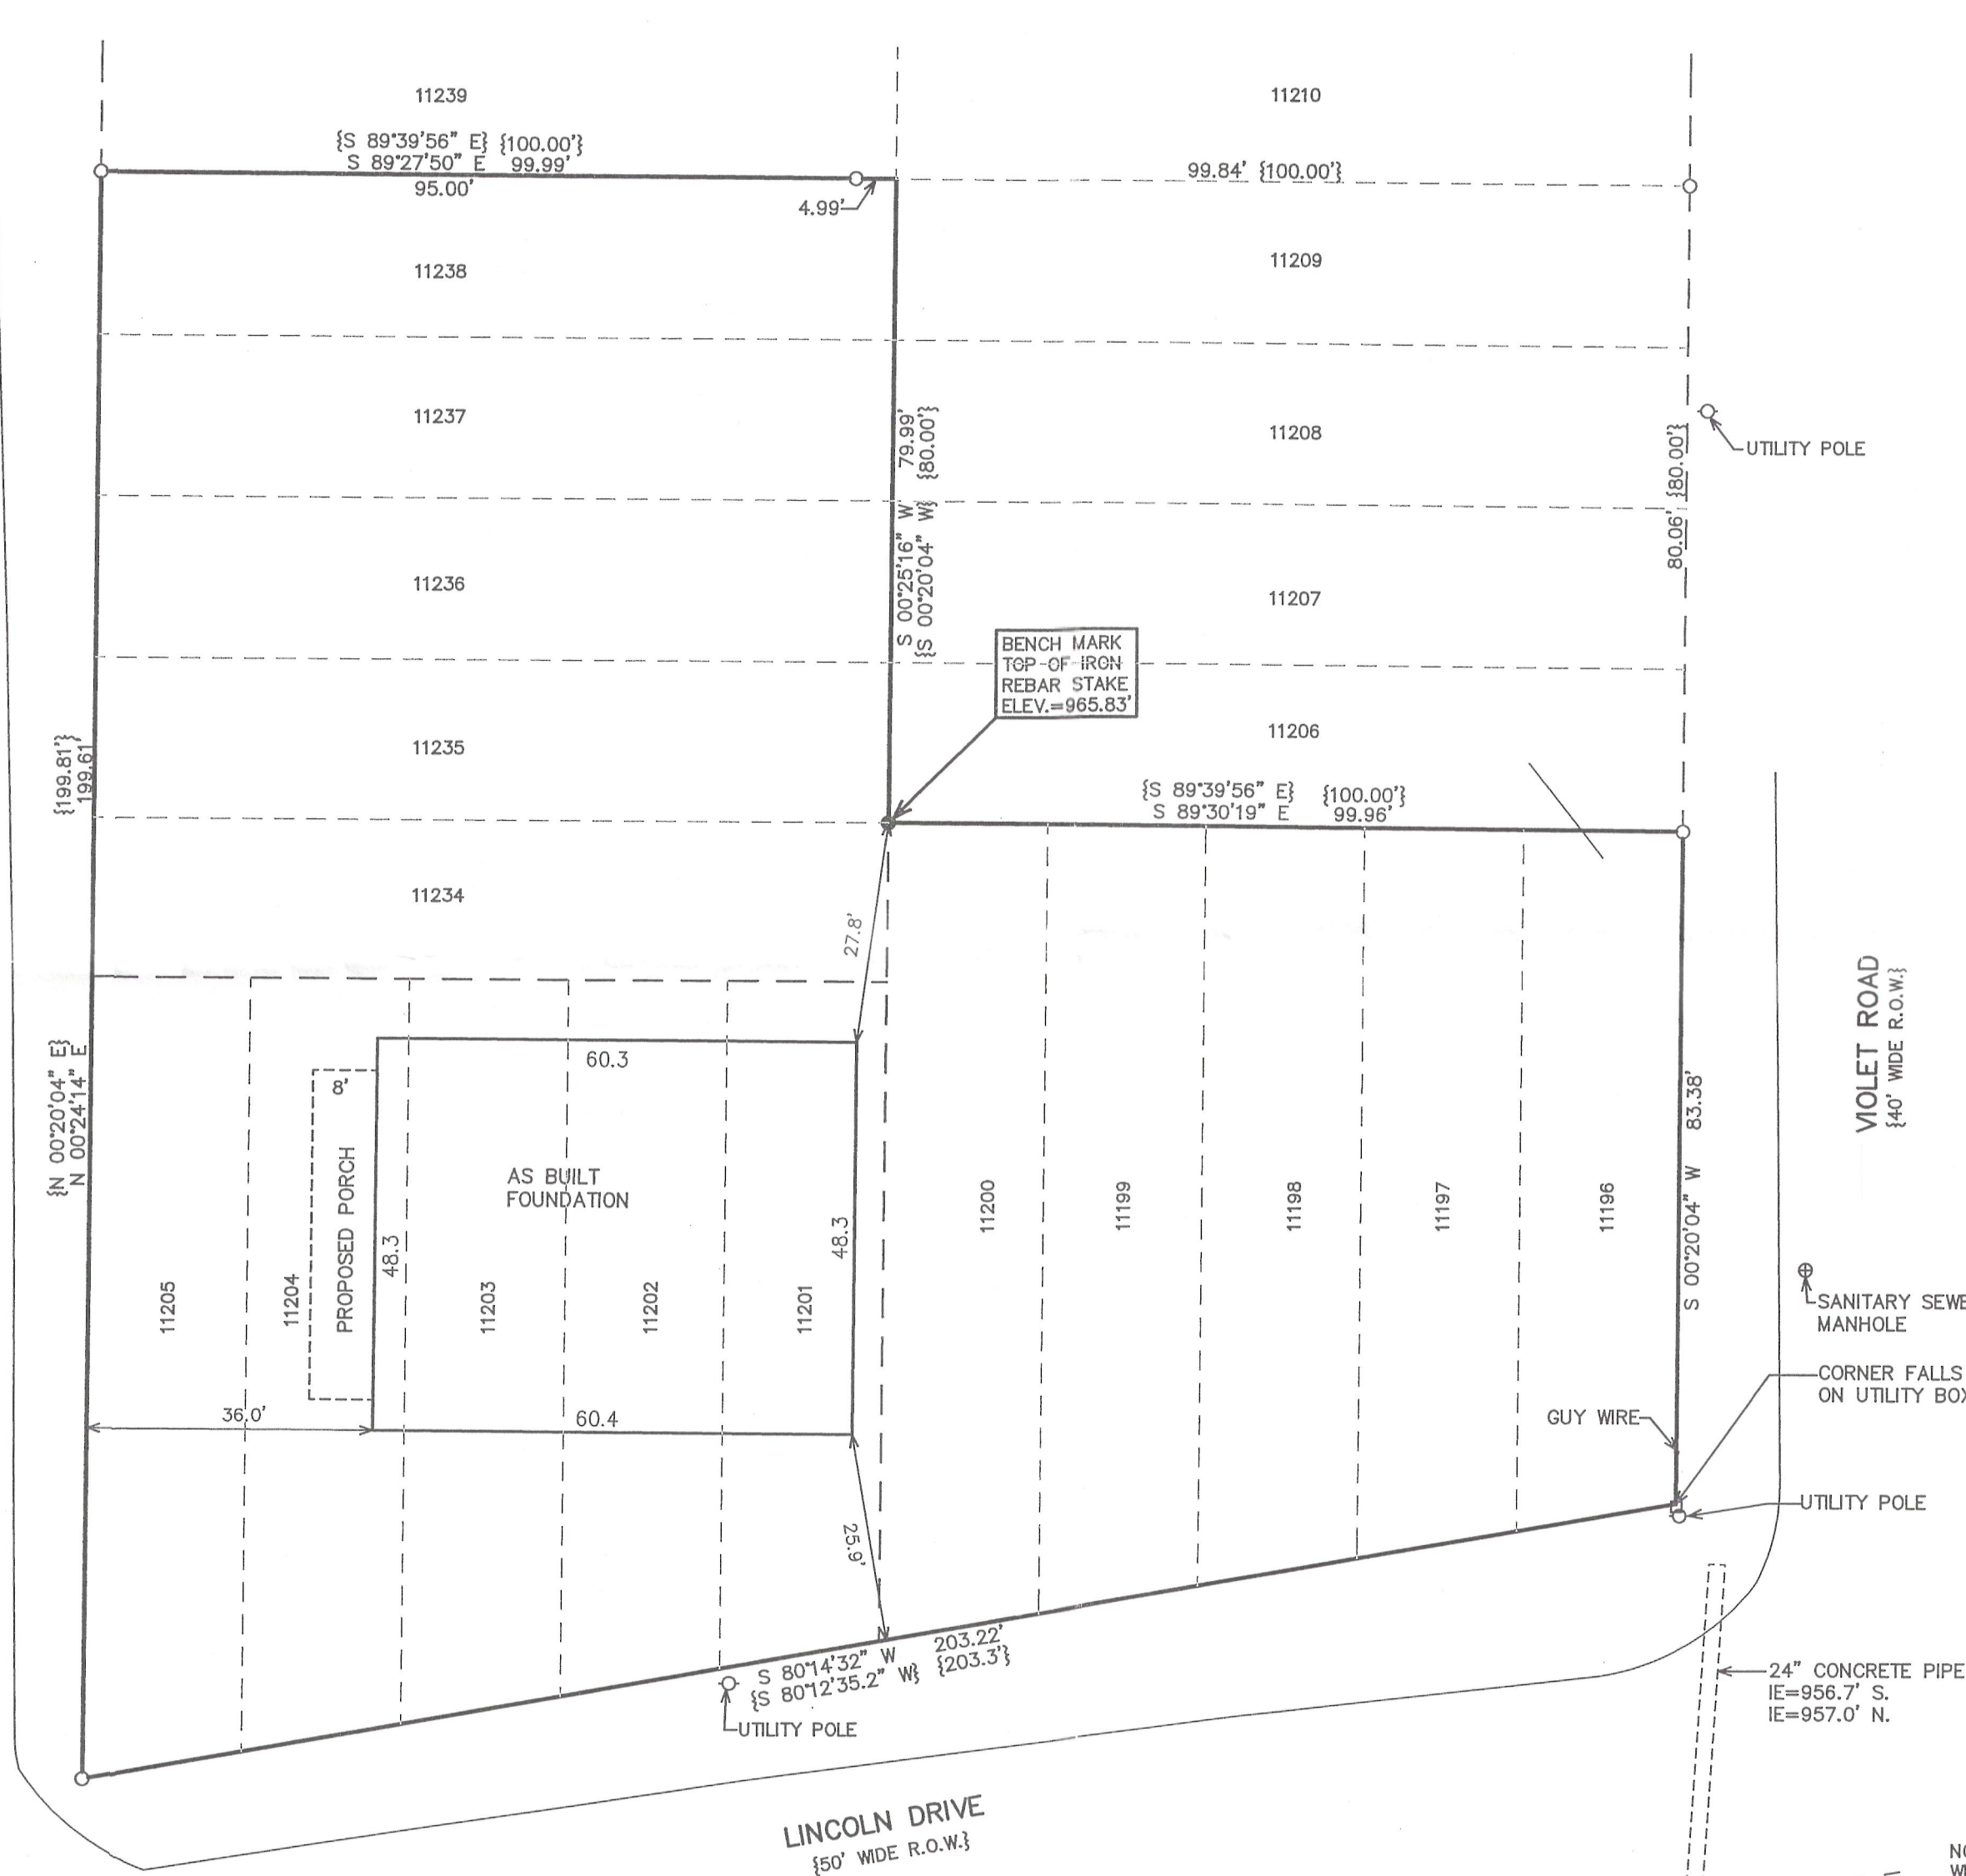

LEGEND
○ = IRON PIPE STAKE FOUND
● = IRON REBAR STAKE FOUND
{XXX} = RECORDED AS
TOTAL LAND AREA=28,292 S.F. (0.65 ACRES)




NOTE: COPIES OF THIS MAP TO WHICH THE FOLLOWING CERTIFICATE WILL APPLY SHOW THE SURVEYOR'S ORIGINAL SEAL AND SIGNATURE IN RED INK. COPIES BY ANY OTHER MEANS MAY HAVE ALTERATIONS WHICH DO NOT REPRESENT THE SURVEYOR'S WORK PRODUCT.

I HEREBY CERTIFY THAT THE ABOVE DESCRIBED PROPERTY HAS BEEN SURVEYED UNDER MY DIRECTION AND THAT THE ABOVE MAP IS A TRUE REPRESENTATION THEREOF AND SHOWS THE SIZE AND LOCATION OF THE PROPERTY AND ITS EXTERIOR BOUNDARIES. THIS SURVEY IS MADE FOR THE USE OF THE PRESENT OWNERS OF THE PROPERTY, AND ALSO THOSE WHO PURCHASE, MORTGAGE, OR GUARANTEE THE TITLE THERETO WITHIN ONE YEAR FROM THE DATE HEREOF.

DATED: OCTOBER 1, 2012
REVISED 11-20-2012
TO SHOW SIZE & LOCATION OF AS BUILT FOUNDATION

PETER S. GORDON R.L.S. 2101

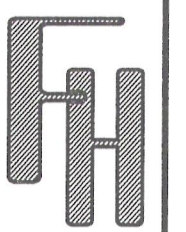


WORK ORDERED BY -
TIMOTHY KELLY
1250 ST. CLAIRE PLACE
SCHAUMBURG, IL 60173

FARRIS, HANSEN & ASSOCIATES, INC.
ENGINEERING - ARCHITECTURE - SURVEYING
7 RIDGWAY COURT P.O. BOX 437
ELKHORN, WISCONSIN 53121
OFFICE: (262) 723-2098 FAX: (262) 723-5886

REVISIONS

PROJECT NO.
8664
DATE:
10/1/2012
SHEET NO.
1 OF 1

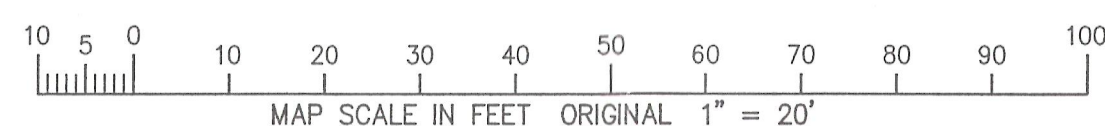

JLCB 2445

217.3837