

PLAT OF SURVEY

OF

Lots 6791, 6792, 6793, 6794 of Lake Como Beach, Walworth County, Wisconsin
SEC. 28, T. 2N., R. 17E.


Woodland Drive

FOUND
2" IRON PIPE

FOUND
2" IRON PIPE

Mistle Road

Larch Rd.

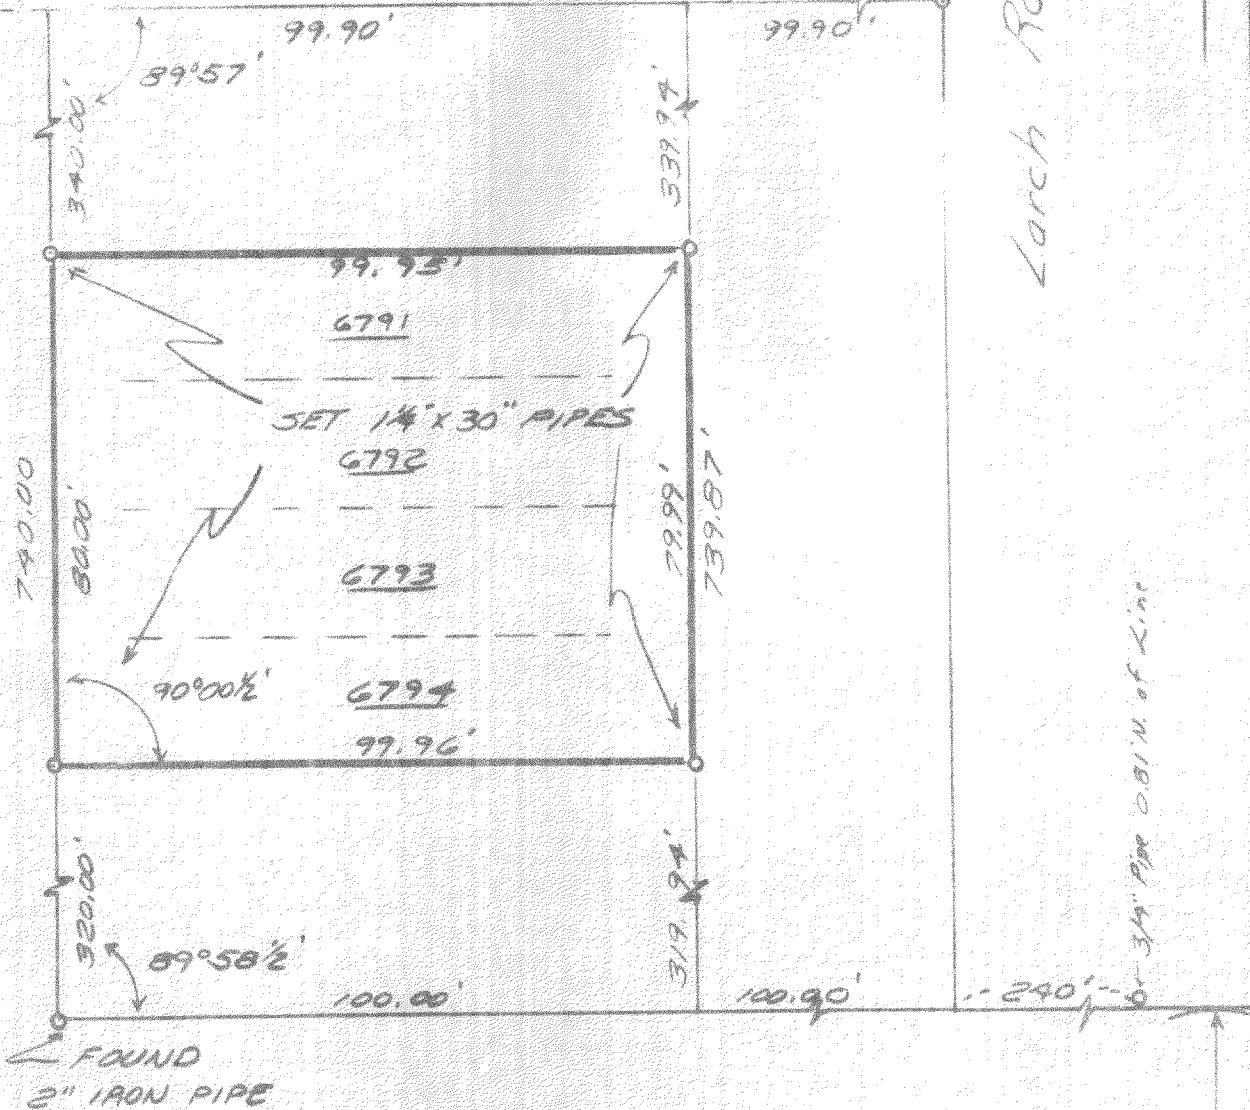


FOUND
2" IRON PIPE

Lincoln Drive

LEGEND

- — Iron Pipe
 - — Concrete Monument
- Scale 1" = 30'

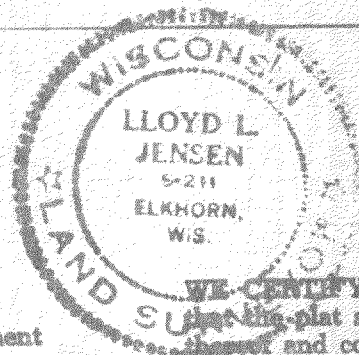

SURVEY AND PLAT BY
JENSEN & JOHNSON, INC.
CIVIL ENGINEERS AND SURVEYORS
Elkhorn, Wisconsin

S.E. COR.
Mile E Lincoln
2" IRON PIPE
FOUND

WE CERTIFY: That we have surveyed the above described property and that the plat shown hereon is an accurate survey and a true representation thereof and correctly shows the exterior boundary lines and all divisions of said property.

Date 15 JUNE 1973

Lloyd L. Jensen
LLOYD L. JENSEN,

Wisconsin Registered Land Surveyor, No. S-211

JLLB-1425

217-384