



CONDO PLAT BEARING BASIS

PLAT OF SURVEY

UNIT 56-07
GENEVA NATIONAL CONDOMINIUM
NO. 56
LOCATED IN TOWN 2 NORTH, RANGE 17 EAST
WALWORTH COUNTY, WISCONSIN

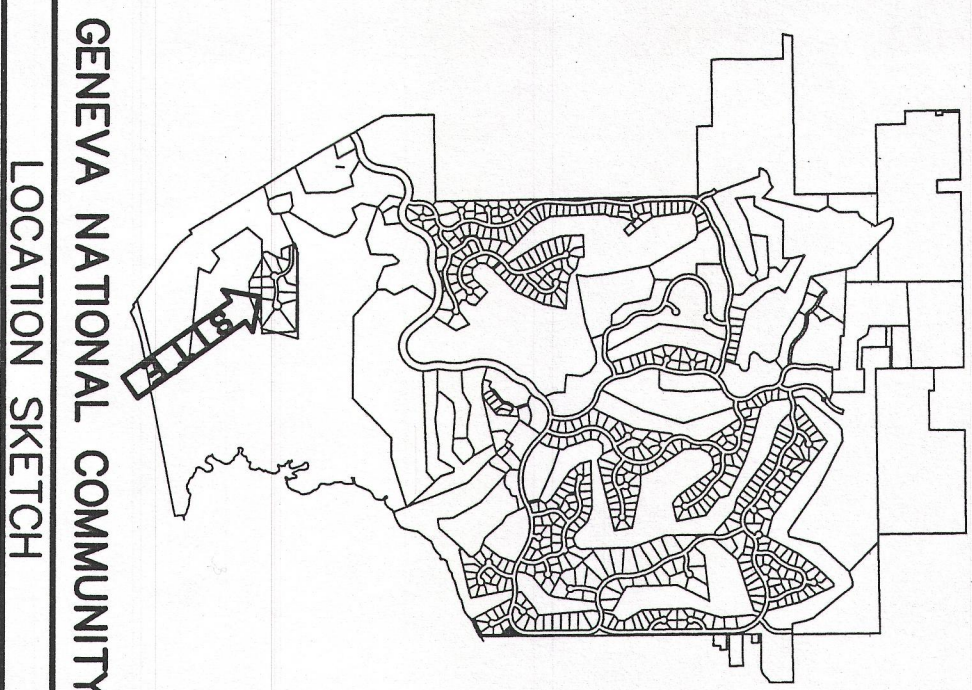


GENEVA NATIONAL COMMUNITY
LOCATION SKETCH

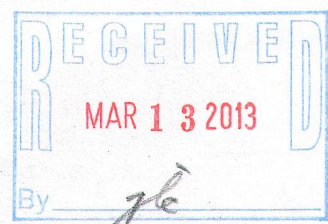

12/7/2012 X:\Projects\3269\CONDO_56\INDVLOTS\Unit_07\Dead\SURVEY

GEN 5600007

217-3850

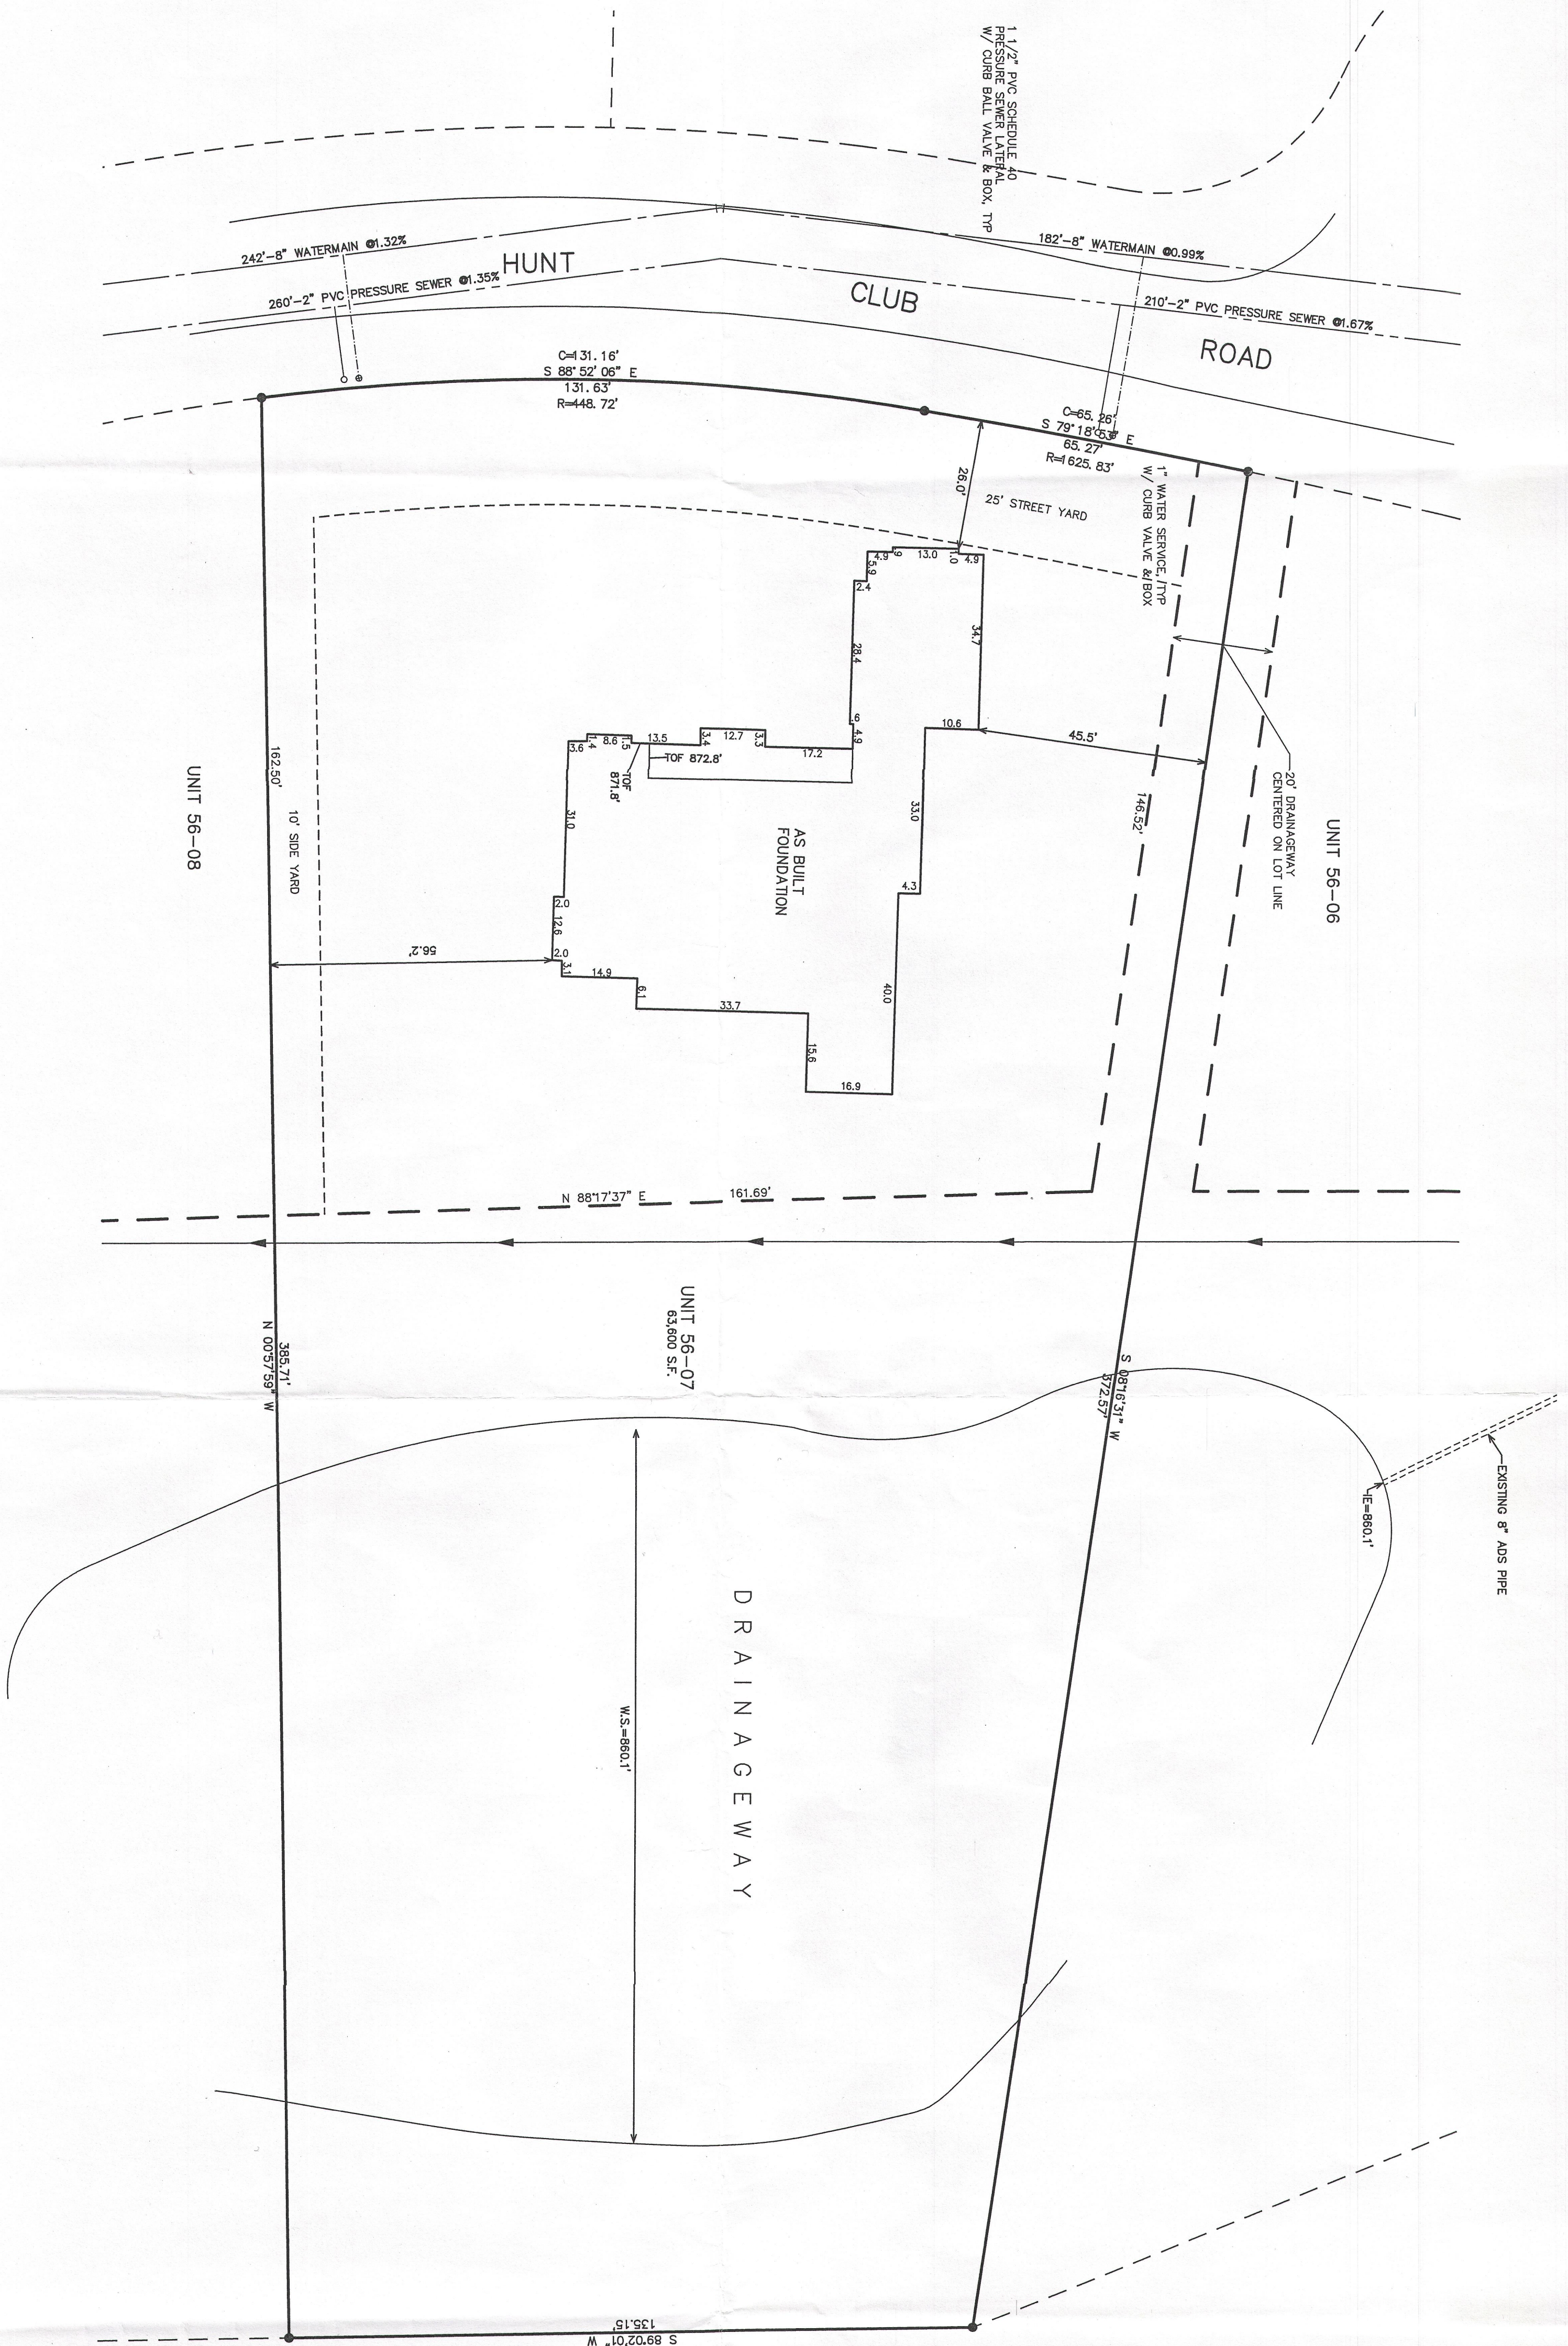

NOTE: COPIES OF THIS MAP TO WHICH THE FOLLOWING CERTIFICATE WILL APPLY SHOW THE SURVEYOR'S ORIGINAL SEAL AND SIGNATURE IN RED INK. COPIES BY ANY OTHER MEANS ARE NOT VALID. ANY ALTERATIONS WHICH DO NOT REPRESENT THE SURVEYOR'S WORK ARE NOT VALID.

I HEREBY CERTIFY THAT THE ABOVE DESCRIBED PROPERTY HAS BEEN SURVEYED UNDER MY PERSONAL SUPERVISION AND THAT THE ABOVE MAP IS A TRUE AND CORRECT REPRESENTATION OF THE SURVEY. I HAVE NOTED ANY ENCUMBRANCES, EASEMENTS, OR OTHER INTERESTS AFFECTING THE PROPERTY AND HAVE SHOWN THE SAME ON THIS MAP. I HAVE ALSO NOTED ANY DISCREPANCIES BETWEEN THE FIELD MEASUREMENTS AND THE RECORD PLAT AND HAVE SHOWN THE SAME ON THIS MAP. I HAVE ALSO NOTED ANY DISCREPANCIES BETWEEN THE FIELD MEASUREMENTS AND THE RECORD PLAT AND HAVE SHOWN THE SAME ON THIS MAP. I HAVE ALSO NOTED ANY DISCREPANCIES BETWEEN THE FIELD MEASUREMENTS AND THE RECORD PLAT AND HAVE SHOWN THE SAME ON THIS MAP.

DATE: OCTOBER 17, 2012
TO SHOW SIZE & LOCATION OF
AS BUILT FOUNDATION

PETER S. GORDON

FARRIS, HANSEN & ASSOCIATES, INC.
ENGINEERING - ARCHITECTURE - SURVEYING
7 RIDGWAY COURT P.O. BOX 437
ELKHORN, WISCONSIN 53121
OFFICE: (262) 723-2098 FAX: (262) 723-5886

WORK ORDERED BY
LOWELL MANAGEMENT, INC.
P.O. BOX 926 GENEVA NATIONAL
LAKE GENEVA, WI 53147

PROJECT NO.
3269-56-07
DATE
10/3/2012
SHEET NO.
1 OF 1