

FARRIS, HANSEN & ASSOCIATES, INC.
ENGINEERING - ARCHITECTURE - SURVEYING
7 RIDGWAY COURT - P.O. BOX 437 - ELKHORN, WISCONSIN 53121
PHONE: (262) 723-2098 FAX: (262) 723-5886




PLAT OF SURVEY

Lots 11800, 11801, 11802, 11803, 11804, 11805 and 11806, inclusive as designated and delineated on the Map entitled "Fifth Map of Lake Como Beach, Walworth County, Wisconsin" and recorded in the office of the Register of Deeds for the County of Walworth and the State of Wisconsin on the 1st day of May, 1926.

Tax Key No. JICB 02567

LEGAL DESCRIPTION FROM CHICAGO TITLE INSURANCE COMPANY COMMITMENT NUMBER Wd-16,987 DATED 9/20/1979, PROVIDED BY CLIENT

WORK ORDERED BY -
JOHN BOULAHANIS
6N 162 ACACIA LANE
MEDINAH, IL 60157

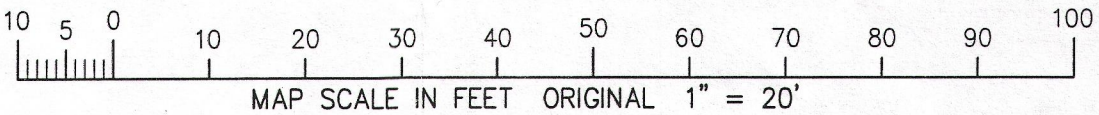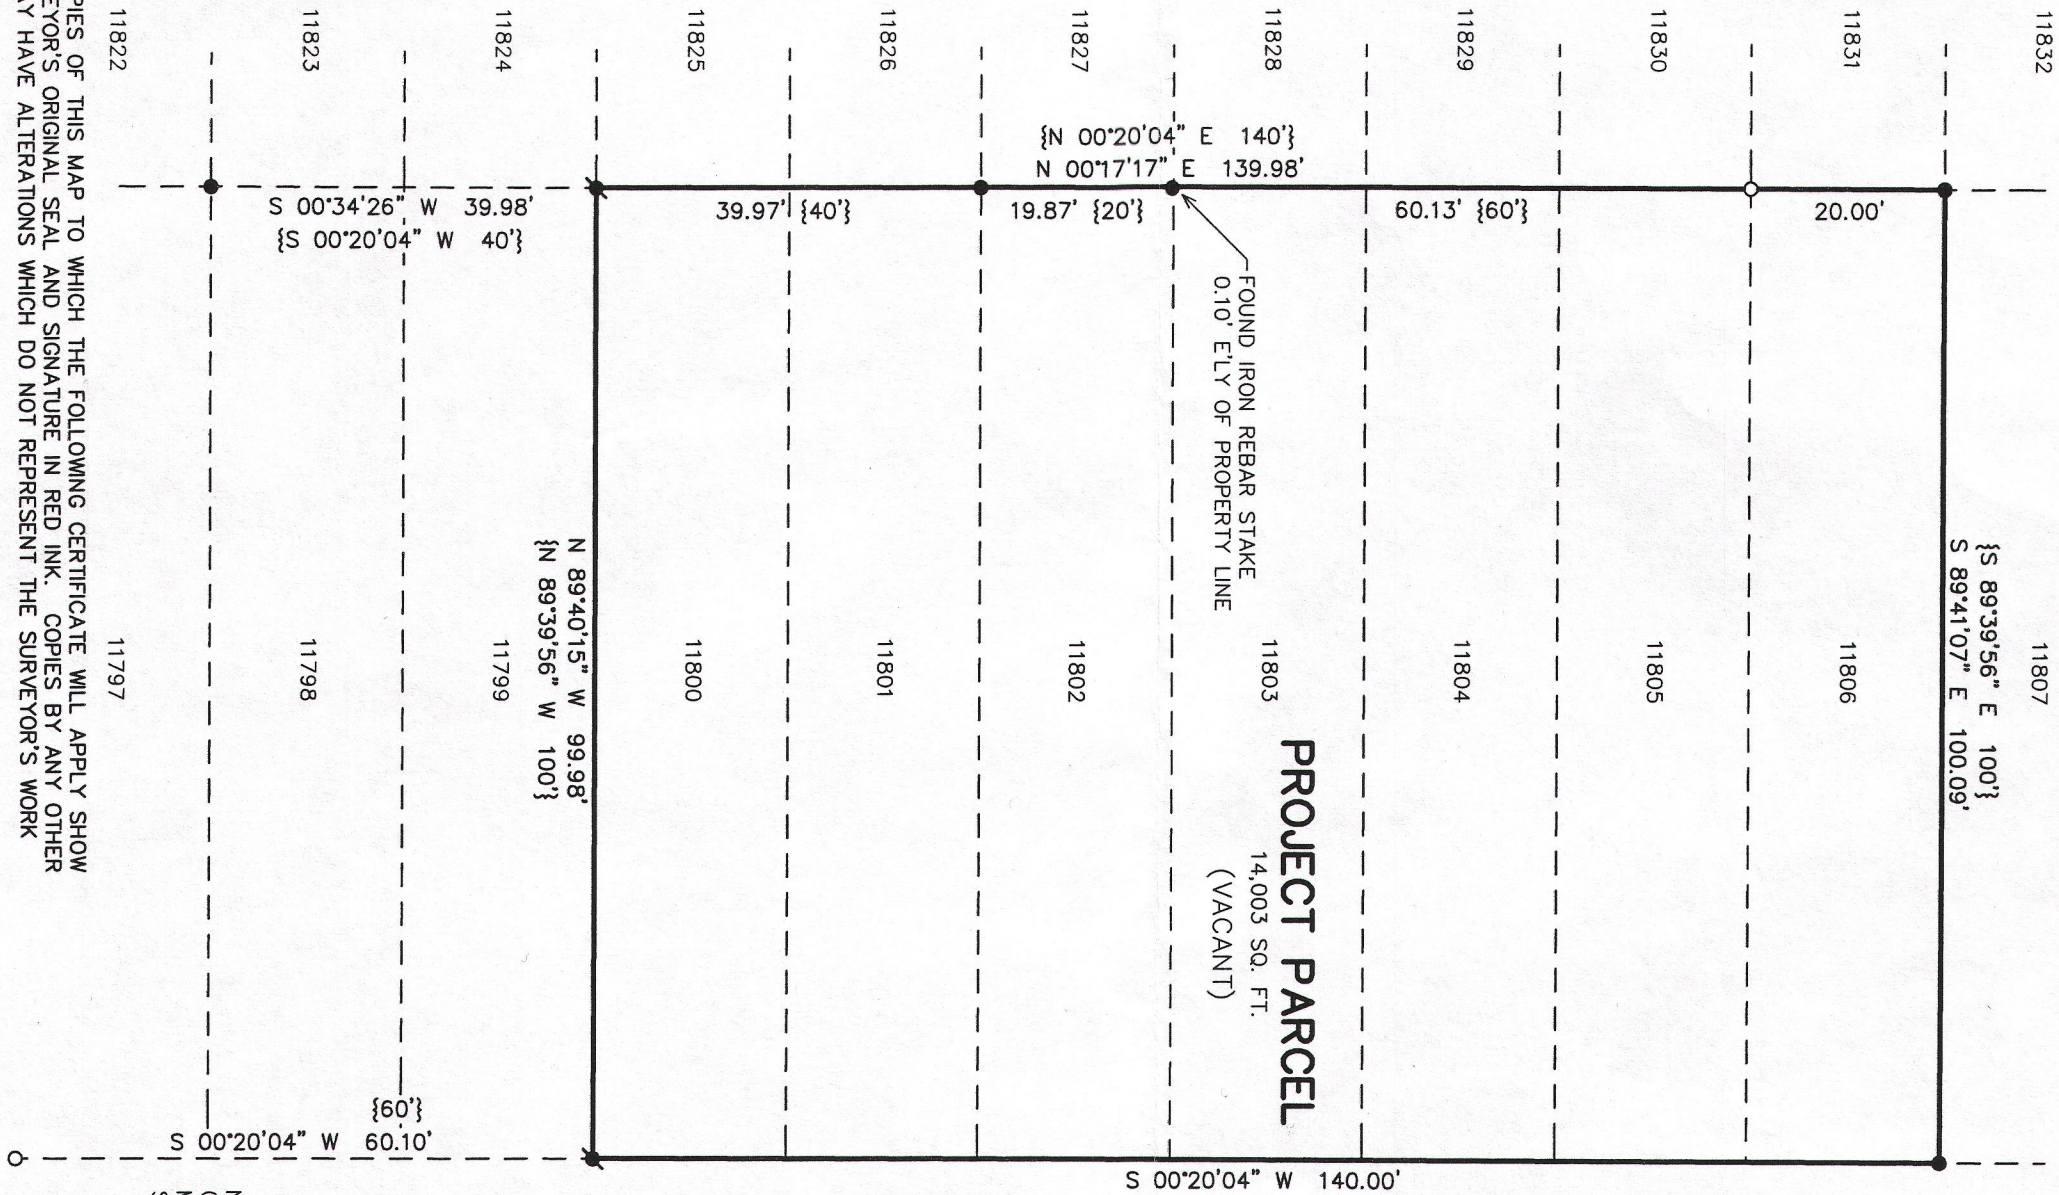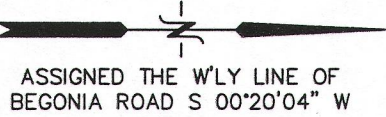


LEGEND

- = FOUND IRON PIPE STAKE
- = FOUND IRON REBAR STAKE
- = SET IRON REBAR STAKE
- {XXX} = RECORDED AS

NOTE:
GAS EASEMENT REC. AS DOC. 475581 ALLOWS FOR GAS MAINS WITHIN THE ROADS AND DOES NOT AFFECT THE SUBJECT PARCEL.

NOTE: COPIES OF THIS MAP TO WHICH THE FOLLOWING CERTIFICATE WILL APPLY SHOW THE SURVEYOR'S ORIGINAL SEAL AND SIGNATURE IN RED INK. COPIES BY ANY OTHER MEANS MAY HAVE ALTERATIONS WHICH DO NOT REPRESENT THE SURVEYOR'S WORK PRODUCT.

I HEREBY CERTIFY THAT THE ABOVE DESCRIBED PROPERTY HAS BEEN SURVEYED UNDER MY DIRECTION AND THAT THE ABOVE MAP IS A TRUE REPRESENTATION THEREOF AND SHOWS THE SIZE AND LOCATION OF THE PROPERTY, ITS EXTERIOR BOUNDARIES, THE LOCATION OF ALL VISIBLE STRUCTURES, AND DIMENSIONS OF ALL PRINCIPLE BUILDINGS THEREON, BOUNDARY FENCES, APPARENT EASEMENTS, ROADWAYS, AND VISIBLE ENCROACHMENTS, IF ANY. THIS SURVEY IS MADE FOR THE USE OF THE PRESENT OWNERS OF THE PROPERTY, AND ALSO THOSE WHO PURCHASE, MORTGAGE, OR GUARANTEE THE TITLE THERETO WITHIN ONE YEAR FROM THE DATE HEREOF.

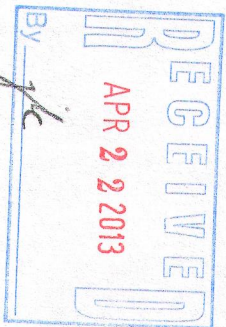

PROJECT: 8774
DATE: 04/11/2013
SHEET 1 OF 1

PETER S. GORDON
4/11/2013
DATED