


PLAT OF SURVEY
-OF-


LOTS 11433 THRU 11438, BLOCK 206 OF LAKE COMO BEACH FIFTH MAP, LOCATED IN SECTION 29, TOWN 2 NORTH, RANGE 17 EAST, IN THE TOWN OF GENEVA, WALWORTH COUNTY, WISCONSIN.

SURVEY FOR: LESZEK AND MAGDELINA BALLARIN
SURVEY LOCATION: N3121 WILLOW ROAD

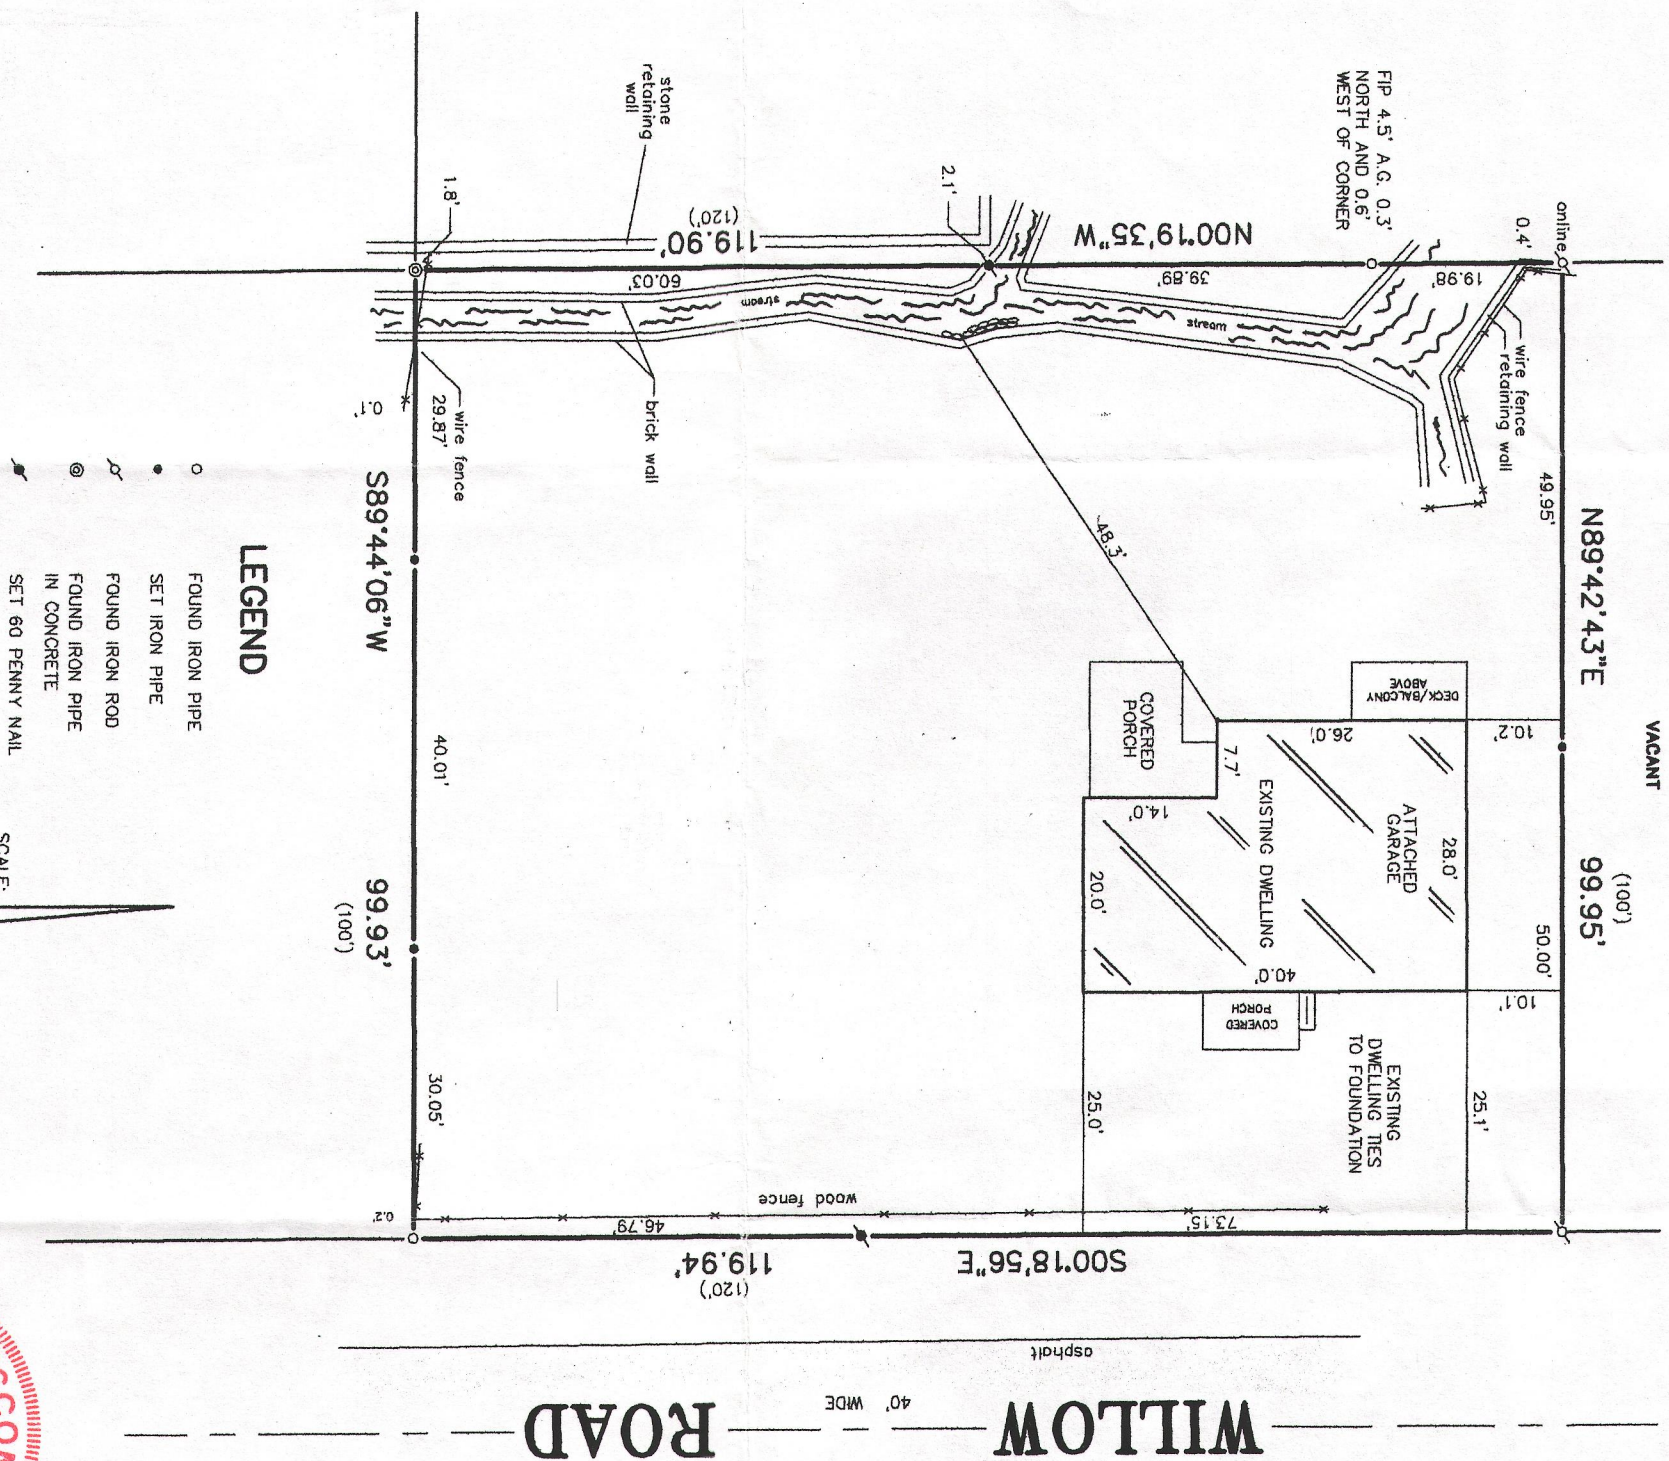


"I hereby certify that I have surveyed the above described property and that the above map is a correct representation thereof and shows the size and location of the property, its exterior boundaries, the location of all visible structures and dimensions of all principal buildings thereon, boundary fences, apparent easements, roadways and encroachments, if any."


"This survey is made for the use of the present owners of the property and those who purchase, mortgage, or guarantee the title thereto within one year from date hereof."

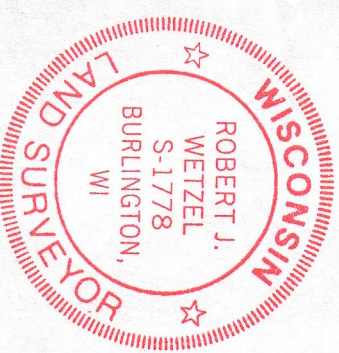

THIS IS NOT AN ORIGINAL PRINT
UNLESS THIS SEAL IS RED.

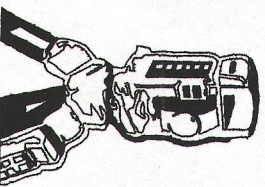

B.W. SURVEYING, INC.
LAND SURVEYS
MAPPING AND PLANNING
412 N. PINE STREET
BURLINGTON, WI 53105
(262)-767-0225

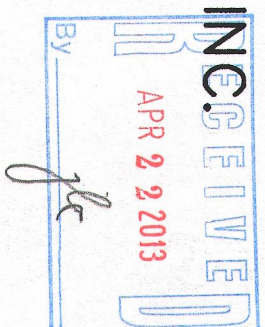

ROBERT J. WETZEL
JULY 24, 2012
DATE
8481A
JOB NUMBER

JLCB 02486

217-3855