

FARRIS, HANSEN & ASSOCIATES, INC.

ENGINEERING – ARCHITECTURE – SURVEYING

7 RIDGWAY COURT - P.O. BOX 437 - ELKHORN, WISCONSIN 53121

PHONE: (262) 723-2098 FAX: (262) 723-5886

PLAT OF SURVEY

LOTS 5 AND 6 OF BLOCK 2 OF PLAT OF
FRANK JANUTKAS LAKE VIEW SUBDIVISION.
LOCATED IN THE SW 1/4 OF THE NW 1/4 OF
SECTION 31, TOWN 2 NORTH, RANGE 17 EAST,
WALWORTH COUNTY, WISCONSIN; EXCEPTING
THEREFROM LANDS CONVEYED TO THE STATE OF
WISCONSIN ON DOCUMENT NO. 564907.

ASSIGNED SOUTH LINE WHITE OAK STREET
N 90°00'00" E

- WORK ORDERED BY -
SHIRLEY GRENON TRUST
C/O KEEFE REAL ESTATE
LAKE GENEVA, WI

STATE TRUNK HIGHWAY "67"

○ = FOUND IRON PIPE STAKE
 ● = FOUND IRON REBAR STAKE
 △ = FOUND PK NAIL
 (XXX) = RECORDED AS

AREA = 21,000 S.F. 0.48 AC.

NOTE: COPIES OF THIS MAP TO WHICH THE FOLLOWING CERTIFICATE WILL APPLY SHOW THE SURVEYOR'S ORIGINAL SEAL AND SIGNATURE IN RED INK. COPIES BY ANY OTHER MEANS MAY HAVE ALTERATIONS WHICH DO NOT REPRESENT THE SURVEYOR'S WORK PRODUCT


I HEREBY CERTIFY THAT THE ABOVE DESCRIBED PROPERTY HAS BEEN SURVEYED UNDER MY DIRECTION AND THAT THE ABOVE MAP IS A TRUE REPRESENTATION THEREOF AND SHOWS THE SIZE AND LOCATION OF THE PROPERTY, ITS EXTERIOR BOUNDARIES, THE LOCATION OF ALL VISIBLE STRUCTURES, AND DIMENSIONS OF ALL PRINCIPLE BUILDINGS THEREON, BOUNDARY FENCES, APPARENT EASEMENTS, ROADWAYS, AND VISIBLE ENCROACHMENTS, IF ANY. THIS SURVEY IS MADE FOR THE USE OF THE PRESENT OWNERS OF THE PROPERTY, AND ALSO THOSE WHO PURCHASE, MORTGAGE, OR GUARANTEE THE TITLE THERETO WITHIN ONE YEAR FROM THE DATE HEREOF.

DATED: MAY 1, 2013

OM THE DATE HEREUP.

PETER S. GORDON

PETER S. GORDON

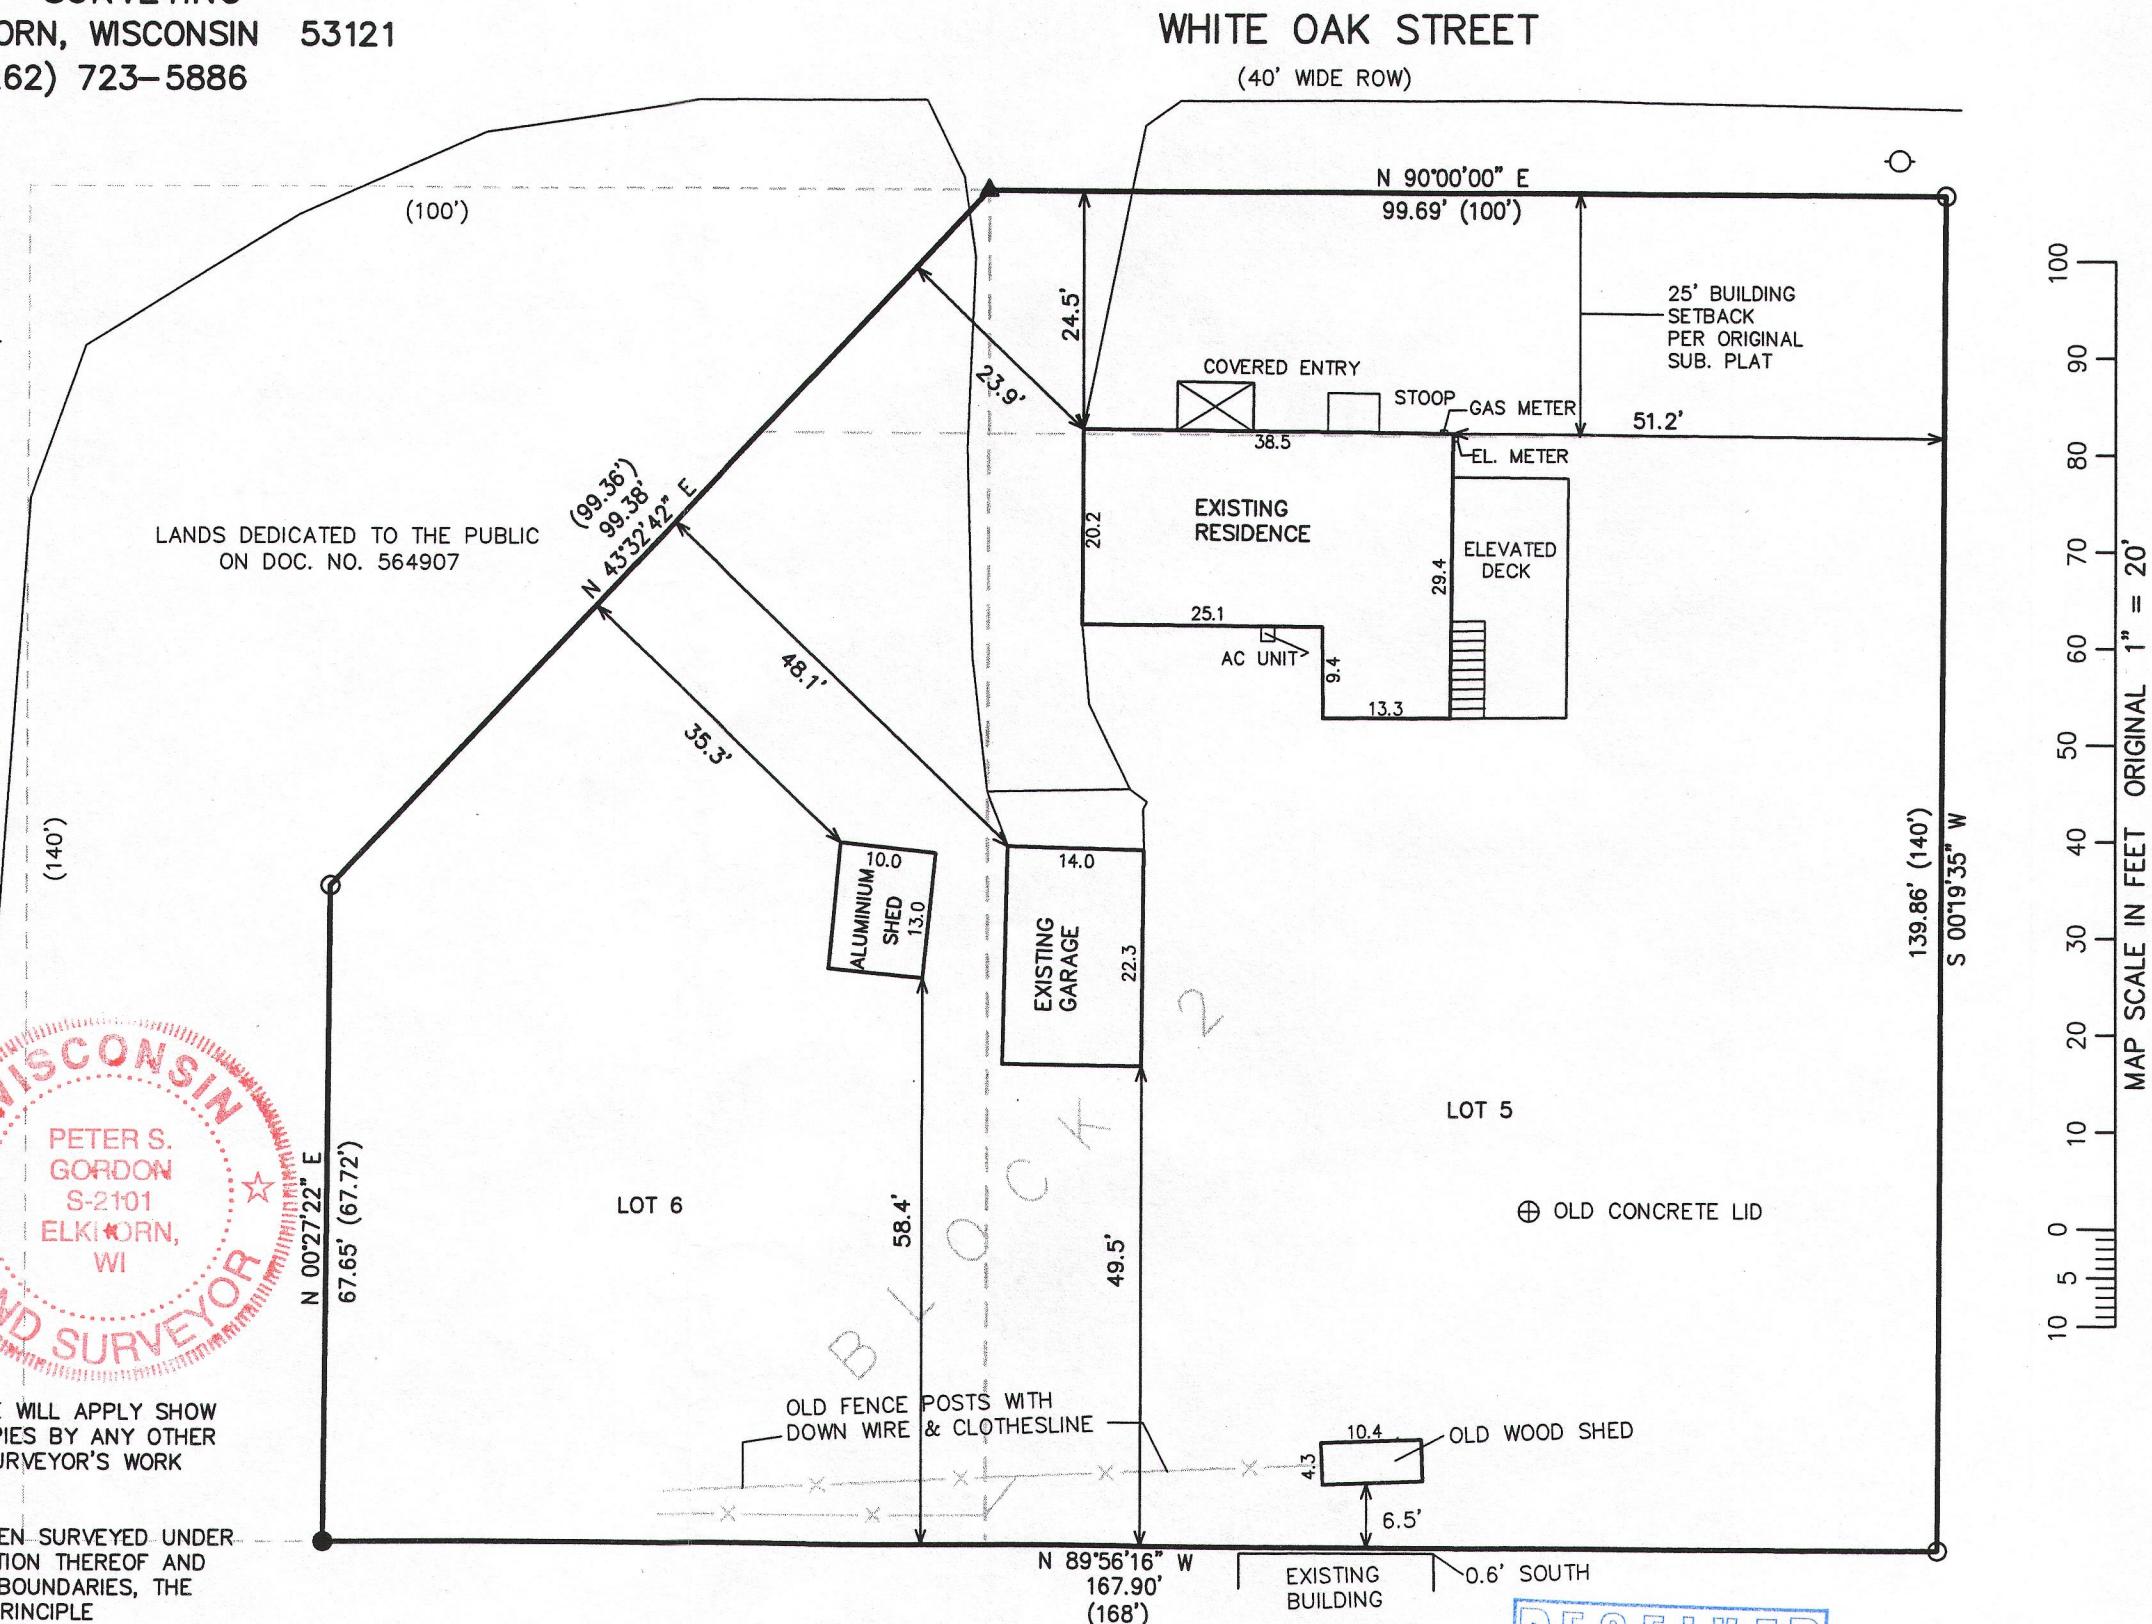

PROJECT: 8785
DATE: 05-01-2013
SHEET 1 OF 1