

PREPARED FOR:
JOSHUA SMITH
N3145 SATINWOOD RD.
LAKE GENEVA, WI 53147

PLAT OF SURVEY

-OF-

LOTS 10123-10132, BLOCK 184 LAKE COMO BEACH SUBDIVISION, LOCATED IN
TOWN 2 NORTH, RANGE 17 EAST, WALWORTH COUNTY, WISCONSIN.

KROTT SURVEYING INC.
N3705 WILLOW BEND LANE
LAKE GENEVA WI. 53147
PHONE # (262)248-3697
FAX # (262)249-0639

C.L. LONGFELLOW DRIVE

(40' WIDE)

C.L. TAMARACK ROAD

(40' WIDE)

C.L. SATINWOOD ROAD

(40' WIDE)

LEGEND
() = RECORDED AS
□ = FOUND IRON BAR
○ = FOUND IRON PIPE
● = SET IRON PIPE
■ = SET IRON BAR
SCALE: 1" = 20'

JOB #: 07-287UD2013


TAX ID #: JLCB02187

NOTE: BASIS OF BEARING IS RECORD
PLAT OF LAKE COMO BEACH SUBDIVISION.

I have surveyed the above-described property and the above map is
a true representation thereof and shows the size and location of the
property, its exterior boundaries, the location and dimensions of all
structures thereon, fences apparent easements and roadways and
visible encroachments. if any.

This survey is made for the exclusive use of the present owners of
the property, and also those who purchase, mortgage, or insure the
title thereto within one (1) year from date hereof; and as to them I
warrant the accuracy of said survey map.


200.04'
FOUND IRON PIPE ONLINE &
0.48' EAST OF CORNER

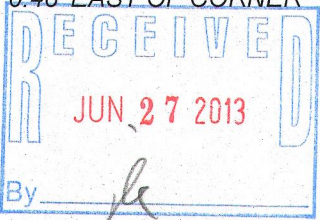

DATED THIS 24th, DAY OF APRIL, 2013

John P. Krott

JOHN KROTT S - 2258
Wisconsin Registered Land Surveyor
(original if signed in red)

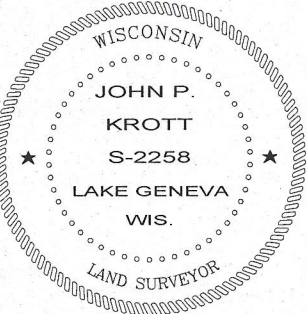

217-2869