


PREPARED FOR
DIANE COCROFT
KEEFE REAL ESTATE
751 GENEVA PARKWAY
LAKE GENEVA WI. 53147

PLAT OF SURVEY OF

LOTS 5998 THRU 6002 BLOCK 105 OF LAKE COMO BEACH
SUBDIVISION, LOCATED IN TOWN 2 NORTH, RANGE 17
EAST, WALWORTH COUNTY, WISCONSIN.

KROTT SURVEYING INC.
(262) 248-3697
N 3705 WILLOW BEND LANE
LAKE GENEVA WI. 53147

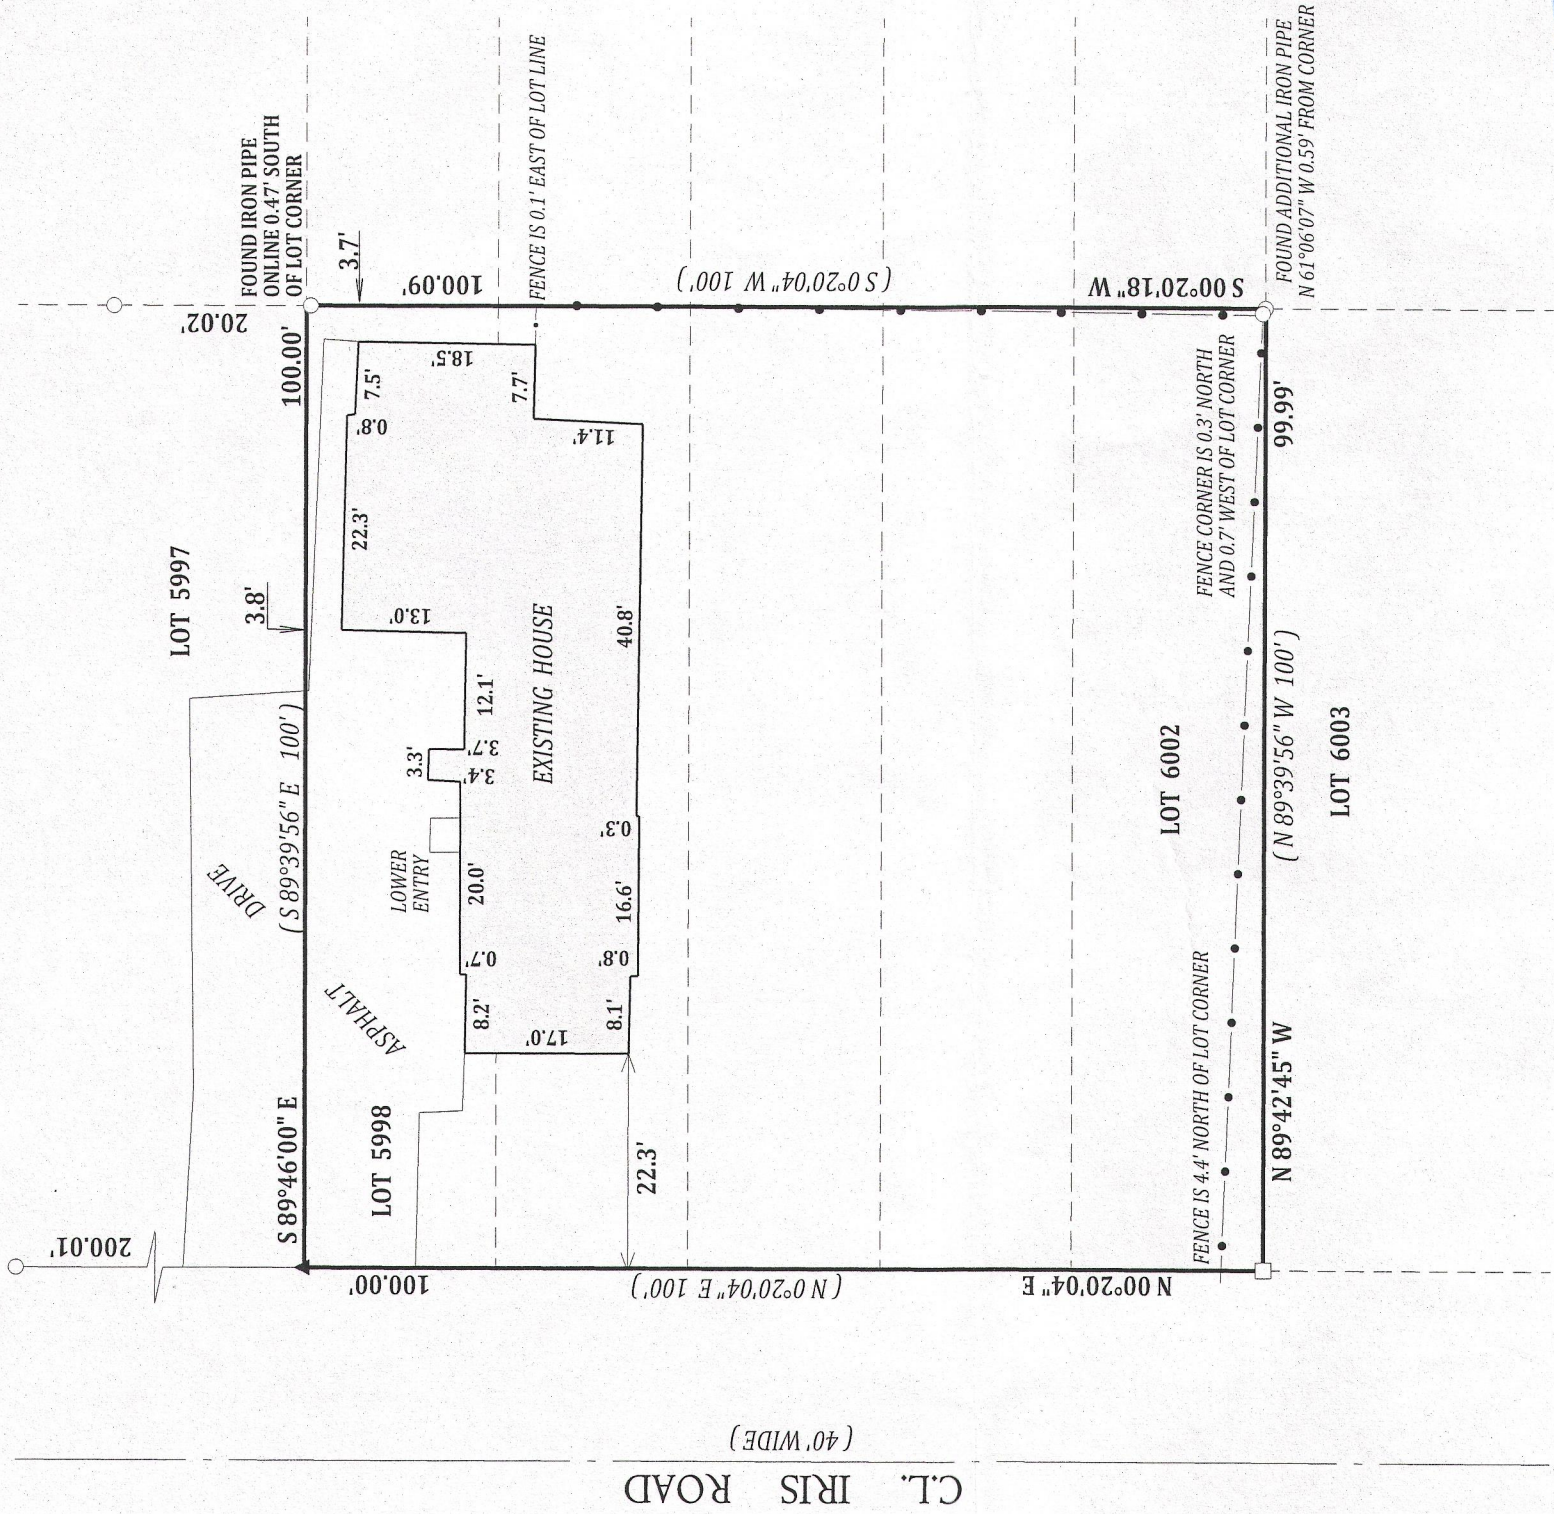


LEGEND

- FOUND IRON PIPE
- FOUND IRON BAR
- ▲ SET MAG NAIL
- CHAIN LINK FENCE

(XX) RECORDED AS

TAX ID # JLCB01233

JOB # 13-120

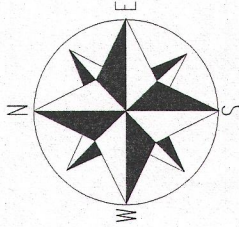

SCALE 1" = 20'

NOTE: BEARINGS ARE REFERENCED TO THE RECORD PLAT.




I have surveyed the above-described property and the above map is a true representation thereof and shows the size and location of the property, its exterior boundaries, the location and dimensions of all structures thereon, fences apparent easements and roadways and visible encroachments, if any.

This survey is made for the exclusive use of the present owners of the property, and also those who purchase, mortgage, or insure the title thereto within one (1) year from date hereof; and as to them I warrant the accuracy of said survey map.

DATED THIS 13th DAY OF AUGUST 2013

John P. Krott

JOHN P. KROTT S-2258
WISCONSIN REGISTERED LAND SURVEYOR
(NOTE: THIS IS NOT A CERTIFIED COPY
UNLESS SIGNED IN RED INK)

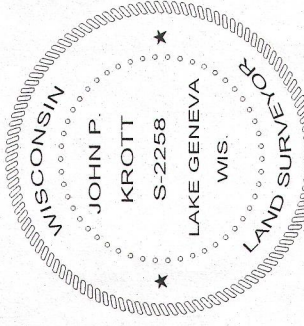

217-3908