



PREPARED FOR
MICHAEL DANIELS
CAGAN MANAGEMENT GROUP
3856 OAKTON ST.
SKOKIE, IL 60076

KROTT SURVEYING INC.
(262) 248-3897
N 3705 WILLOW BEND LANE
LAKE GENEVA WI 53147

LAKE COMO

PLAT OF SURVEY OF

LOTS 29 AND 30 OF CONSUMER'S COMPANY SUBDIVISION IN THE TOWN OF GENEVA ACCORDING TO THE PLAT THEREOF ON RECORD IN THE OFFICE OF THE REGISTER OF DEEDS IN AND FOR SAID WALWORTH COUNTY WISCONSIN.
ALSO, THAT PART OF THE VACATED COMO DRIVE ADJOINING AND BEING SOUTHERLY OF SAID LOTS 29 AND 30

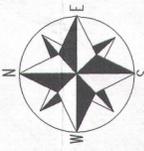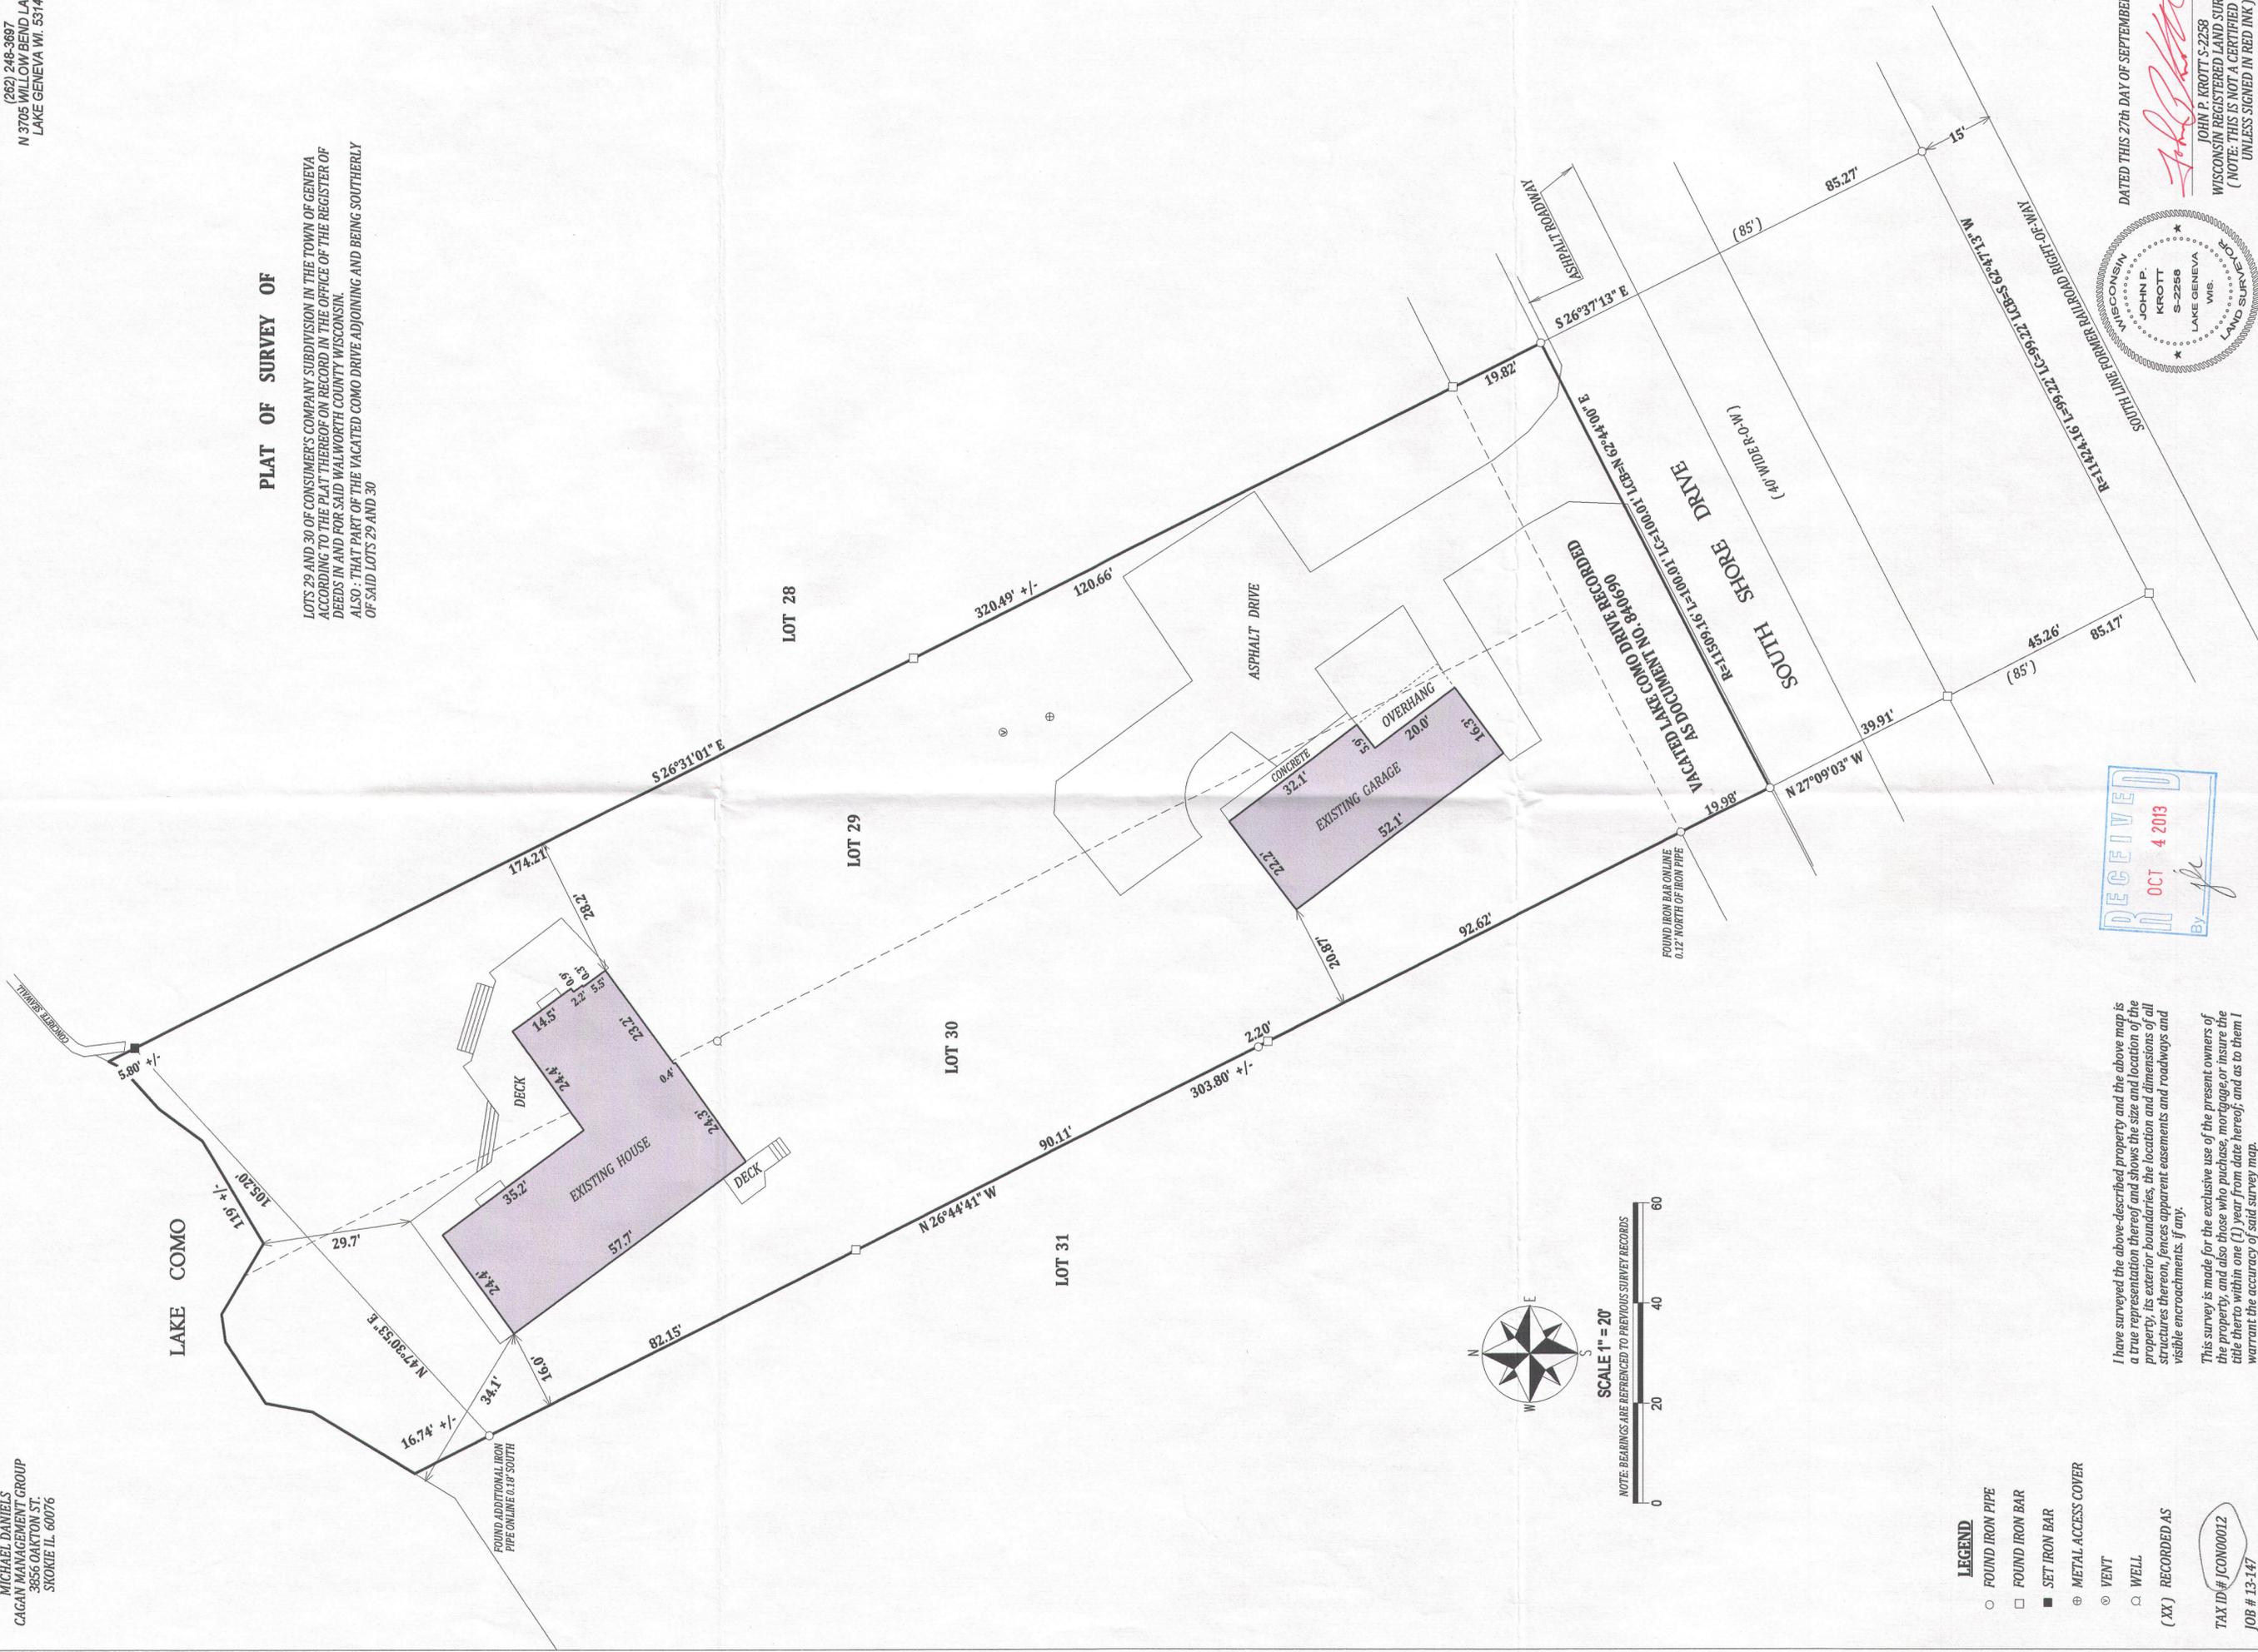


SCALE 1" = 20'
NOTE: BEARINGS ARE REFERENCED TO PREVIOUS SURVEY RECORDS

- LEGEND**
- FOUND IRON PIPE
 - FOUND IRON BAR
 - SET IRON BAR
 - ⊕ METAL ACCESS COVER
 - ⊙ VENT
 - WELL
 - (XX) RECORDED AS

RECEIVED
OCT 4 2013
By *[Signature]*

I have surveyed the above-described property and the above map is a true representation thereof and shows the size and location of the property, its exterior boundaries, the location and dimensions of all structures thereon, fences, apparent easements and roadways and visible encroachments, if any.
This survey is made for the exclusive use of the present owners of the property, and also those who purchase, mortgage or insure the title thereto within one (1) year from date hereof, and as to them I warrant the accuracy of said survey map.

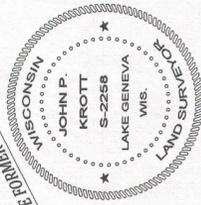

JOHN P. KROTT S-2258
WISCONSIN REGISTERED LAND SURVEYOR
(NOTE: THIS IS NOT A CERTIFIED COPY UNLESS SIGNED IN RED INK.)
DATED THIS 27th DAY OF SEPTEMBER 2013

TAX ID # ICON00012
JOB # 13-147

217-3909