


PREPARED FOR:
R&D BUILDERS
3116 ROYAL OAKS DR.
ELKHORN WI. 53121

PLAT OF SURVEY

-OF-

KROTT SURVEYING INC.
N3705 WILLOW BEND LANE
LAKE GENEVA WI. 53147
PHONE # (262)248-3697
FAX # (262)249-0639

LOTS 11945 THRU 11949, BLOCK 214 OF THE FIFTH MAP OF LAKE COMO BEACH
A SUBDIVISION, LOCATED IN TOWN 2 NORTH, RANGE 17 EAST, WAL WORTH
COUNTY, WISCONSIN.

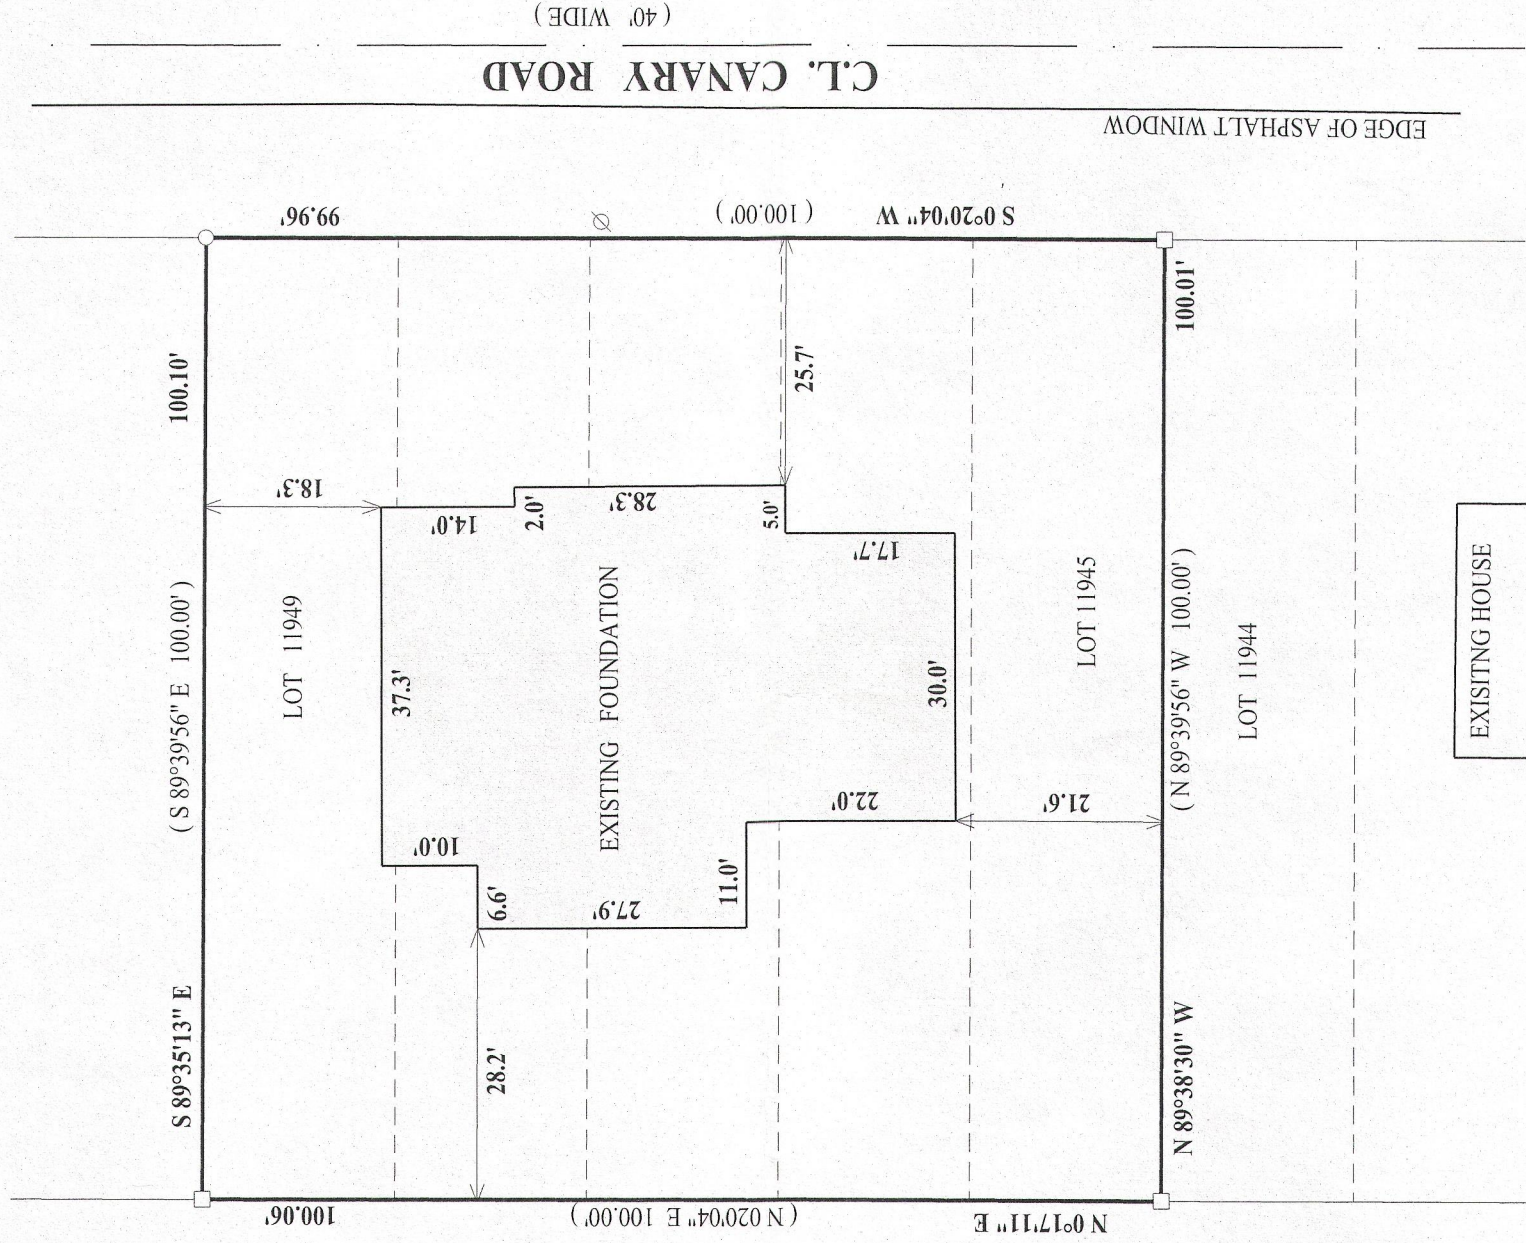


LEGEND

- FOUND IRON PIPE
- FOUND IRON BAR
- Ø UTILITY POLE
- (XX) RECORDED AS

TAX ID # JLCB025978

JOB # 12-078AB


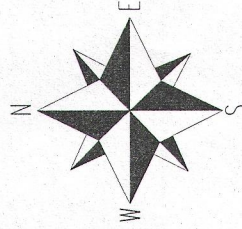


SCALE 1" = 20'

BEARINGS ARE REFERENCED TO THE
RECORDED PLAT OF LAKE COMO BEACH

I have surveyed the above-described property and the above map is a true representation thereof and shows the size and location of the property, its exterior boundaries, the location and dimensions of all structures thereon, fences apparent easements and roadways and visible encroachments, if any.

This survey is made for the exclusive use of the present owners of the property, and also those who purchase, mortgage or insure the title thereto within one (1) year from date hereof, and as to them I warrant the accuracy of said survey map.

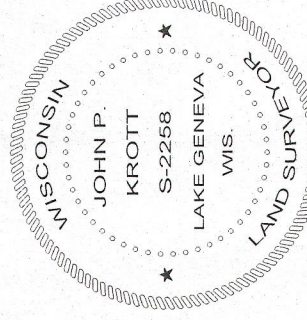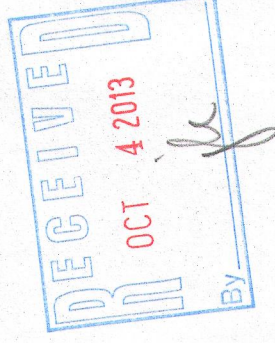

DATED THIS 26th, DAY OF JUNE, 2012
DATE OF LAST REVISION 07 / 09 / 2013
REVISED 3 / 14 / 2013

John P. Krott

JOHN KROTT S - 2258
Wisconsin Registered Land Surveyor
(original if signed in red)

JLCB 02598

217-3911