


LOTS 4061 THRU 4065 BLOCK 70 LAKE COMO BEACH
SUBDIVISION LOCATED IN TOWN 2 NORTH, RANGE 17
EAST. WALLWORTH COUNTY, WISCONSIN.


C.L. LAKEVIEW DRIVE

(50' WIDE) PLATTED AS LINCOLN DRIVE

EDGE OF ASPHALT ROADWAY

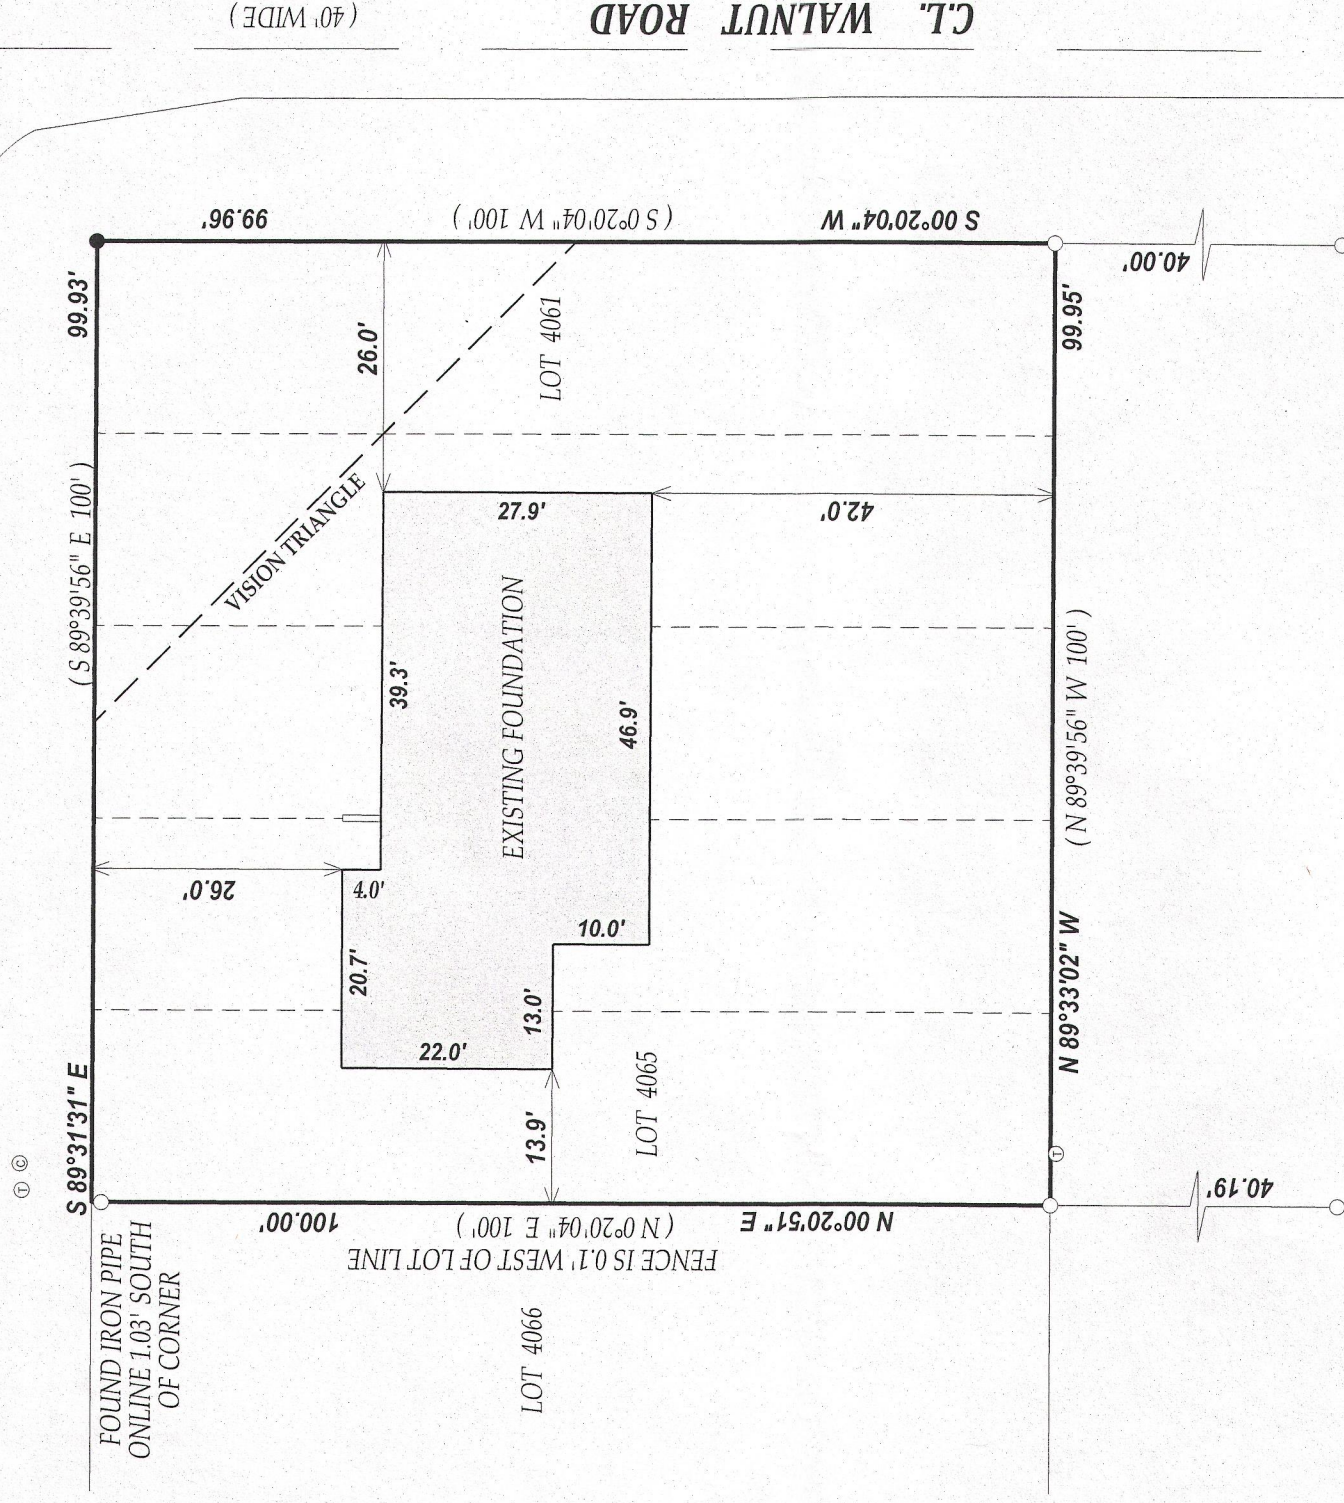

RECEIVED
OCT 4 2013

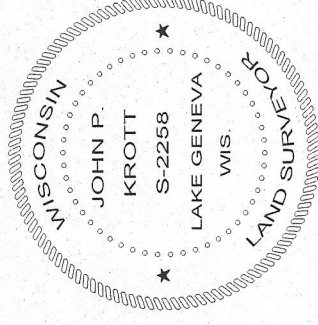

LEGEND

- FOUND IRON PIPE
- SET IRON PIPE
- ① TELEPHONE PEDESTAL
- ② CABLE PEDESTAL

I have surveyed the above-described property and the above map is a true representation thereof and shows the size and location of the property, its exterior boundaries, the location and dimensions of all structures thereon, fences apparent easements and roadways and visible encroachments, if any.

(XX) RECORDED AS

TAXID # JLCB00780

JOB # 13-084AB

This survey is made for the exclusive use of the present owners of the property, and also those who purchase, mortgage, or insure the title thereto within one (1) year from date hereof; and as to them I warrant the accuracy of said survey map.

DATE OF LAST REVISION: 9/13/2013

DATED THIS 17th DAY OF JUNE 2013

JOHN KROTT S - 2258
Wisconsin Registered Land Surveyor
(original if signed in red)

217-3912