


PREPARED FOR
TONY BOLLA
3654 N. MOZART
CHICAGO IL. 60618

KROTT SURVEYING INC.
(262) 248-3697
N 3705 WILLOW BEND LANE
LAKE GENEVA WI. 53147

C.L. SOUTHVIEW DRIVE
(40' WIDE)


PLAT OF SURVEY OF

LOTS 10, 11 AND 12 IN BLOCK 20 IN SUNSET HILLS "B" SUBDIVISION
SITUATED IN SECTION 33, TOWN 2 NORTH, RANGE 17 EAST, TOWN
OF GENEVA, WALWORTH COUNTY, WISCONSIN.

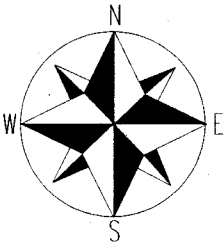

NOTE: BEARINGS ARE REFERENCED TO PREVIOUS SURVEY RECORDS.

SCALE 1" = 20'

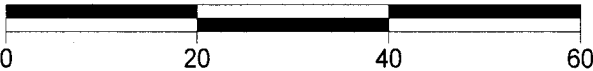


DATED THIS 29th DAY OF NOVEMBER 2013

John P. Krott

JOHN P. KROTT S-2258
WISCONSIN REGISTERED LAND SURVEYOR
(NOTE: THIS IS NOT A CERTIFIED COPY
UNLESS SIGNED IN RED INK)

I have surveyed the above-described property and the above map is
a true representation thereof and shows the size and location of the
property, its exterior boundaries, the location and dimensions of all
structures thereon, fences apparent easements and roadways and
visible encroachments, if any.

This survey is made for the exclusive use of the present owners of
the property, and also those who purchase, mortgage, or insure the
title thereto within one (1) year from date hereof; and as to them I
warrant the accuracy of said survey map.

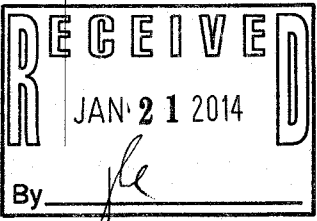

- LEGEND**
- FOUND IRON PIPE
 - SET IRON BAR
 - ⊕ METAL ACCESS COVER
 - WELL
 - ⊗ UTILITY POLE
 - E— OVER HEAD WIRES
 - (XX) RECORDED AS

TAX ID # JSH00126
JOB # 13-179

CENTRAL DRIVE
(40' WIDE)

