
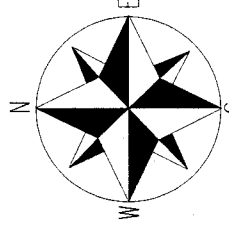
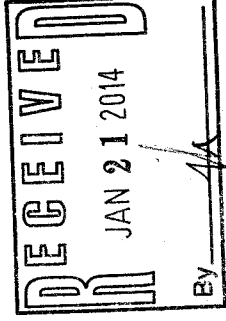


PREPARED FOR
BASSO BUILDERS
405 SKYLINE DR.
LAKE GENEVA WI. 53147

PLAT OF SURVEY OF

LOTS 10417 THROUGH 10422 OF THE 5th MAP OF LAKE COMO BEACH
SUBDIVISION IN THE TOWN OF GENEVA, WALWORTH COUNTY, WISCONSIN.

KROTT SURVEYING INC.
(262) 248-3697
N 3705 WILLOW BEND LANE
LAKE GENEVA WI. 53147

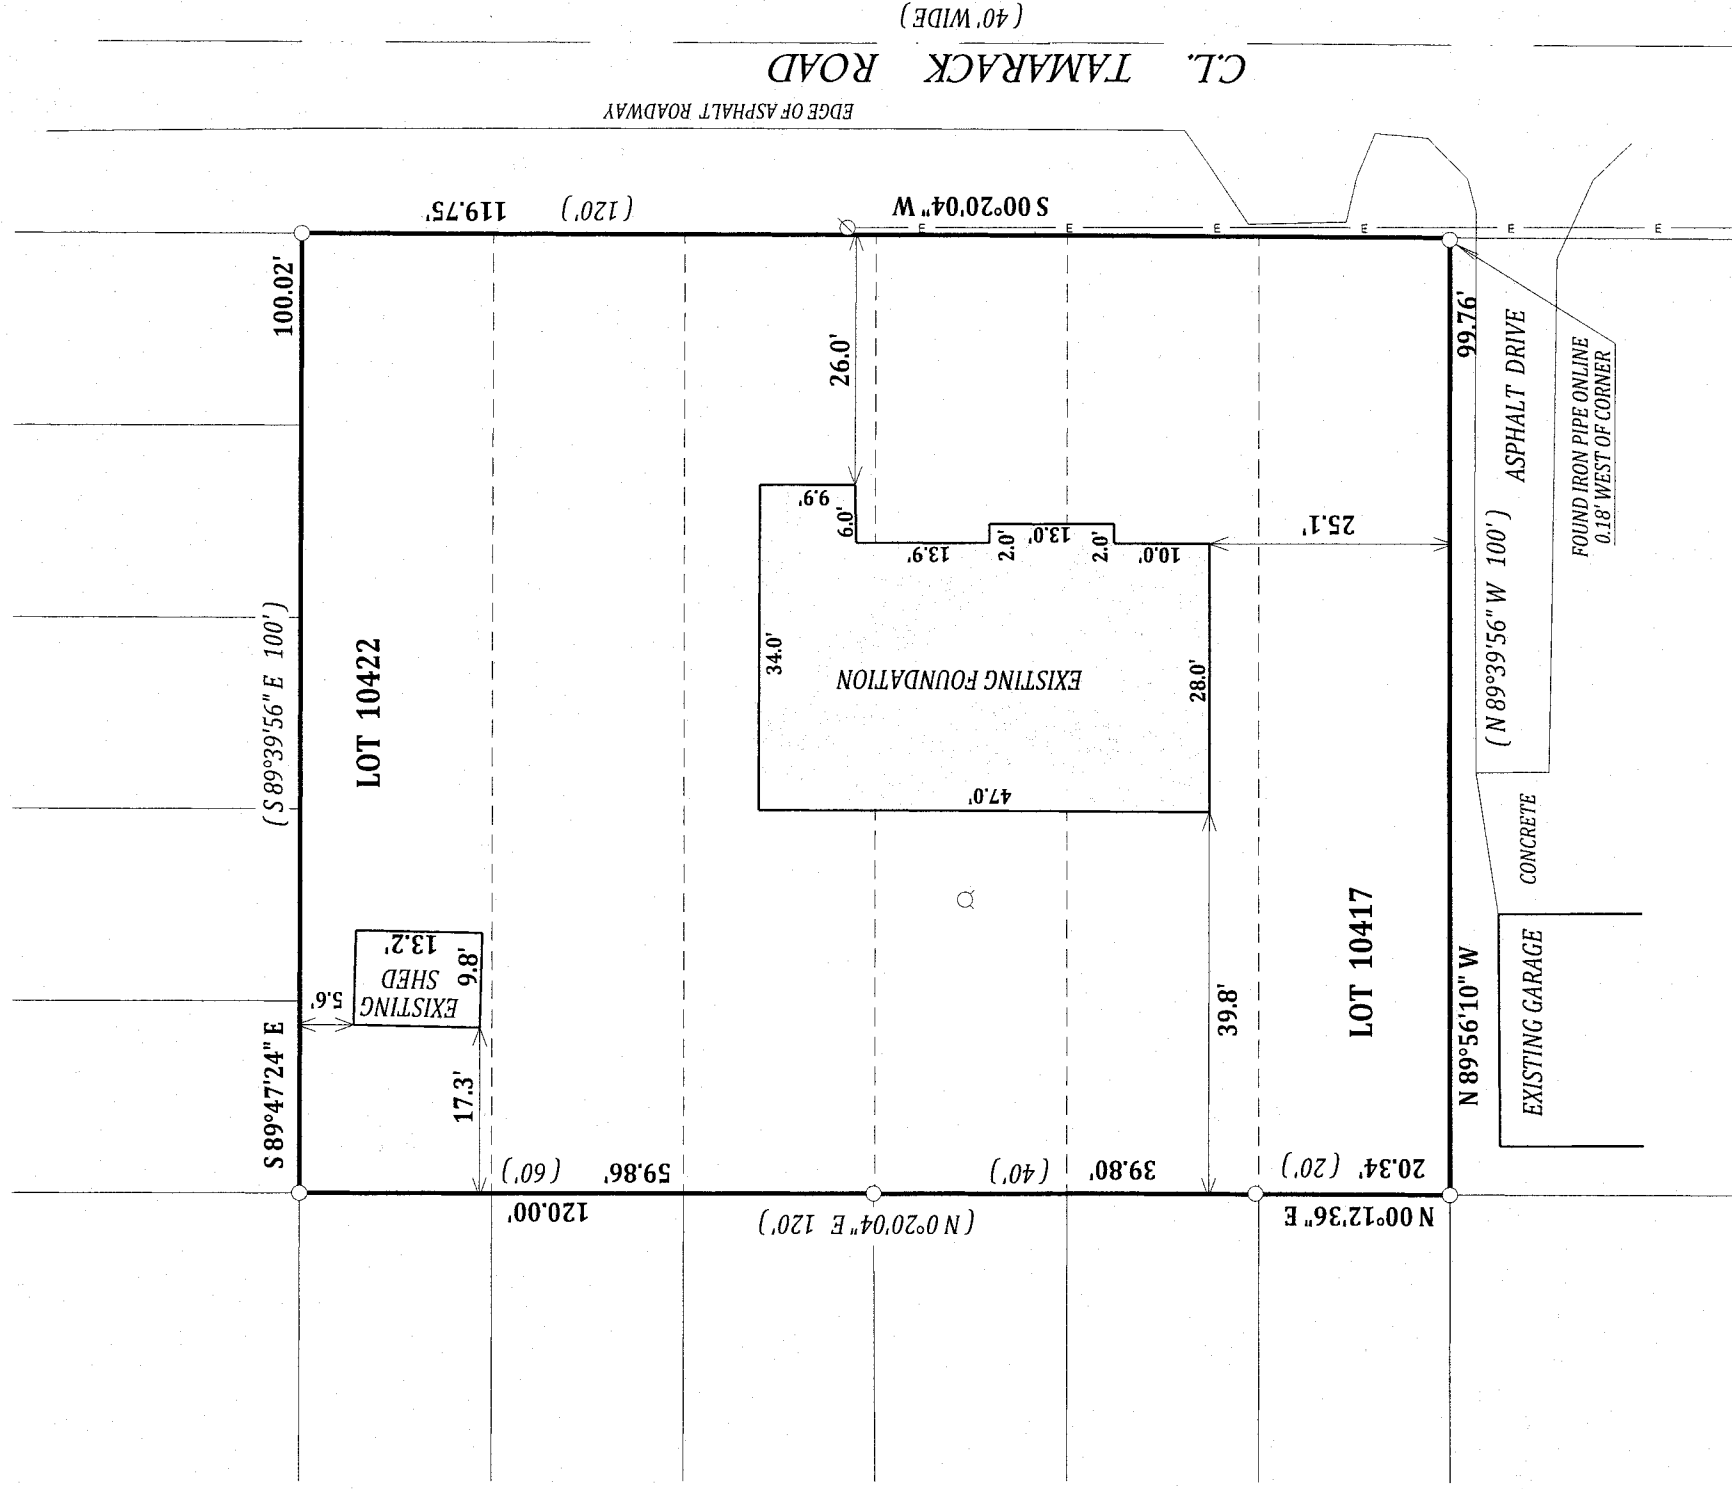

SCALE 1" = 20'

NOTE: BEARINGS ARE REFERENCED TO THE RECORD PLAT.



LEGEND

○ FOUND IRON PIPE

○ WELL

○ UTILITY POLE

— OVER HEAD WIRES

(XX) RECORDED AS


TAX ID # JLCB02256

JOB # 13-150AB

I have surveyed the above-described property and the above map is a true representation thereof and shows the size and location of the property, its exterior boundaries, the location and dimensions of all structures thereon, fences apparent easements and roadways and visible encroachments, if any.

This survey is made for the exclusive use of the present owners of the property, and also those who purchase, mortgage, or insure the title thereto within one (1) year from date hereof; and as to them I warrant the accuracy of said survey map.

DATED THIS 1st DAY OF OCTOBER 2013
DATE OF LAST REVISION: 11 / 12 / 2013
REVISED 10 / 15 / 2013

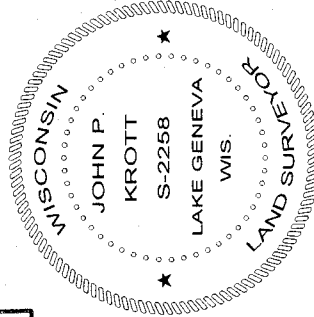

John P. Krott

JOHN P. KROTT S-2258
WISCONSIN REGISTERED LAND SURVEYOR
(NOTE: THIS IS NOT A CERTIFIED COPY
UNLESS SIGNED IN RED INK)

JLCB 02256 217-3939