


GEORGE T. DUNHAM
SURVEYING & SUBDIVIDING
DELAVAN, WISCONSIN

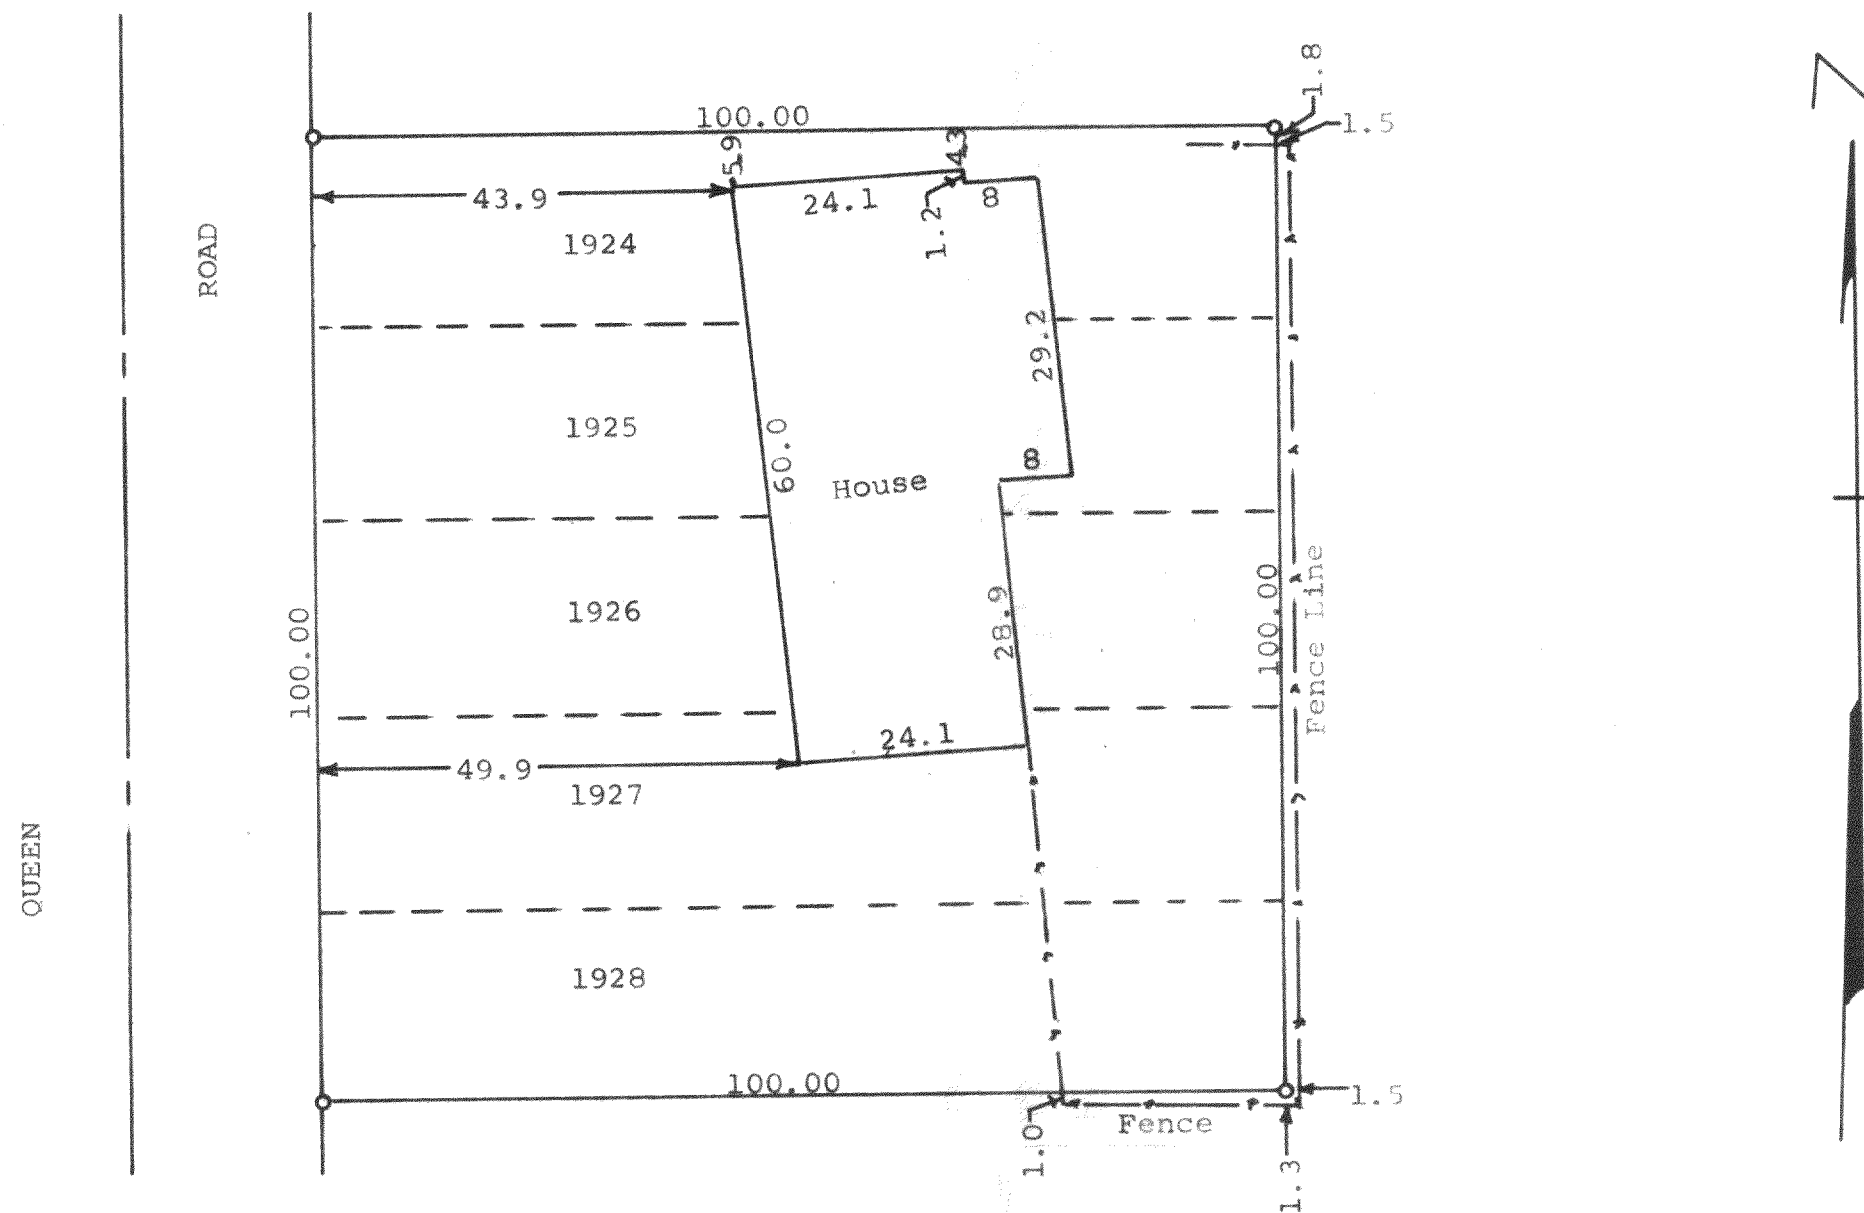

Scale - 1" = 20'
○ = Iron Pipe

STATE OF WISCONSIN)
COUNTY OF WALWORTH) SS

I, George T. Dunham, Surveyor, certify that I have surveyed
the property described as follows,
Lots 1924, 1925, 1926, 1927, and 1928 in the 3rd Map of Lake
Como Beach, a subdivision located in Section 22, T 2 N, R 17 E,
Walworth County, Wisconsin,
and that the above plat is an accurate survey and a true representation
thereof and correctly shows the exterior boundary lines and location of
buildings on said property and the correct measurements thereof.
April 22, 1974

George T. Dunham
George T. Dunham, Surveyor

