
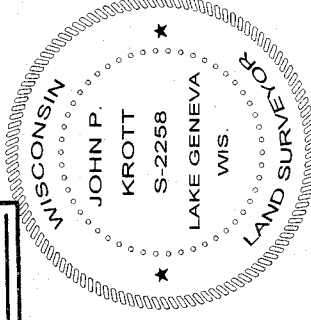
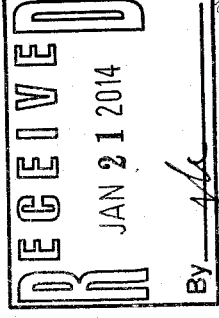
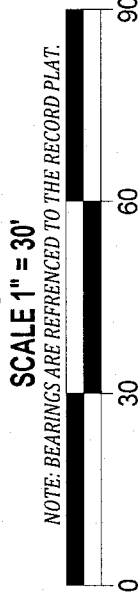
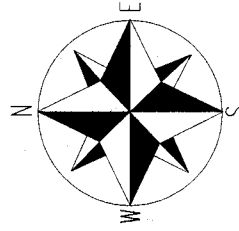


PREPARED FOR
BECKY MERWIN
RAULAND AGENCY
P.O. BOX 159
WALWORTH WI. 53184

PLAT OF SURVEY OF

UNIT 17-13 IN GENEVA NATIONAL CONDOMINIUM NO. 17, BEING A CONDOMINIUM
CREATED UNDER THE CONDOMINIUM OWNERSHIP ACT OF THE STATE OF WISCONSIN BY A
"DECLARATION OF CONDOMINIUM FOR GENEVA NATIONAL", DATED THE 22 DAY OF MAY, 1990 AND
RECORDED THE 29th DAY OF MAY, 1990 IN THE OFFICE OF THE REGISTER OF DEEDS FOR
WALWORTH COUNTY, WISCONSIN IN VOL. 487 OF RECORDS AT PAGES 929 THROUGH 976, AS
DOCUMENT NO. 194775 AND BY A CONDOMINIUM PLAT THEREOF.

KROTT SURVEYING INC.
(262) 248-3697
N 3705 WILLOW BEND LANE
LAKE GENEVA WI. 53147

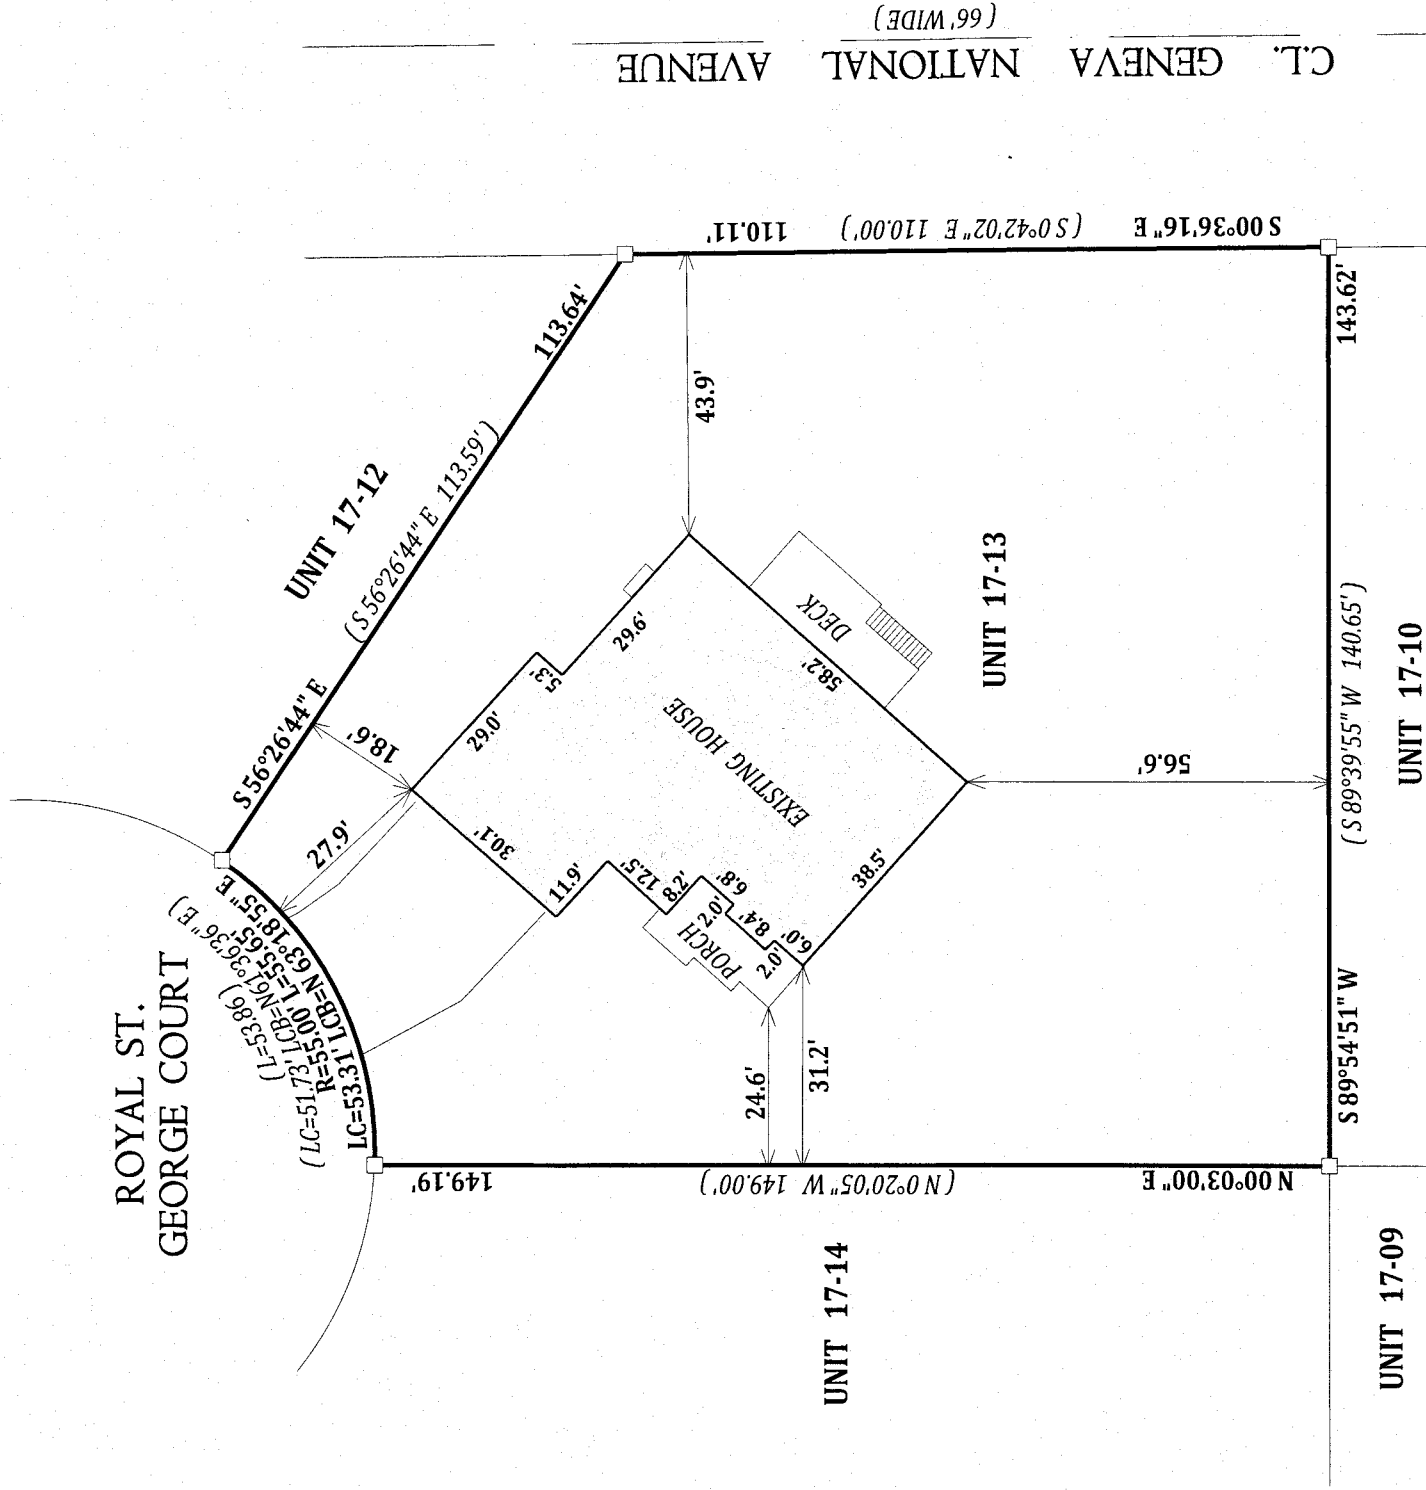

LEGEND

☐ FOUND IRON BAR

(XX) RECORDED AS

TAX ID # JGN1700013

JOB # 14-002

I have surveyed the above-described property and the above map is a true representation thereof and shows the size and location of the property, its exterior boundaries, the location and dimensions of all structures thereon, fences apparent easements and roadways and visible encroachments, if any.

This survey is made for the exclusive use of the present owners of the property, and also those who purchase, mortgage, or insure the title thereto within one (1) year from date hereof; and as to them I warrant the accuracy of said survey map.

DATED THIS 14th DAY OF JANUARY 2014

John P. Krott

JOHN P. KROTT S-2258
WISCONSIN REGISTERED LAND SURVEYOR
(NOTE: THIS IS NOT A CERTIFIED COPY
UNLESS SIGNED IN RED INK)

JGN 17-13

217-3945