


Vanderstappen Surveying &
Engineering, Incorporated
1316 North Madison Street, Woodstock, Illinois
(815) 337-8310
www.vandersinc.com


PLAT OF SURVEY

Unit 3-33 in Geneva National Condominium No. 3, being a Subdivision of the Southeast Quarter of Section 30 and the Northeast Quarter of Section 31, Township 2 North, Range 17 East of the Third Principal Meridian, according to the Plat thereof, recorded June 26, 1991 as Document No. 213816, in Walworth County, Wisconsin.

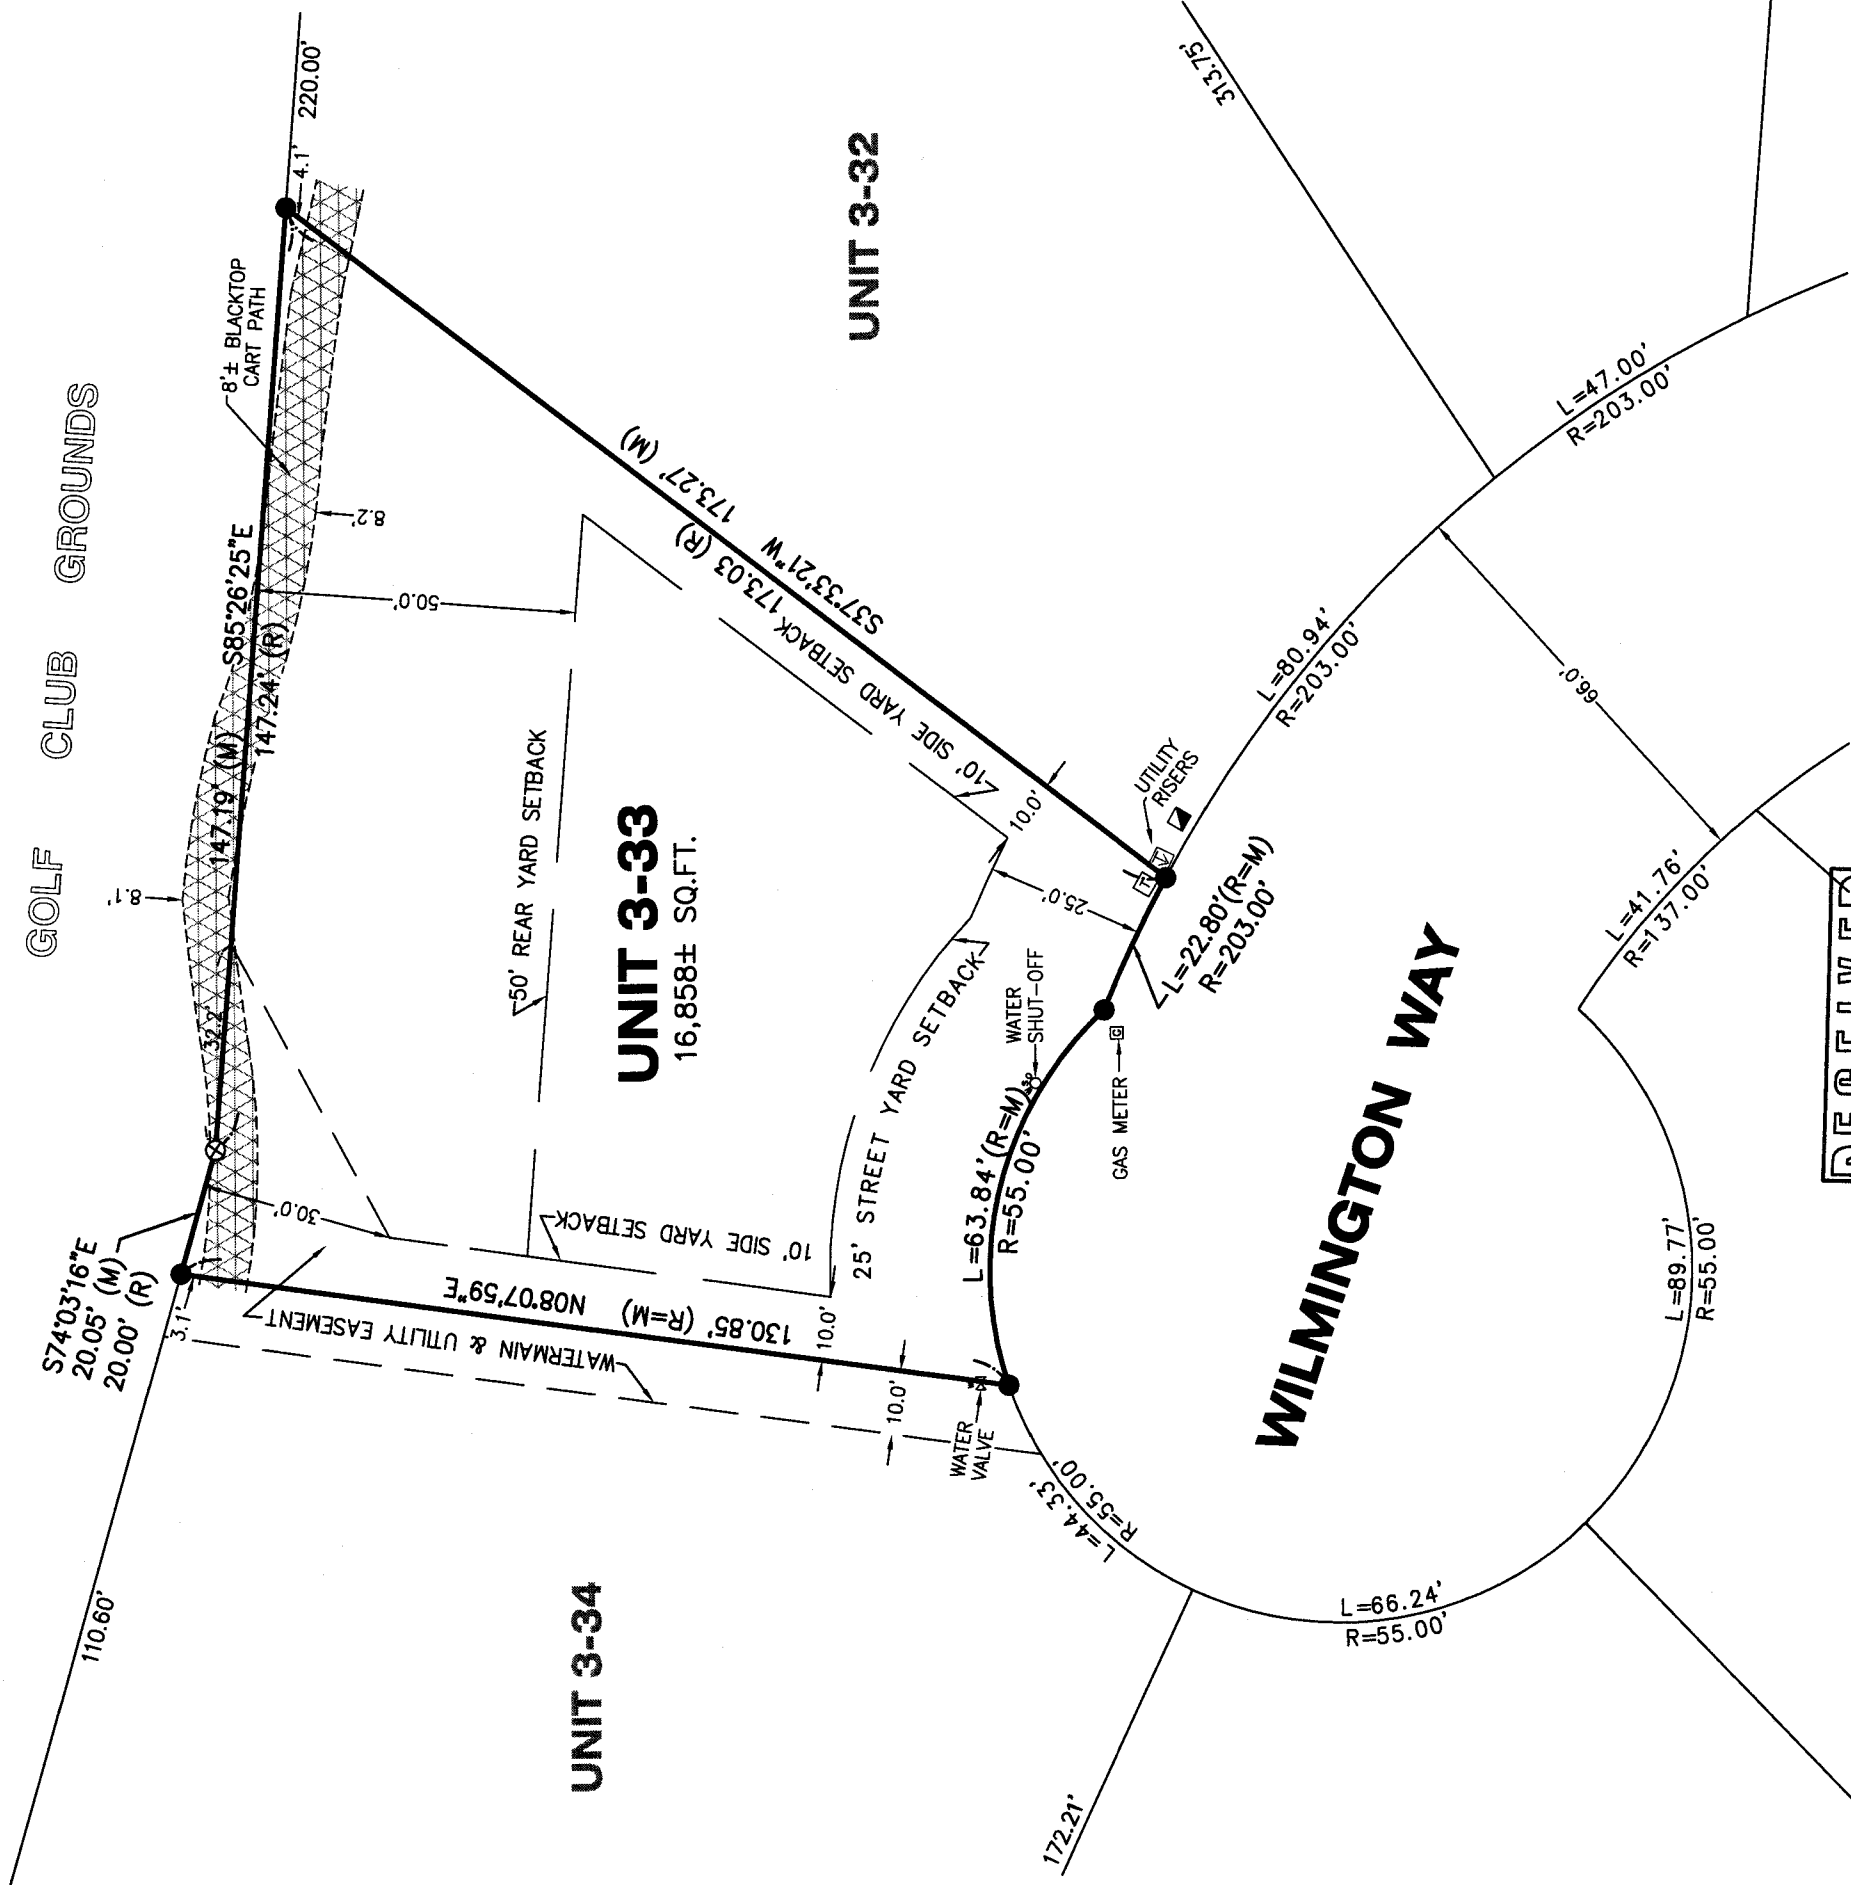

LEGEND	
● FOUND IRON BAR	⊙ SET IRON BAR
⊙ FOUND NAIL	⊙ SET NAIL
⊕ FOUND SPIKE	⊕ SET SPIKE
* FOUND CROSS	⊕ SET CROSS
○ FOUND IRON PIPE	⊕ FOUND MONUMENT
(M) MEASURED	(D) DEED (R) RECORD

CLIENT: TERRY KRAL
DRAWN BY: ST CHECKED BY: WJV
SCALE: 1"=30' SEC. 30, 31 T. 2 R. 17 E.
BASIS OF BEARING: ASSUMED
P.I.N.: JGN300033
JOB NO.: 100555 I.D. LSS
FIELDWORK COMP.: 11/29/10 BK. PG.
ALL DISTANCES SHOWN IN FEET AND DECIMAL REF.
PARTS THEREOF CORRECTED TO 68° F.

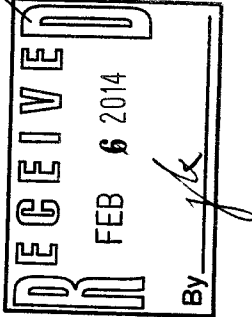

STATE OF ILLINOIS)
COUNTY OF McHENRY) S.S.

In my professional opinion and based on my observations, I hereby certify that the above described property has been surveyed under my direction and that the above map is a true representation thereof and shows the size and location of all visible structures, and dimensions of all principle buildings thereon, boundary fences, apparent easements, roadways, and visible encroachments, if any. This survey is made for the use of the present owners of the property, and also those who purchase, mortgage, or guarantee the title thereto within one year from the date hereof.

Dated at Woodstock,
McHenry County, Illinois 11/30 A.D., 20 10 .
Vanderstappen Surveying & Engineering, Inc.
Design Firm No. 184-002792

By: Wisconsin Registered Land Surveyor No. S1777