


TOPOGRAPHICAL MAPPING

LOT 6 OF TRINITY MOUNTAIN ESTATES, A SUBDIVISION


LOCATED IN PART OF THE NE 1/4, NW 1/4, SW 1/4, AND SE 1/4 OF THE SE 1/4 OF SECTION 13, AND THE NE 1/4 AND NW 1/4 OF THE SE 1/4 OF SECTION 24, TOWN 2 NORTH, RANGE 17 EAST, TOWN OF GENEVA, WALWORTH COUNTY, WISCONSIN

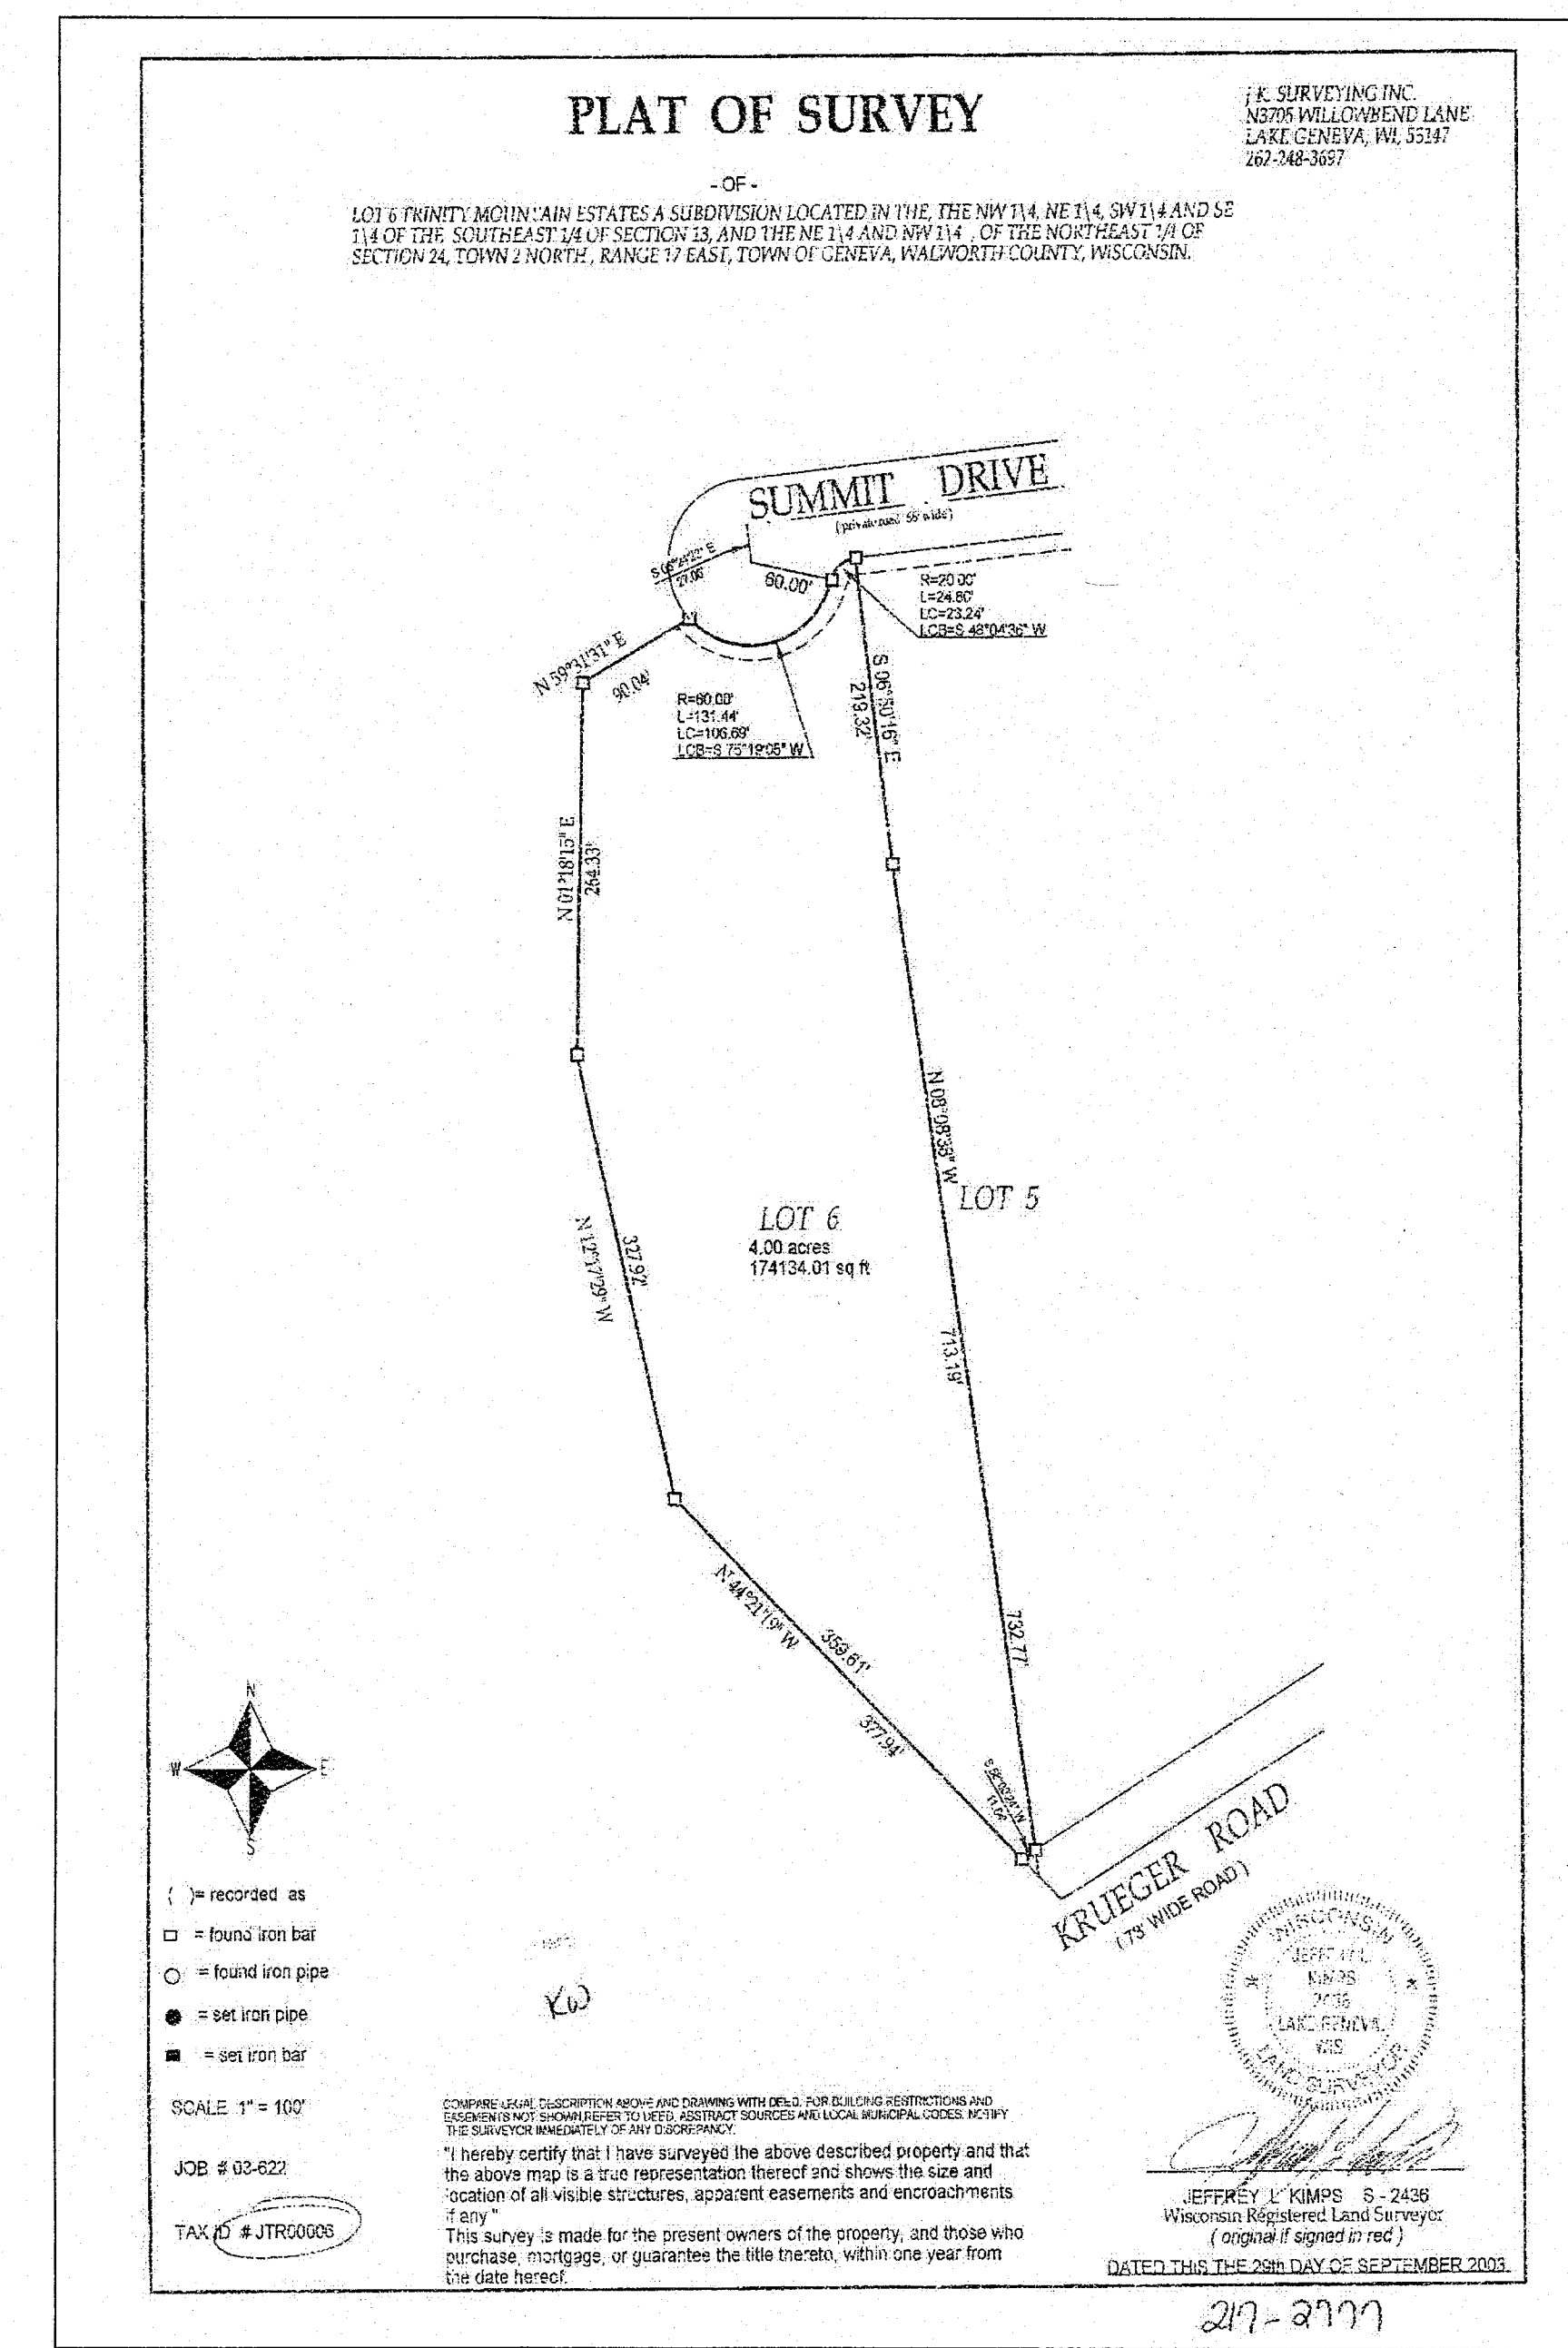

WORK ORDERED BY -
SCOTT LOWELL
C/O LOWELL MANAGEMENT SERVICES
P.O. BOX 926
LAKE GENEVA, WI 53147

FARRIS, HANSEN & ASSOCIATES, INC.
ENGINEERING - ARCHITECTURE - SURVEYING
7 RIDGWAY COURT P.O. BOX 437
ELKHORN, WISCONSIN 53121
OFFICE: (262) 723-2098 FAX: (262) 723-5886

REVISIONS	
PROJECT NO.	8967
DATE	03-17-2014
SHEET NO.	1 OF 1

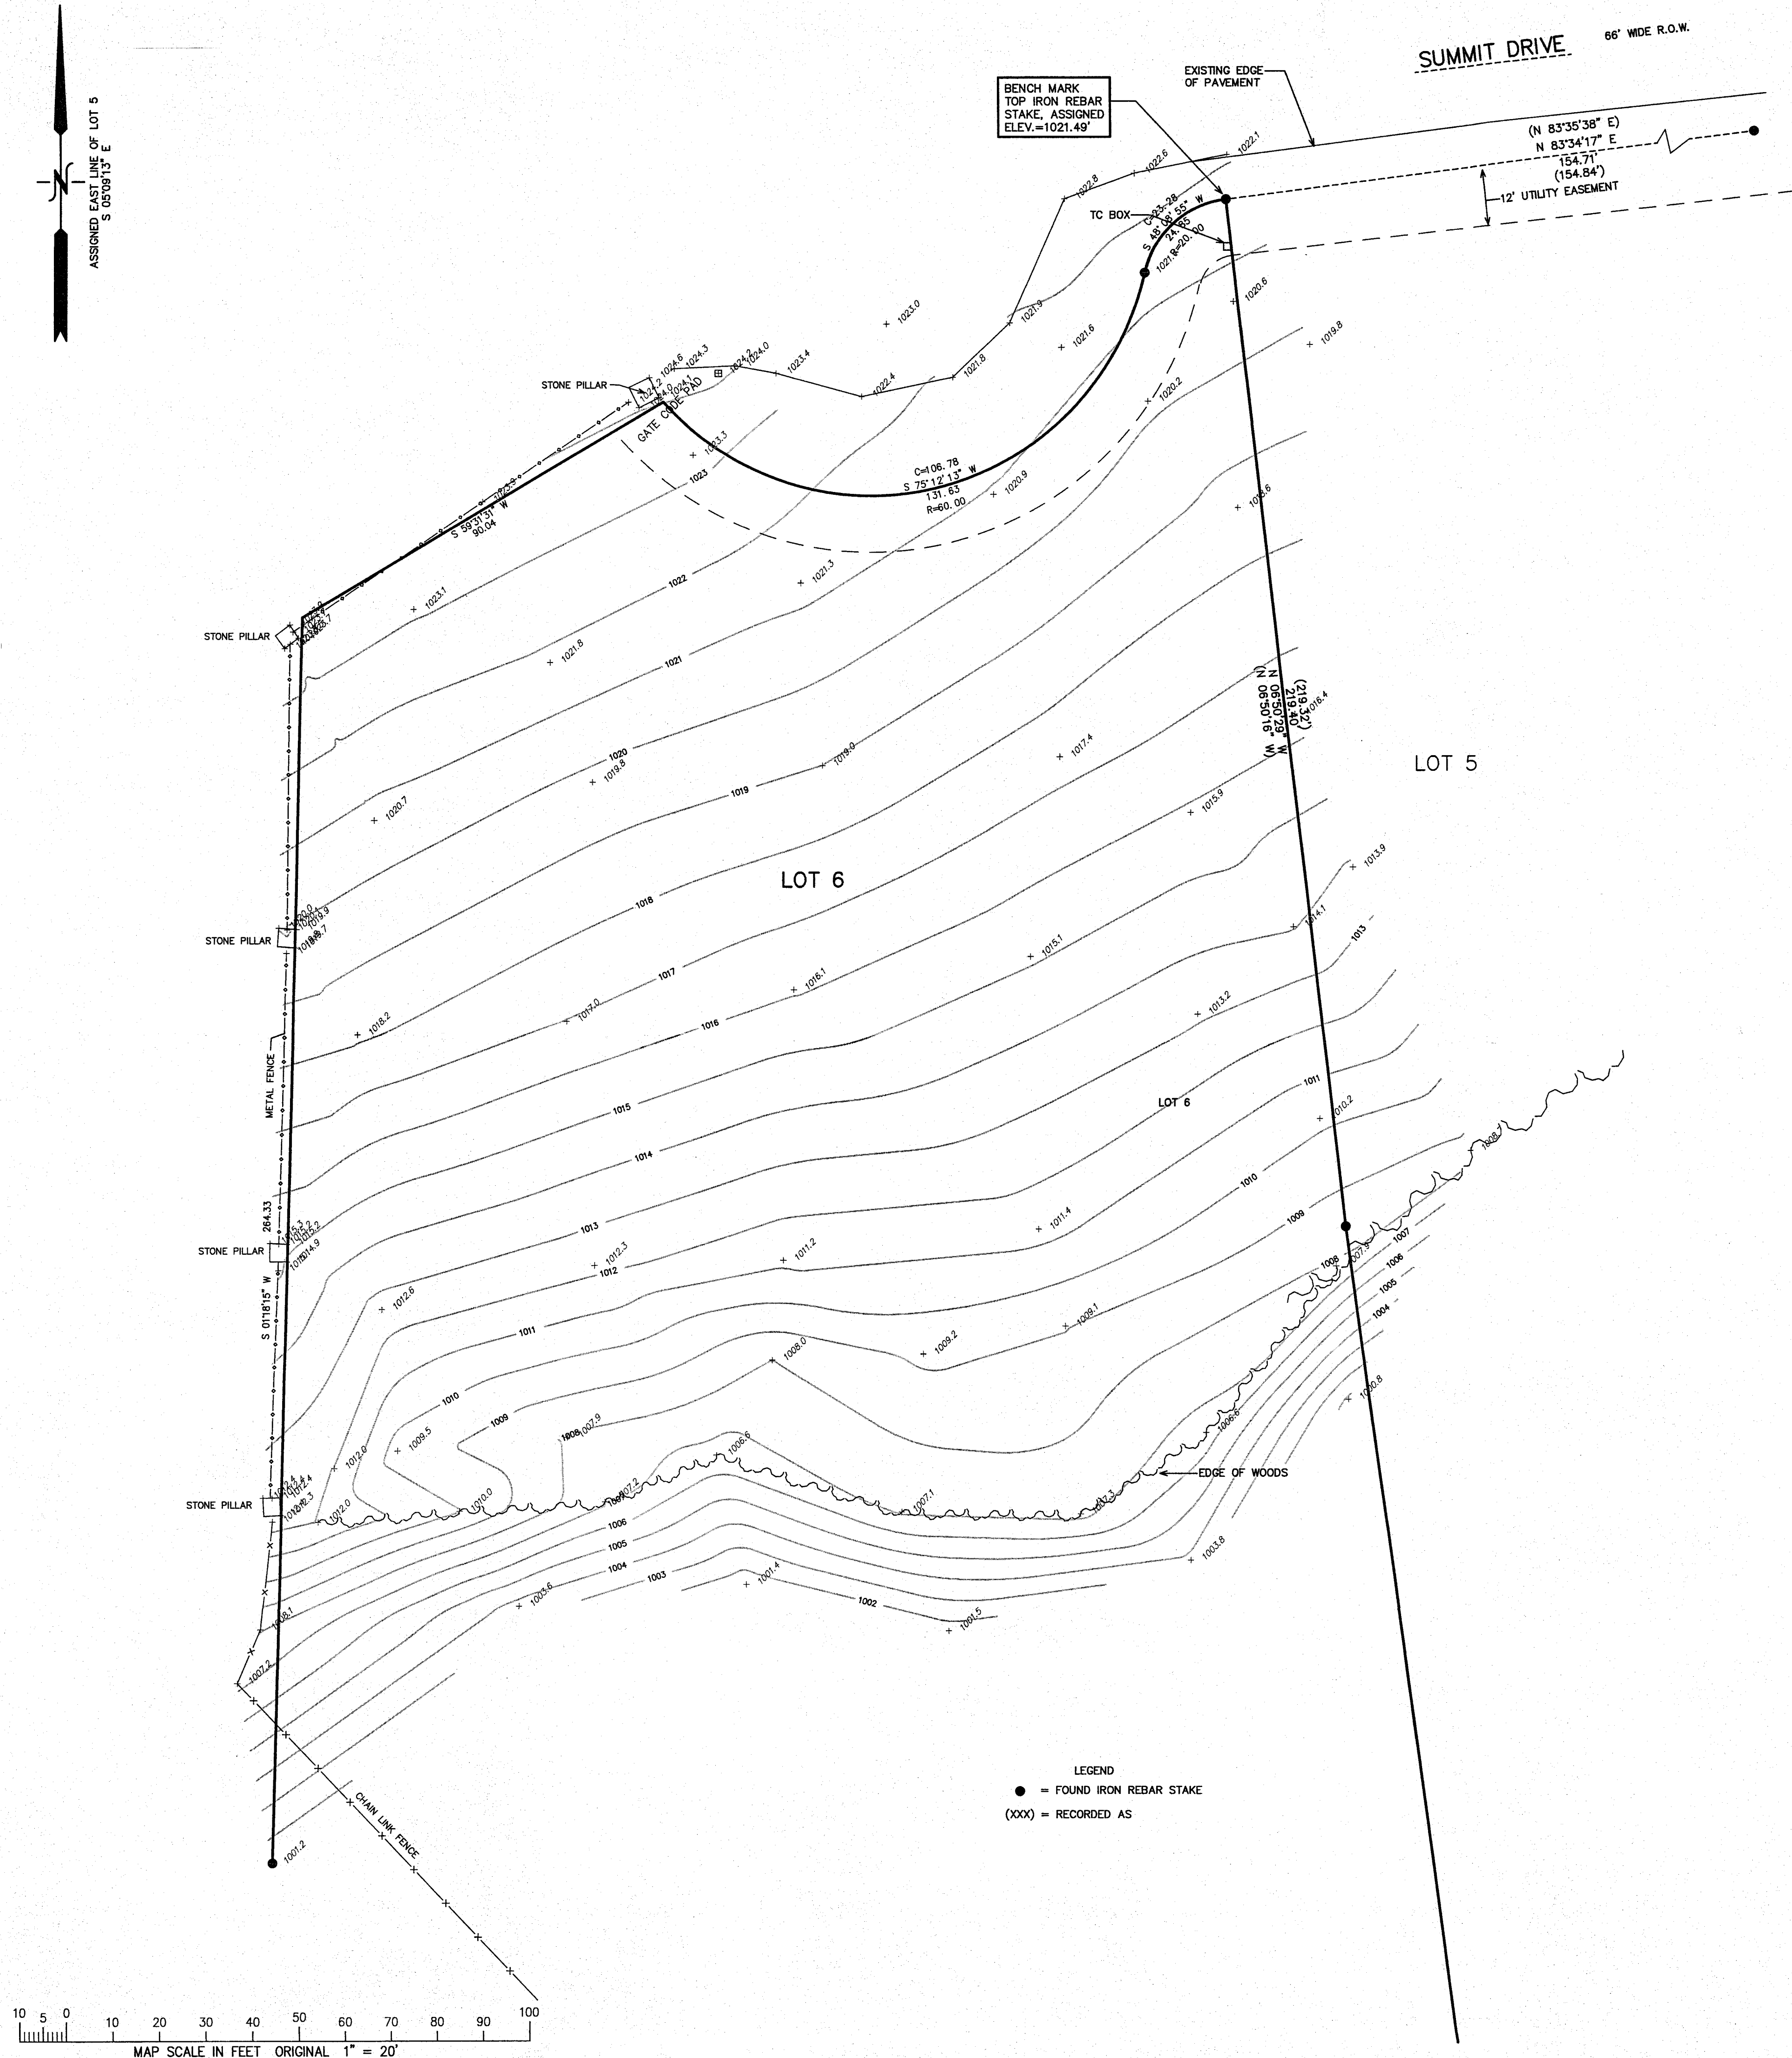

MAR 18 2014