


PREPARED FOR
EDITH VILLEGAS
N3137 CTY RD "H"
LAKE GENEVA, WI. 53147

[illegible]


Together with easements for ingress and egress as shown on Wabworth County Certified Survey Map No. 4191.

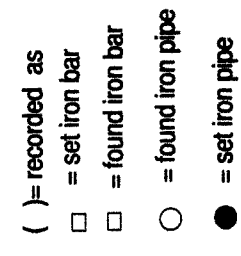



JOB # 13-194

COMPARE LEGAL DESCRIPTION ABOVE AND DRAWING WITH DEED. FOR BUILDING RESTRICTIONS AND EASEMENTS NOT SHOWN, REFER TO DEED, ABSTRACT SOURCES AND LOCAL MUNICIPAL CODES. NOTIFY THE SURVEYOR IMMEDIATELY OF ANY DISCREPANCY.

DATED THIS 4th day of October, 2013.

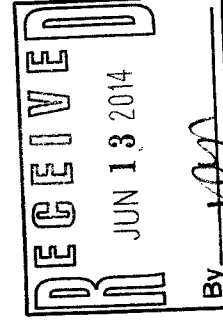

JEH -50
J G 24-7F

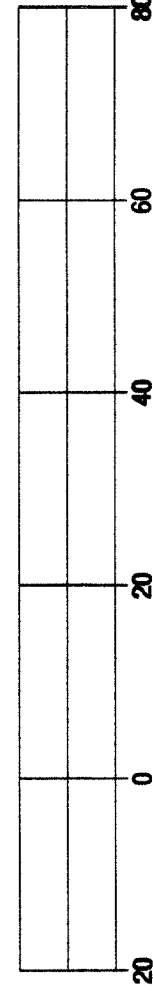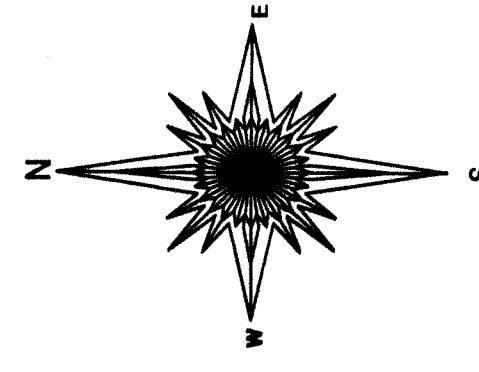

BASIS OF BEARING OF THIS MAP : CERTIFIED SURVEY MAP 2926.