


ORDERED BY
RICHARD SHORT
2015 JOHNSBURG RD
JOHNSBURG, IL. 60051

PLAT OF SURVEY

PATHFINDER SURVEYING INC.
(formerly)
J.K. SURVEYING INC.
P.O BOX 322
LAKE GENEVA, WI. 53147
WWW.PATHFINDERSURVEYING.NET
262-248-8303

- OF -

LOTS 5519 THRU 5521 AND LOTS 5558 THRU 5662 BLOCK 99 OF LAKE COMO BEACH
SUBDIVISION; LOCATED IN TOWN 2 NORTH, RANGE 17 EAST, TOWN OF GENEVA,
WALWORTH COUNTY, WISCONSIN

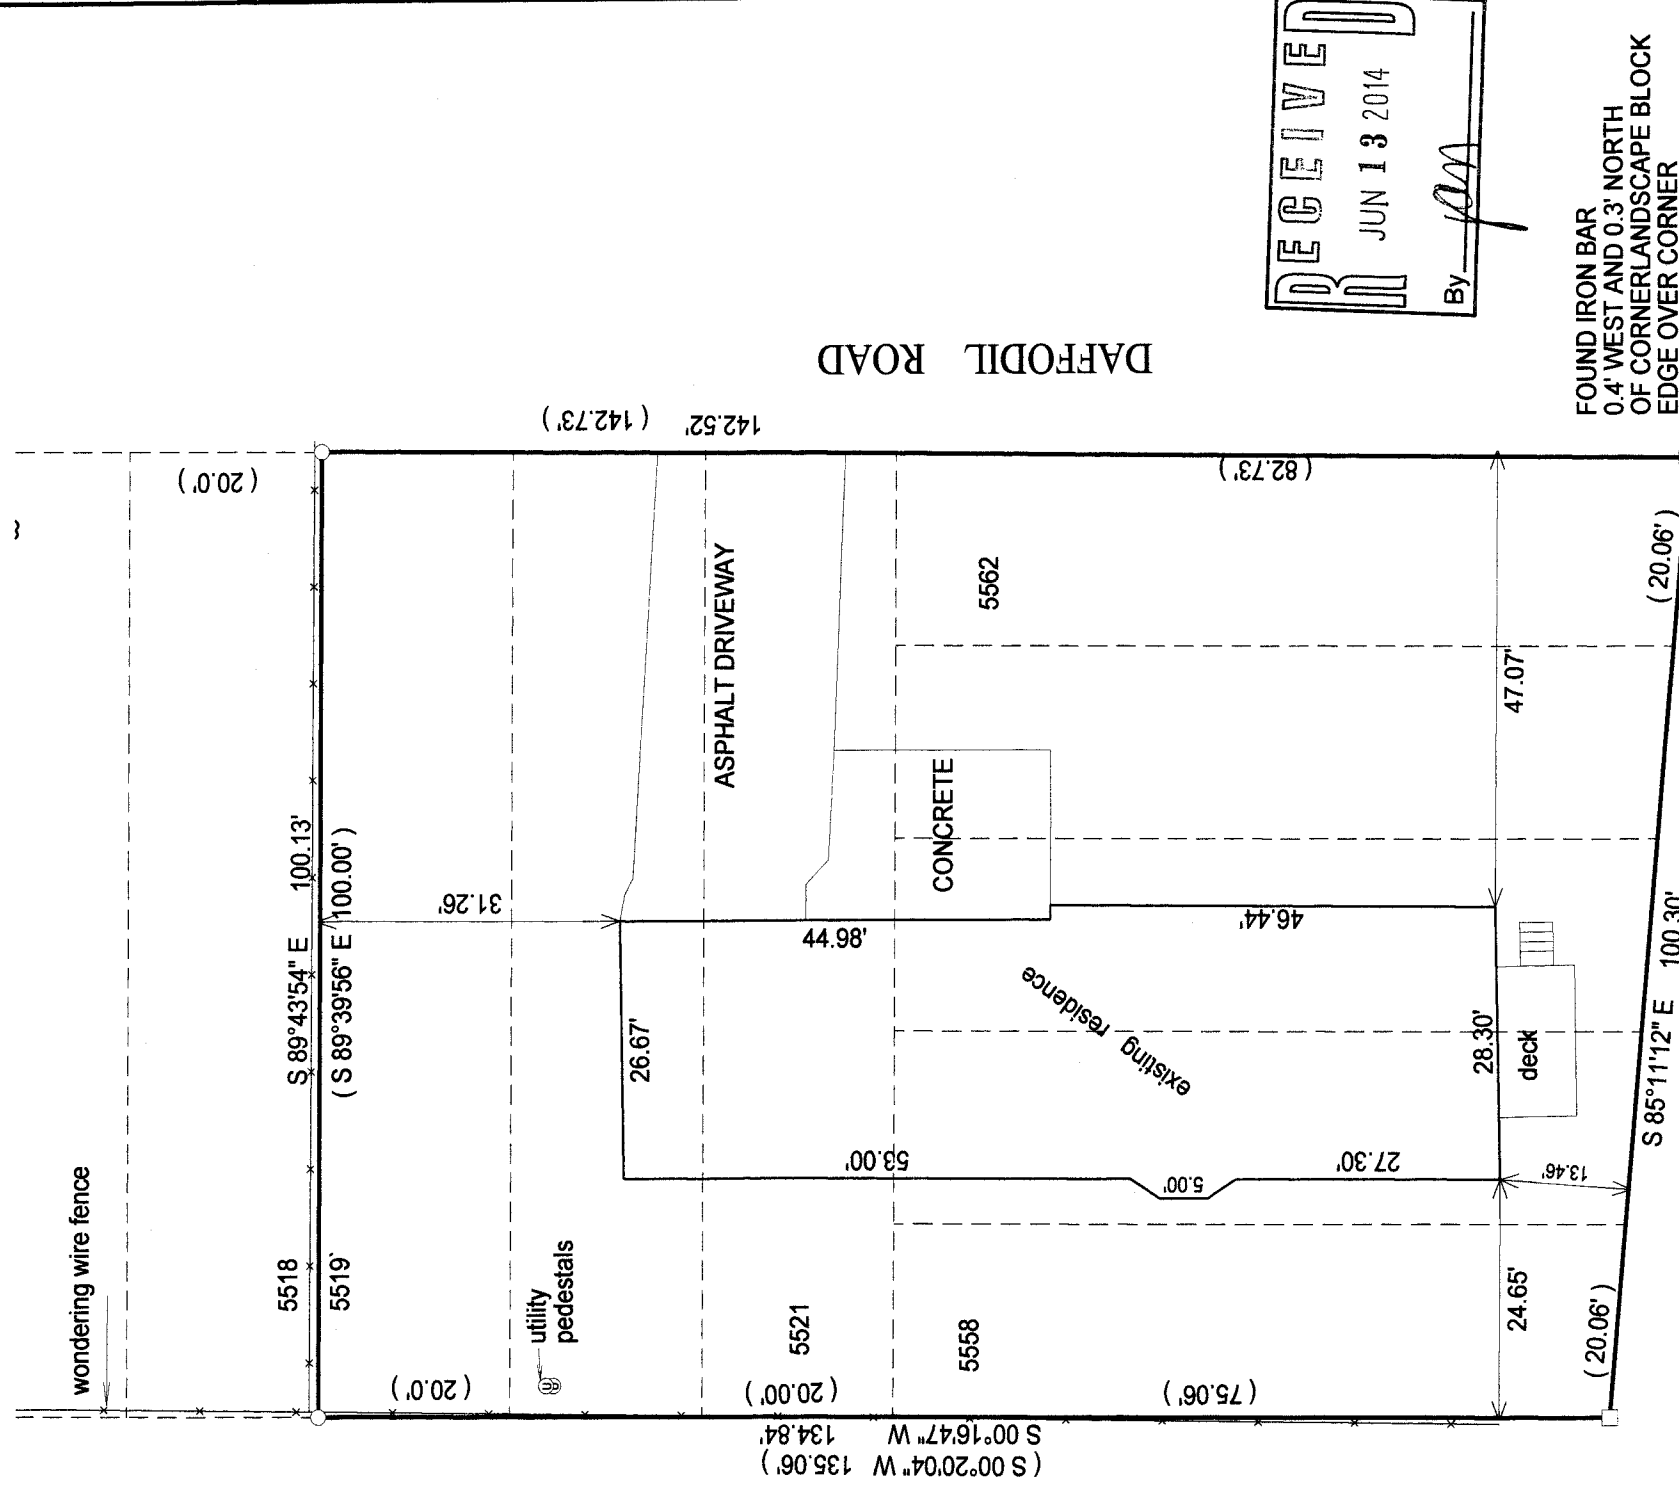


- () = recorded as
- = found iron bar
- = found iron pipe
- = set iron pipe
- = set iron bar

SCALE 1" = 20'

JOB # 13-75C

TAX ID #

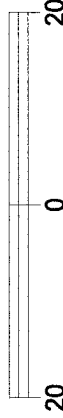

BASIS OF BEARING OF THIS PLAT: THE
WEST LINE OF DAFFODIL WAS ASSUMED
TO BEAR N 00°20'04" AS SHOWN ON THE
RECORD PLAT OF LAKE COMO BEACH.

I hereby certify that I have surveyed the above- described property and the
above map is a true representation thereof and shows the size and
location of the property, its exterior boundaries, the location and
dimensions of all structures thereon, fences, appurtenant easements and
roadways and visible encroachments if any.

This survey is made for the present owners of the property, and those who
purchase, mortgage, or guarantee the title thereto, within one year from
the date hereof.

DATED THIS 15TH DAY OF OCTOBER, 2013.



JEFFREY L. KIMPS S-2436
Wisconsin Registered Land Surveyor
(original if signed in red)

JLCB -1130 217-3964