



PREPARED FOR:
DIANE COCROFT
KEEFE REALTY
751 GENEVA PARKWAY
LAKE GENEVA WI 53147

PLAT OF SURVEY

- OF -

LOTS 3483, 3484 AND 3485, BLOCK 61, LAKE COMO BEACH 2nd MAP A SUBDIVISION LOCATED
IN THE SW 1/4 OF SECTION 22, TOWN 2 NORTH, RANGE 17 EAST TOWN OF GENEVA, WALWORTH
COUNTY, WISCONSIN.

PATHFINDER SURVEYING INC.
(formerly)
J.K. SURVEYING INC.
P.O BOX 322
LAKE GENEVA, WI. 53147
WWW.PATHFINDERSURVEYING.NET
262-248-8303

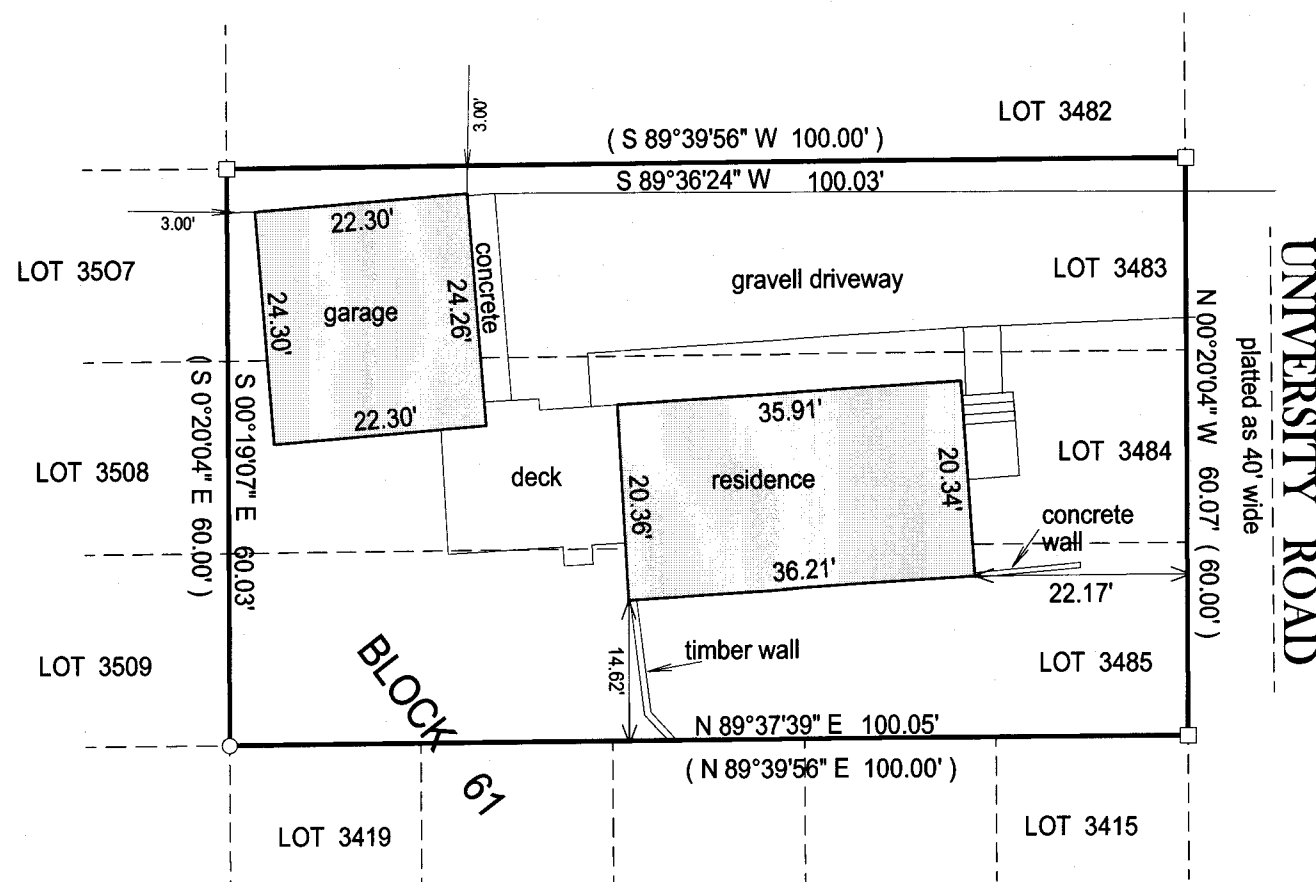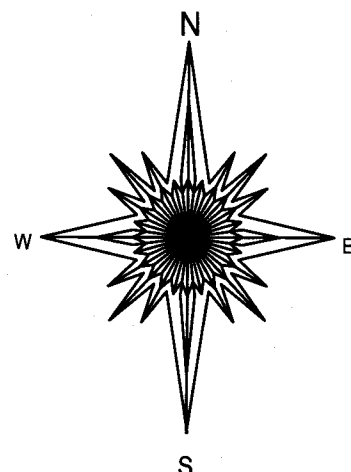

- () = recorded as
□ = found iron bar
○ = found iron pipe
● = set iron pipe
■ = set iron bar



BASIS OF BEARING OF THIS PLAT: THE WEST LINE OF UNIVERSITY ROAD
WAS ASSUMED TO BEAR N00°20'04" W AS RECORDED.

"I hereby certify that I have surveyed the above described property and that the above
map is a true representation of its exterior boundary and shows the size and location of
all visible structures, apparent easements and encroachments if any."


This survey is made for the present owners of the property, and those who
purchase, mortgage, or guarantee the title thereto, within one year from
the date hereof.

DATED THIS 8TH DAY OF APRIL, 2014.

SCALE 1" = 20'

JOB # 14-51

TAX ID # JLCB00646

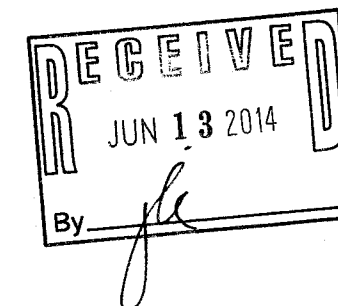

JEFFREY L. KIMPS, S-2436
Wisconsin Registered Land Surveyor
(original if signed in red)

JLCB-646 217-3966