

-DWELLING UNDER CONSTRUCTION
-BASEMENT, BACKFILL, STEEL
-MATERIAL ON SITE
-ROUGHING STARTING
-TOP OF WALL: 1000.57

LEGAL DESCRIPTION: LOTS 2530 THRU 2534, BLOCK 45
OF "LAKE COMO BEACH SECOND MAP, BEING A PART OF
SECTION 27, TOWN 2 NORTH, RANGE 17 EAST, IN THE
TOWN OF GENEVA, COUNTY OF WALWORTH, STATE OF
WISCONSIN.

TAX KEY NO. JLCB 00433



STATE OF WISCONSIN
COUNTY OF RACINE

The above-described property has been surveyed under my direction and
the above map is a correct representation thereof.

DATED AT NORTH CAPE, THIS 7TH DAY OF AUGUST, 2013.

Pete L Bailey

AMERICAN SURVEYING COMPANY, INC.
PETE L. BAILEY, RLS NO. 1398
RECERTIFIED this 5TH day of NOVEMBER, 2013.

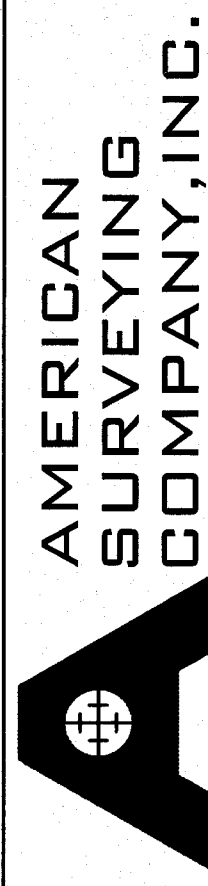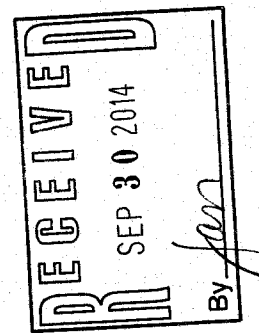

12207 C.T.H. "K" FRANKSVILLE, WISCONSIN 53126
TEL. (262) 835-4774 FAX: (262) 835-2379
beaufordbailey@hotmail.com

DRAWN BY:	PLB	REVISIONS:	DATE
CHECKED BY:	PLB		
PLOT SCALE:	1 = 10		
DATE:	06/29/2013		
JOB NO.:	2013058		
DWG. FILE:	JN2013098R	CLIENT NO.	03410


TOWN OF GENEVA

PROJECT:

PLAT OF SURVEY/BOUNDARY SURVEY

PREPARED FOR: F&W REMODELING

Sheet
1
of
1

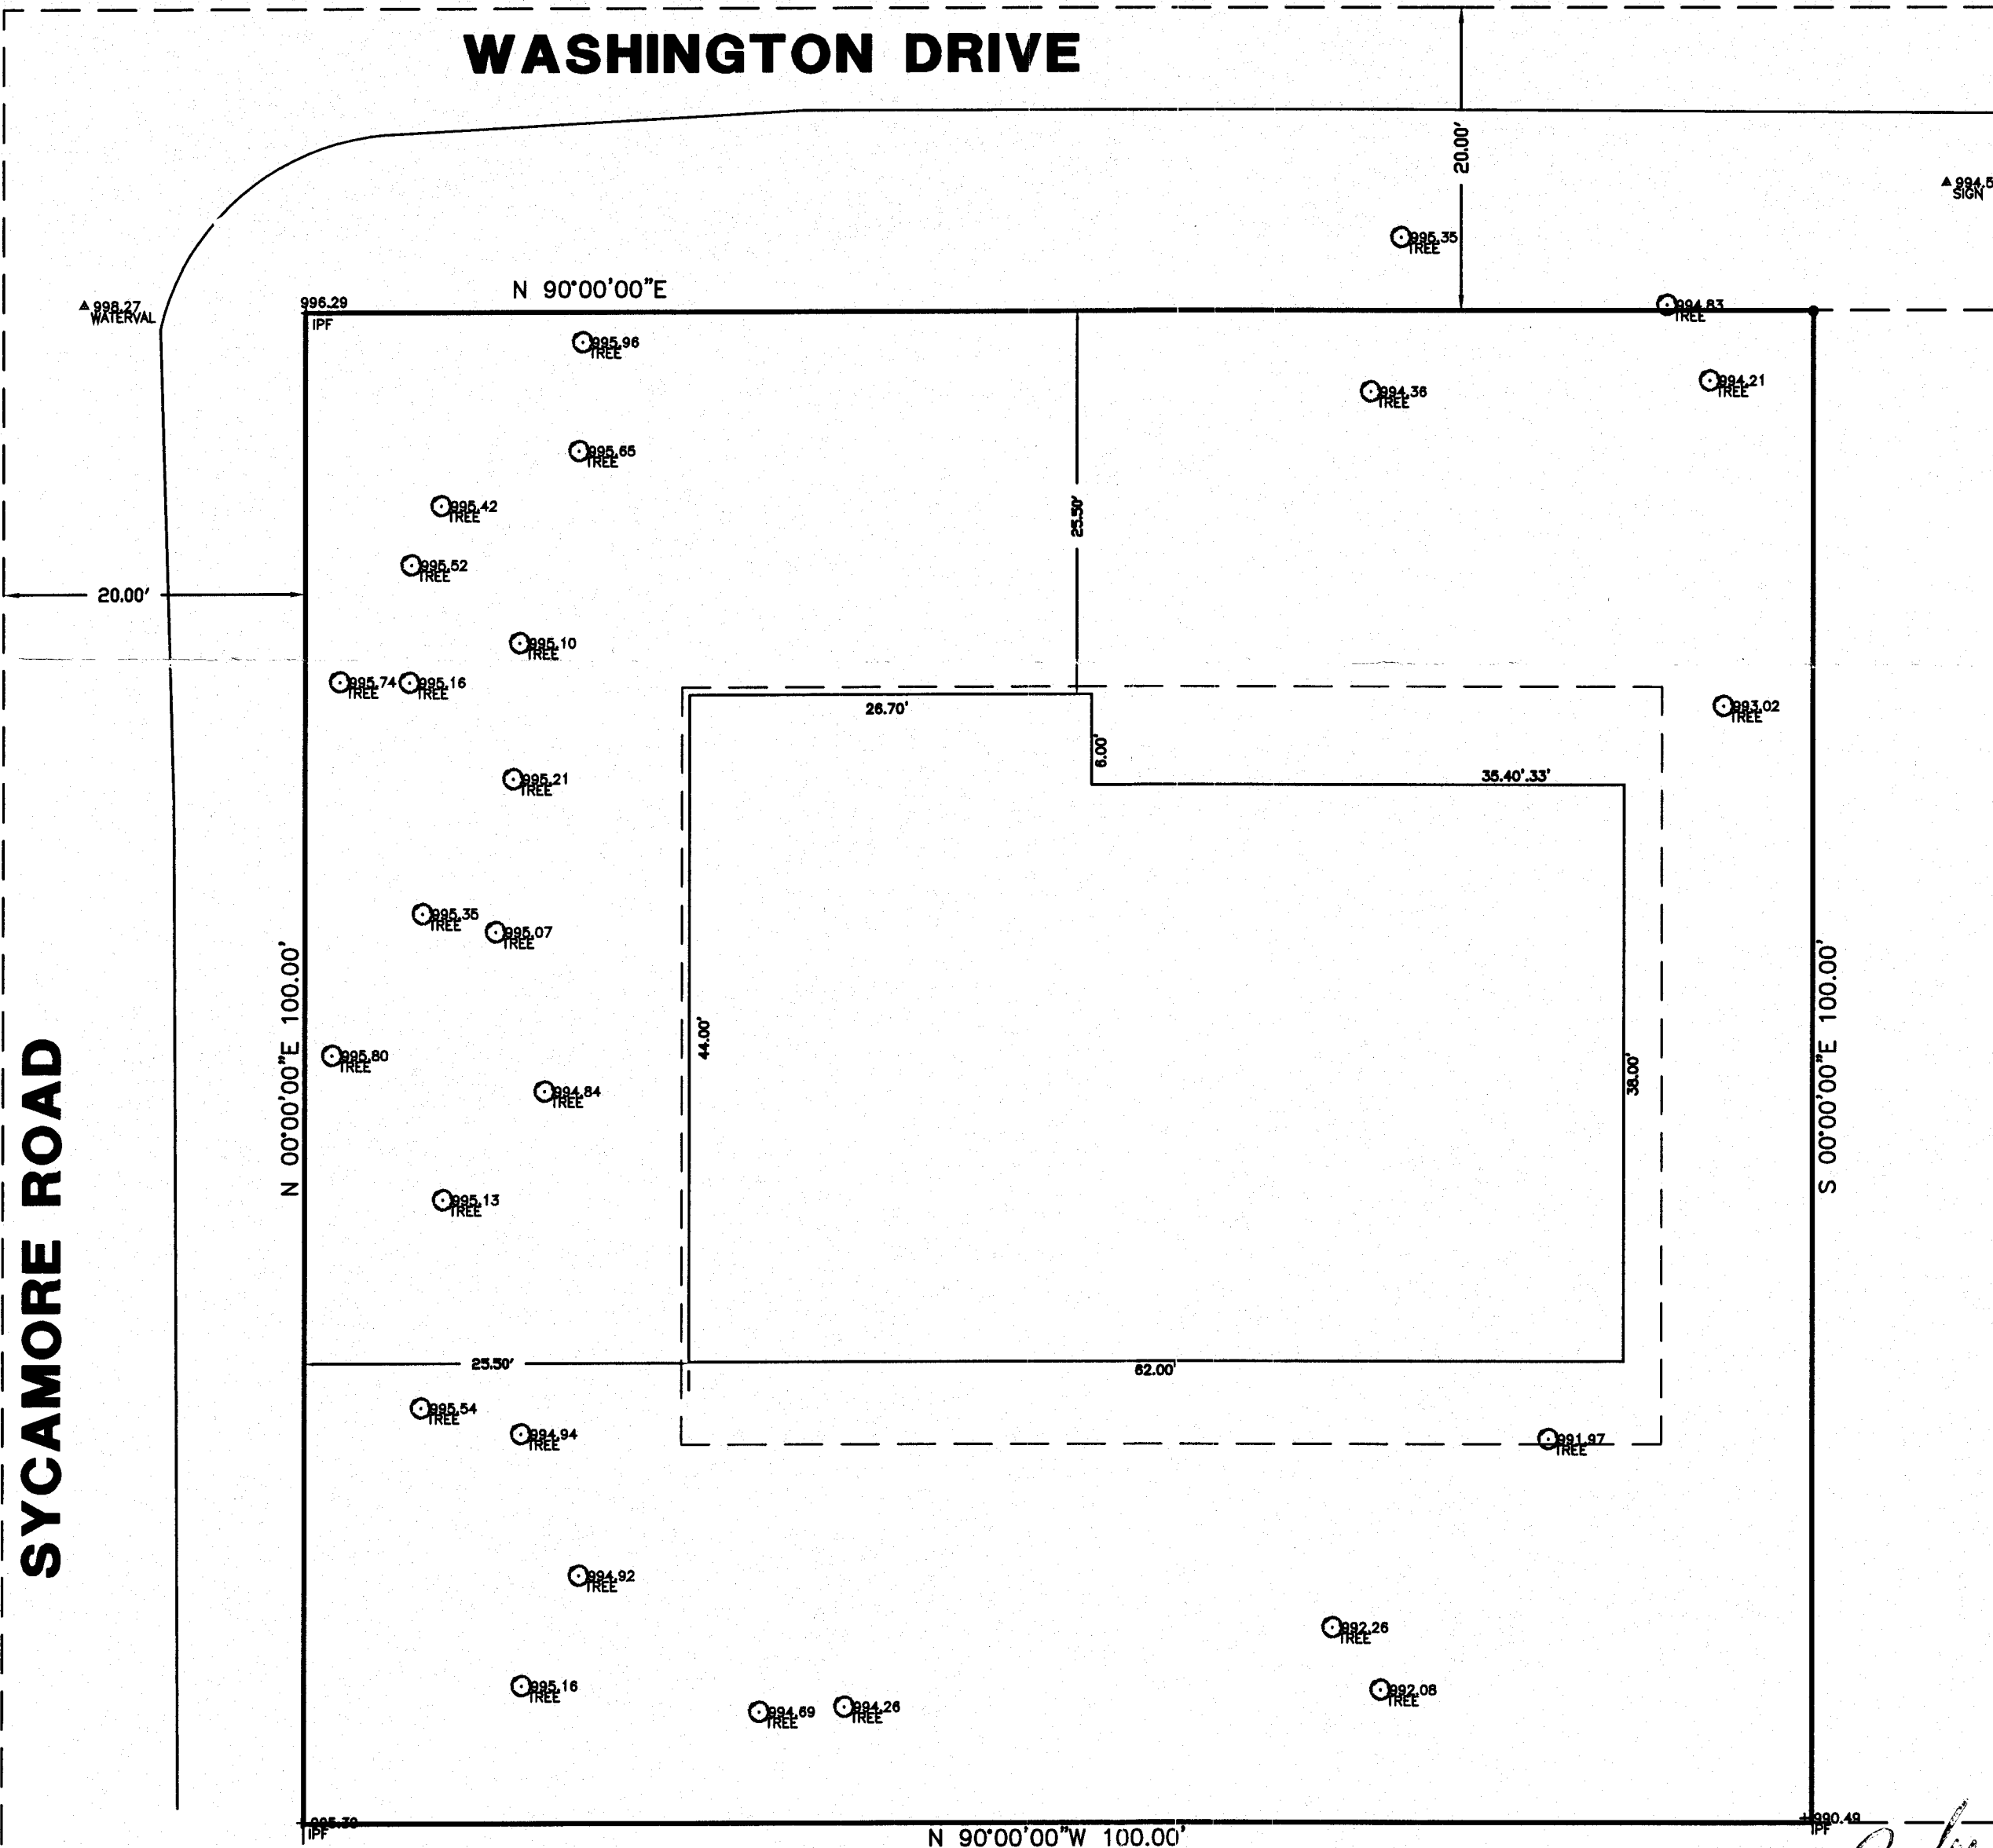

Pete L Bailey

