




PLAT OF SURVEY

UNIT 16-03
GENEVA NATIONAL CONDOMINIUM
NO. 16

LOCATED IN TOWN 2 NORTH, RANGE 17 EAST
WALWORTH COUNTY, WISCONSIN

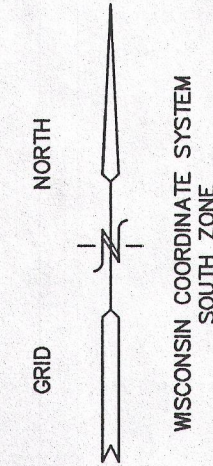



2014 RESURVEY ORDERED BY:
VAL LECAS
1525 GENEVA NATIONAL AVE NORTH
LAKE GENEVA, WI. 53147

WORK ORDERED BY
CURT LANGLE - Lanco Devel. Co.
7355 Bannockburn Circle
Lakewood, IL 60014

FARRIS, HANSEN & ASSOCIATES, INC.
Engineering, Architecture, Surveying
7 Ridgeway Court P.O. Box 437
Elkhorn, Wisconsin 53121
Office: (262) 723-2098
Fax: (262) 723-5886

REVISIONS
09/09/2004
SITE, GRADING,
DRAINAGE, &
EROSION
CONTROL PLAN
01/21/2005
TO SHOW SIZE
& LOCATION
OF AS-BUILT
FOUNDATION
04/06/2006
UPDATE TO
TITLE SPECS.

PROJECT NO.
3269.16.03
DATE:
04/15/04
SHEET NO.
1 OF 1

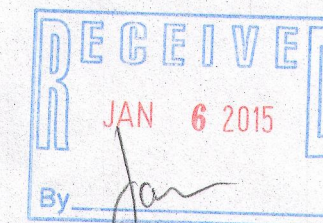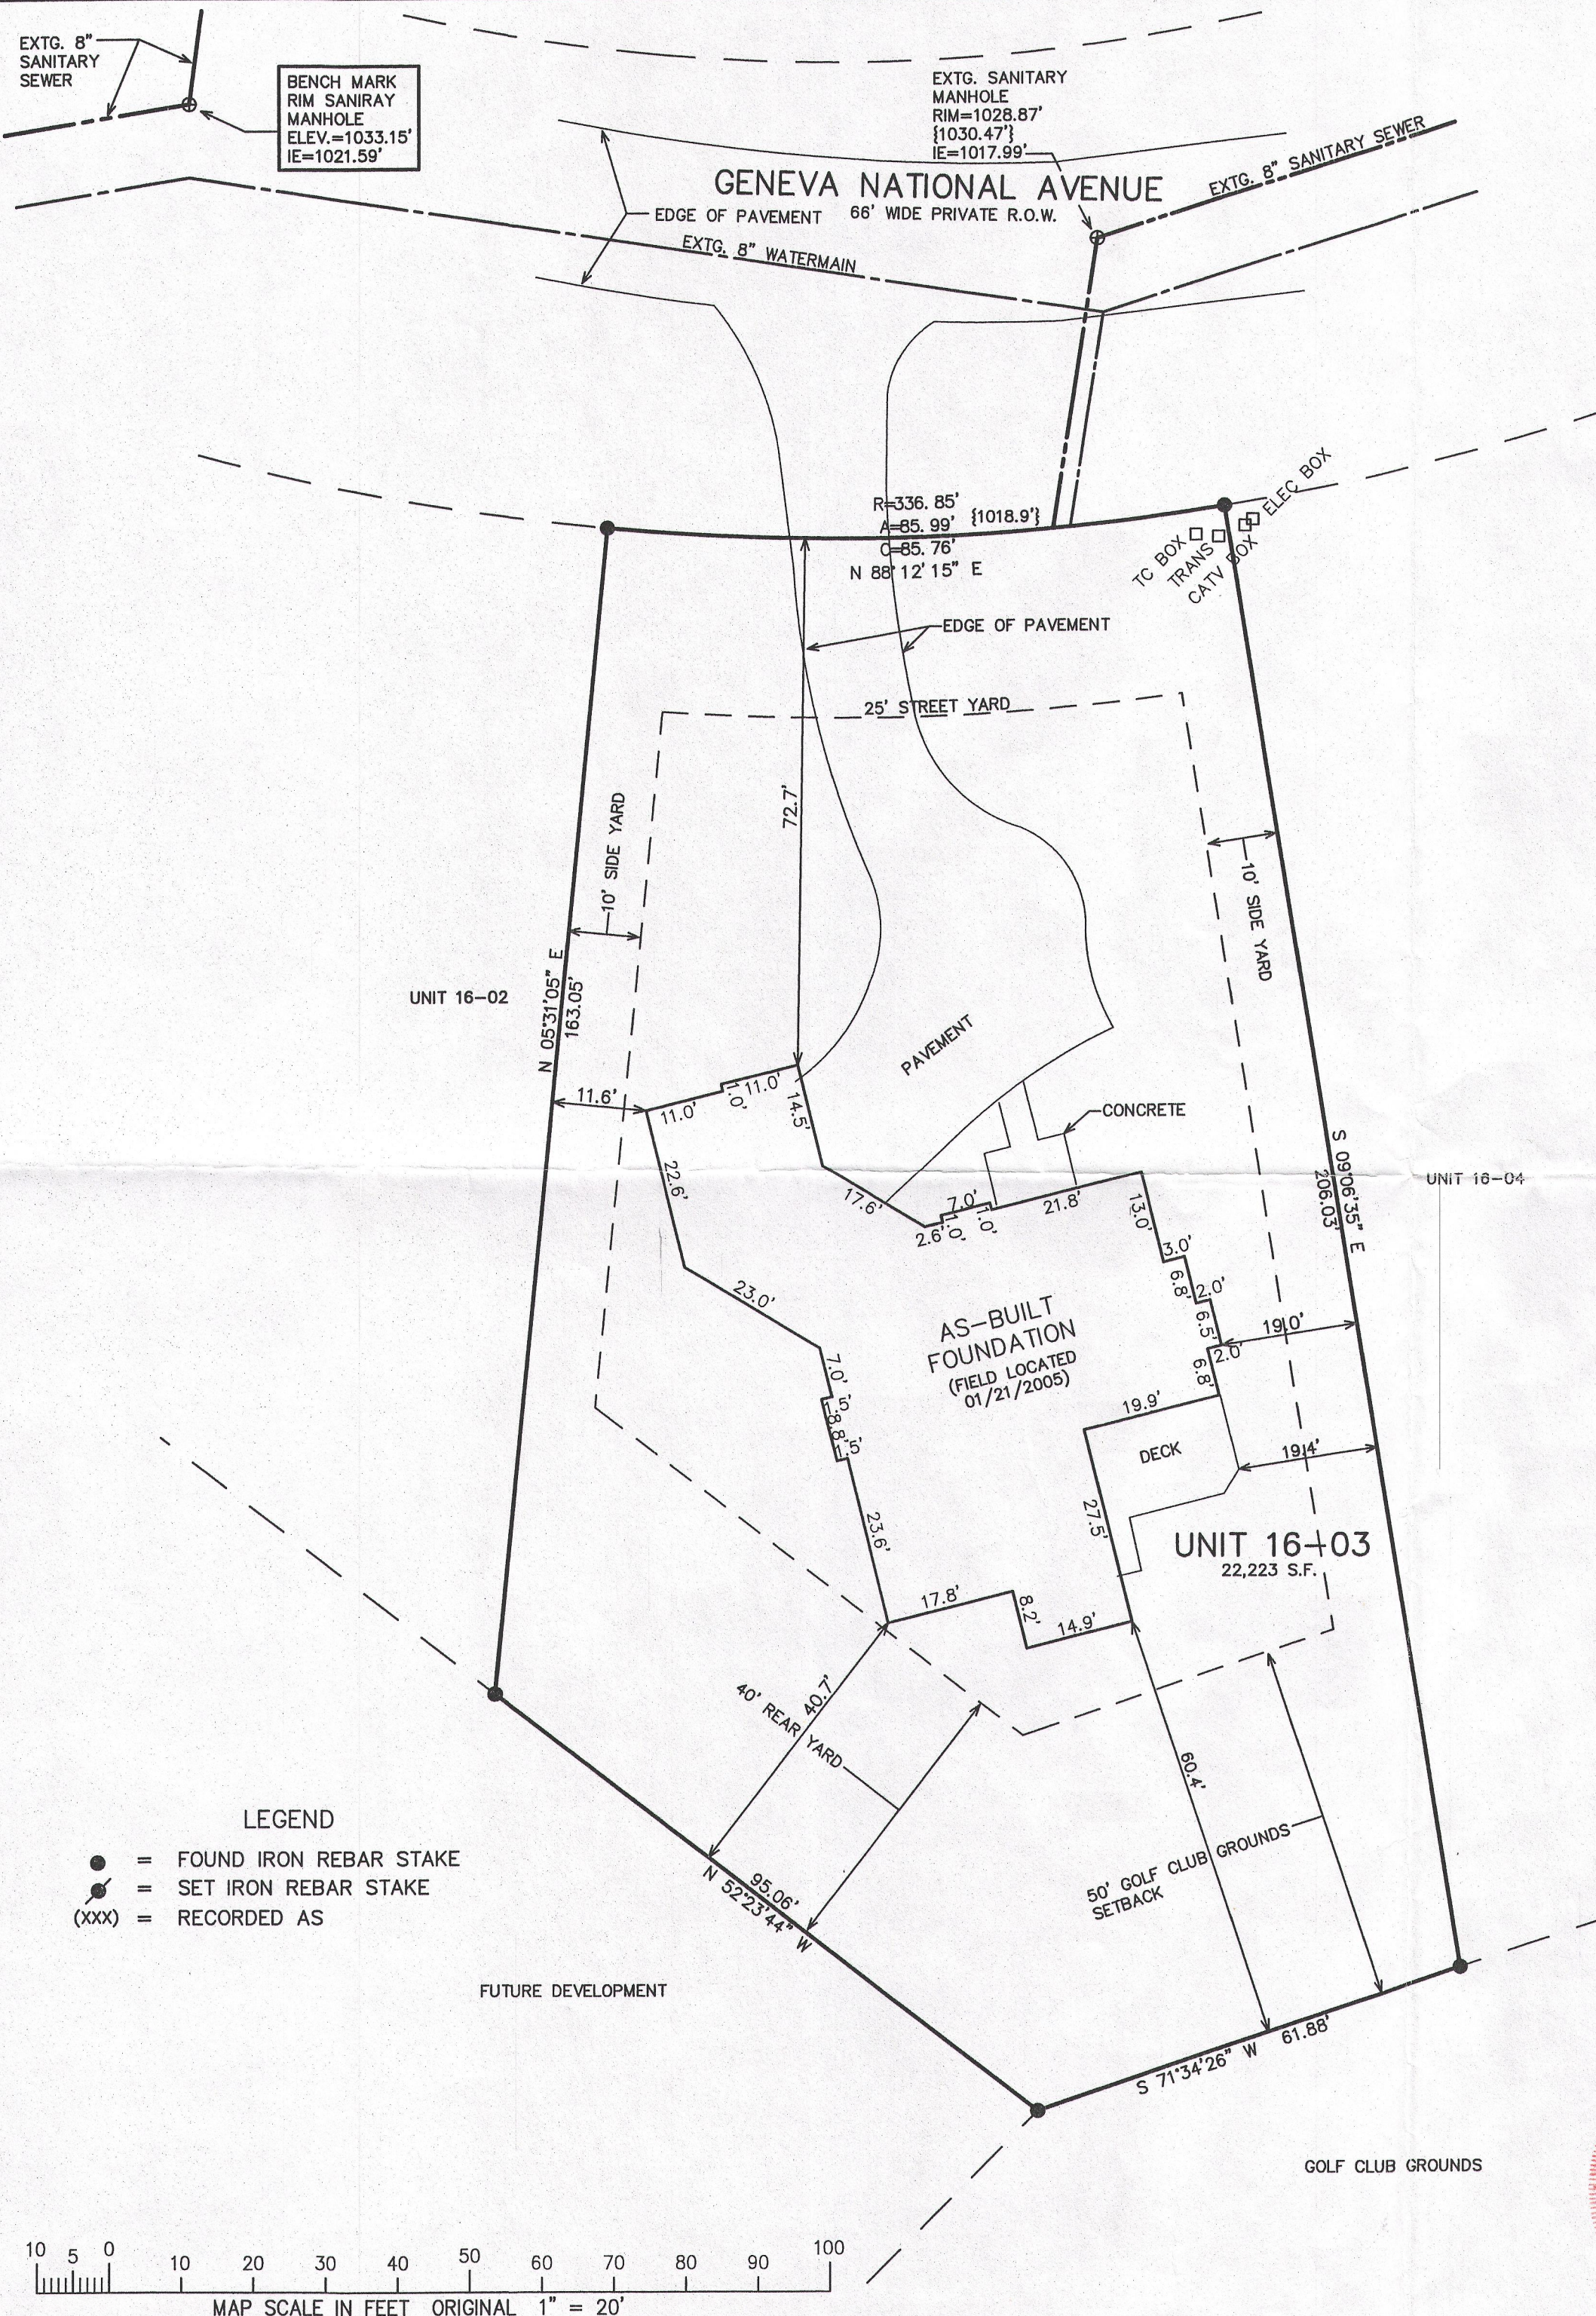

NOTE: COPIES OF THIS MAP TO WHICH THE FOLLOWING CERTIFICATE WILL APPLY SHOW SURVEYOR'S ORIGINAL SEAL AND SIGNATURE IN RED INK. COPIES BY ANY OTHER MEANS MAY HAVE ALTERATIONS WHICH DO NOT REPRESENT THE SURVEYOR'S WORK PRODUCT.


I HEREBY CERTIFY THAT THE ABOVE DESCRIBED PROPERTY HAS BEEN SURVEYED UNDER MY DIRECTION AND THAT THE ABOVE MAP IS A TRUE REPRESENTATION THEREOF AND SHOWS THE SIZE AND LOCATION OF THE PROPERTY, ITS EXTERIOR BOUNDARIES, THE LOCATION OF ALL VISIBLE STRUCTURES, AND DIMENSIONS OF ALL PRINCIPLE BUILDINGS THEREON, BOUNDARY FENCES, APPARENT EASEMENTS, ROADWAYS, AND VISIBLE ENCROACHMENTS, IF ANY. THIS SURVEY IS MADE FOR THE USE OF THE PRESENT OWNERS OF THE PROPERTY, AND ALSO THOSE WHO PURCHASE, MORTGAGE, OR GUARANTEE THE TITLE THERETO WITHIN ONE YEAR FROM THE DATE HEREOF.

RESURVEY 04-07-2006

DATED: JUNE 14, 2004

11-26-2014
RESURVEYED AND UPDATED

PETER S. GORDON R.L.S. 2101

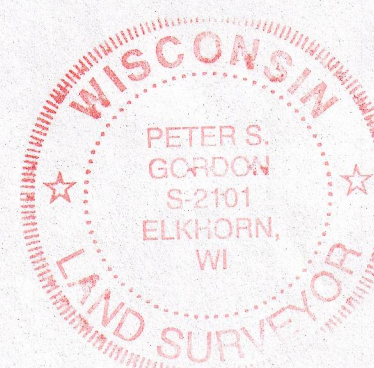

NOV 26 2014

JGN 16-3

217-4035