


HAROLD H. KOLB

REGISTERED PROFESSIONAL LAND SURVEYOR
LAKE GENEVA, WISCONSIN

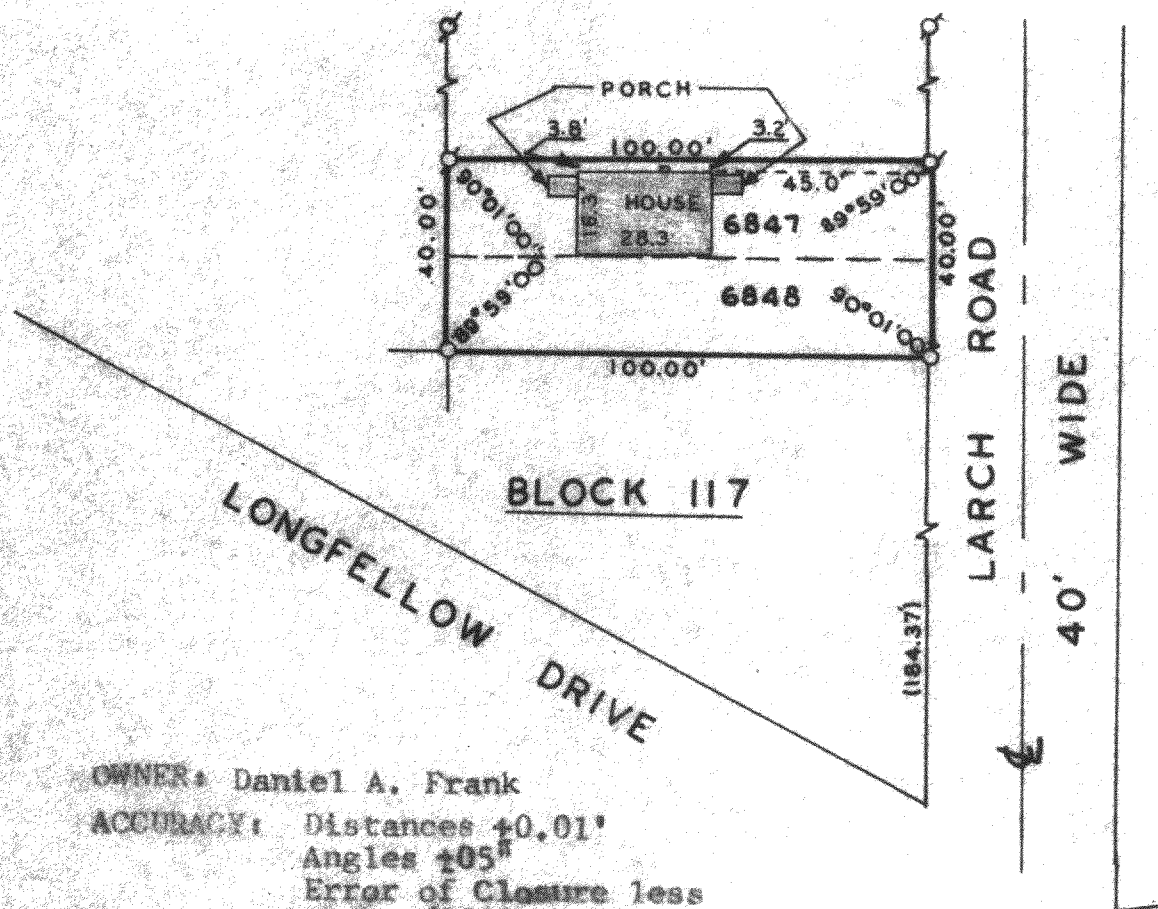

OWNER: Daniel A. Frank


ACCURACY: Distances $\pm 0.01'$
Angles $\pm 05''$
Error of Closure less
than $1/3000$



SCALE: 1" = 40'

LEGEND

- ◊ - IRON PIPE FOUND
- - IRON PIPE PLACED
- - CONCRETE MONUMENT
- x - SPIKE
- () - AS PLATTED

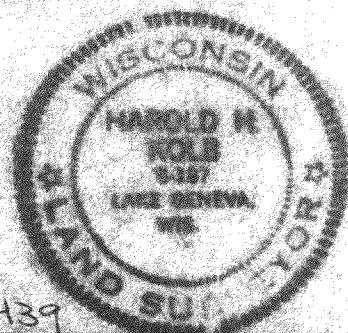

PLAT OF SURVEY OF

Lots 6847-6848, Block 117, Lake Como Beach
Subdivision, T 2 N, R 17 E, Walworth
County, Wisconsin..

I, HAROLD H. KOLB, DO HEREBY CERTIFY THAT I HAVE
SURVEYED THE PROPERTY HEREON DESCRIBED ACCORDING
TO THE OFFICIAL RECORDS, AND THAT THE PLAT HEREON
IS A CORRECT REPRESENTATION OF THE LOT LINES.

Harold H. Kolb

HAROLD H. KOLB
WISCONSIN REGISTERED LAND SURVEYOR, S-187
DATE July 9, 1974

JLCB-1439

217-405