


AMBIT LAND SURVEYING
8120-312th Avenue
Burlington, Wisconsin 53105-8934
Licensed Professionals in
both Illinois & Wisconsin

PLAT OF SURVEY
OF

PHONE: 262-537-4874
FAX: 262-537-4221
EMAIL: ambit@tds.net

Lots 9525, 9526, 9527, 9528 and 9529, Block 172, as designated and delineated on the map entitled FOURTH MAP OF LAKE COMO BEACH, Walworth County, Wisconsin, and recorded in the office of the Register of Deeds for and in Walworth County, Wisconsin on the 1st day of May 191926, being in the Town of Geneva, Walworth County, Wisconsin.


PARCEL IDENTIFICATION NO.: JLCB 02053

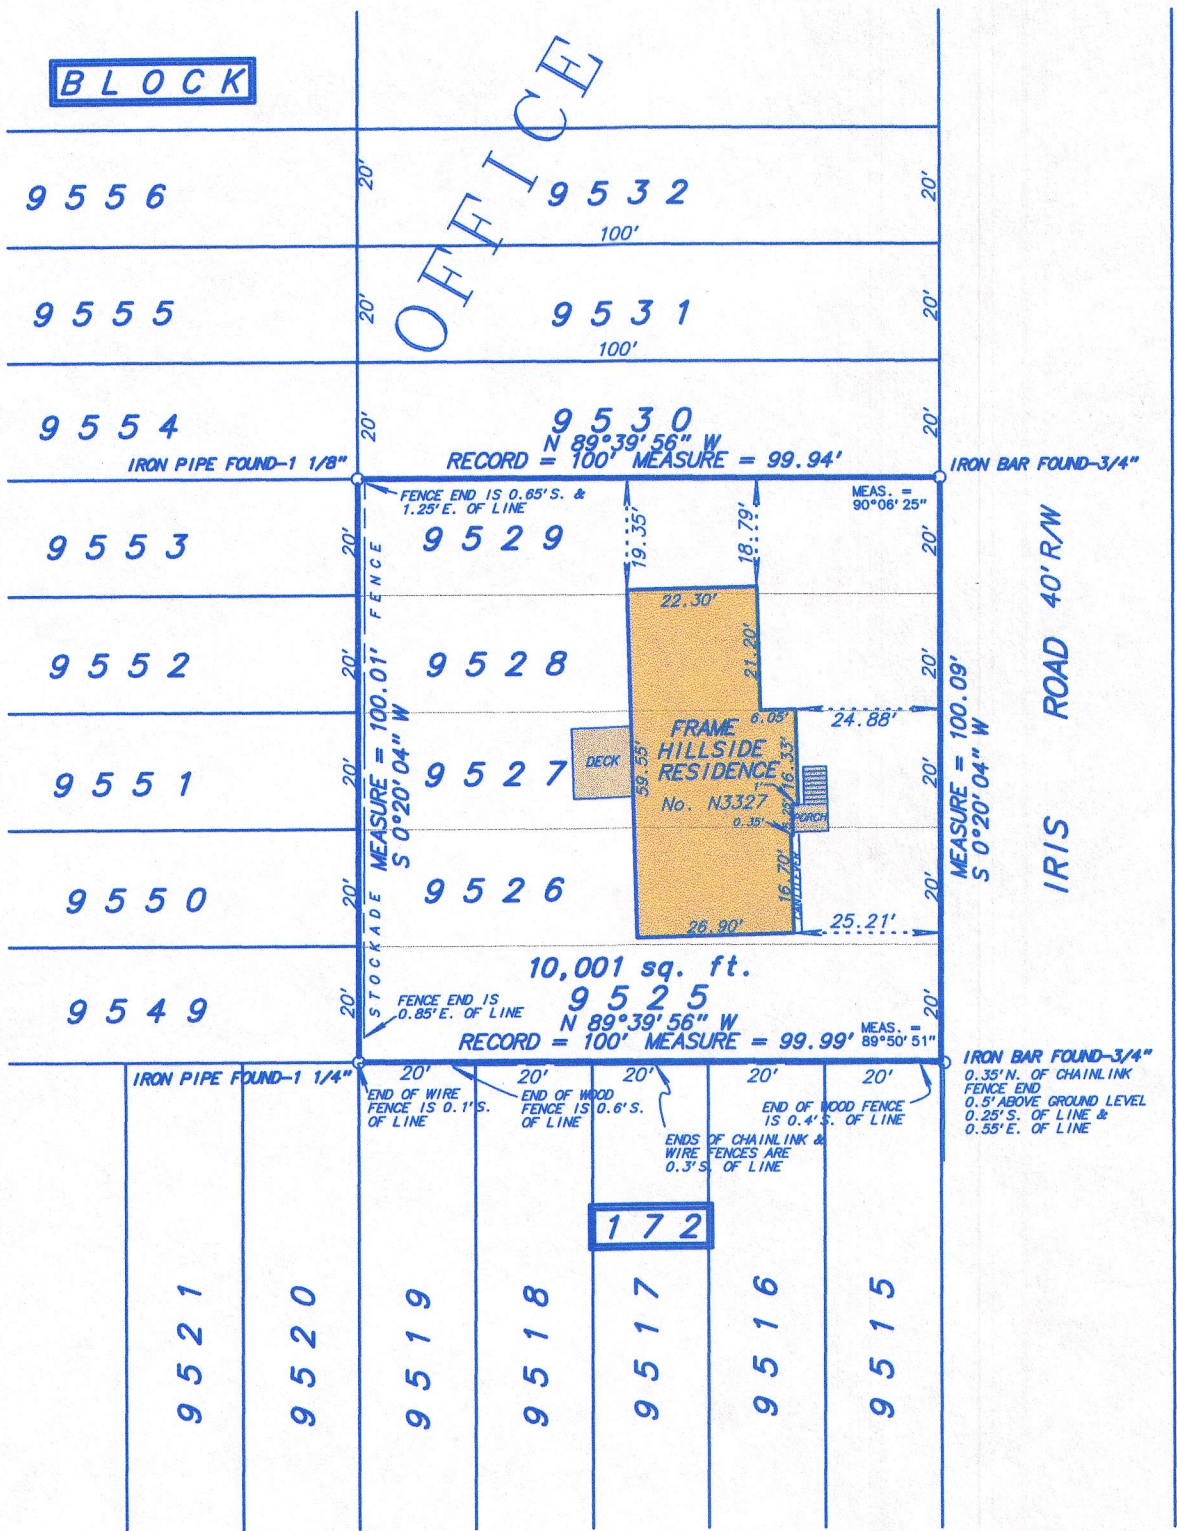

NOTE:


SE. CORNER OF LOT 9525, BLOCK 172 APPEARED TO HAVE BEEN DISTURBED. HEAVY SNOW COVER DEEMED IT DIFFICULT TO LOCATE THE SE. CORNER OF BLOCK 172. THEREFORE THE SE. CORNER OF SAID LOT 9525 WAS CALCULATED USING PREVIOUS SURVEYS BY ROBERT M. BAERENWALD (6/28/89), DOUGLAS G. OLSON (7/7/99) AND JOHN KROTT (7/2/2001).

DRIVEWAY AND PAVEMENT NOT SHOWN DUE TO HEAVY SNOW COVER

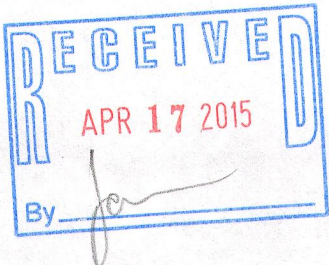

NOT TO SCALE
1 inch = 30 feet

SCALE: _____
ORDERED BY: J. Jelinek/ Attorney at Law
JOB NO.: 14019

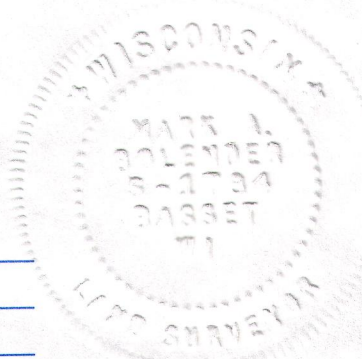

Fieldwork completed on and date of certification: March 5, 2014

I hereby certify that I have surveyed the above described property and the above plat is a true representation thereof and shows the size and location of the property, its exterior boundaries, the location and dimensions of all visible structures thereon, boundary fences, apparent easements and roadways and visible encroachments, if any.

This survey is made for the exclusive use of the present owners of the property, and also those who purchase, mortgage or guarantee the title thereto within ONE YEAR from the date hereof.

Dated at Bassett, Wisconsin this _____ day of _____ 2014.

Mark A. Bolender
Wisconsin Professional Land Surveyor 1784

JLCB -2053 217-4057