

Plat of Survey


of

Lots 17, 18, 19 and 20 in Block 26 of Sunset Hills (Unit "B"),



a subdivision located in the Southwest 1/4 of Section 33,
Town 2 North, Range 17 East, Town of Geneva,
Walworth County, Wisconsin.

Surveyed for: **Lillig & Thorsness, Ltd.**

1900 Spring Road, Suite 200
Oak Brook, Illinois, 60523

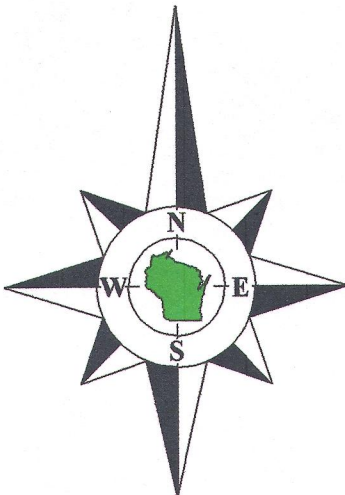

Bearings referenced to the
plat of Sunset Hills.

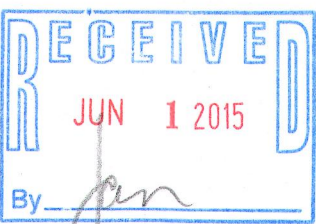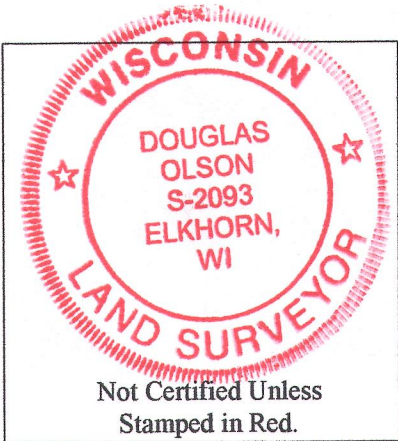

Notes:

- 1) This survey plat is not certified unless signed and sealed in red ink.
- 2) This survey is subject to Wisconsin lien laws. This Plat of Survey is the notice of intent to file lien. Lien waiver required.


Copyright 2014 by Jensen & Olson Land Surveying, LLC.

All rights reserved. No part of this survey plat may be reproduced or transmitted in any form by any means - graphic, electronic, or mechanical, including photocopying, tracing, or information storage and retrieval systems - without permission in writing from Douglas G. Olson, Jensen & Olson Land Surveying, LLC.

I hereby certify that I have surveyed the above described property and the map hereon is correct to the best of my professional knowledge and belief and shows the size and location of the property, its exterior boundaries, the location and dimensions of all visible structures thereon, boundary fences, apparent easements and roadways and visible encroachments, if any.

This survey is made for the exclusive use of the present owners of the property, and also those who purchase, mortgage or guarantee title thereto, within one year from the date hereof.

Douglas G. Olson
Wisconsin Registered Land Surveyor - 2093

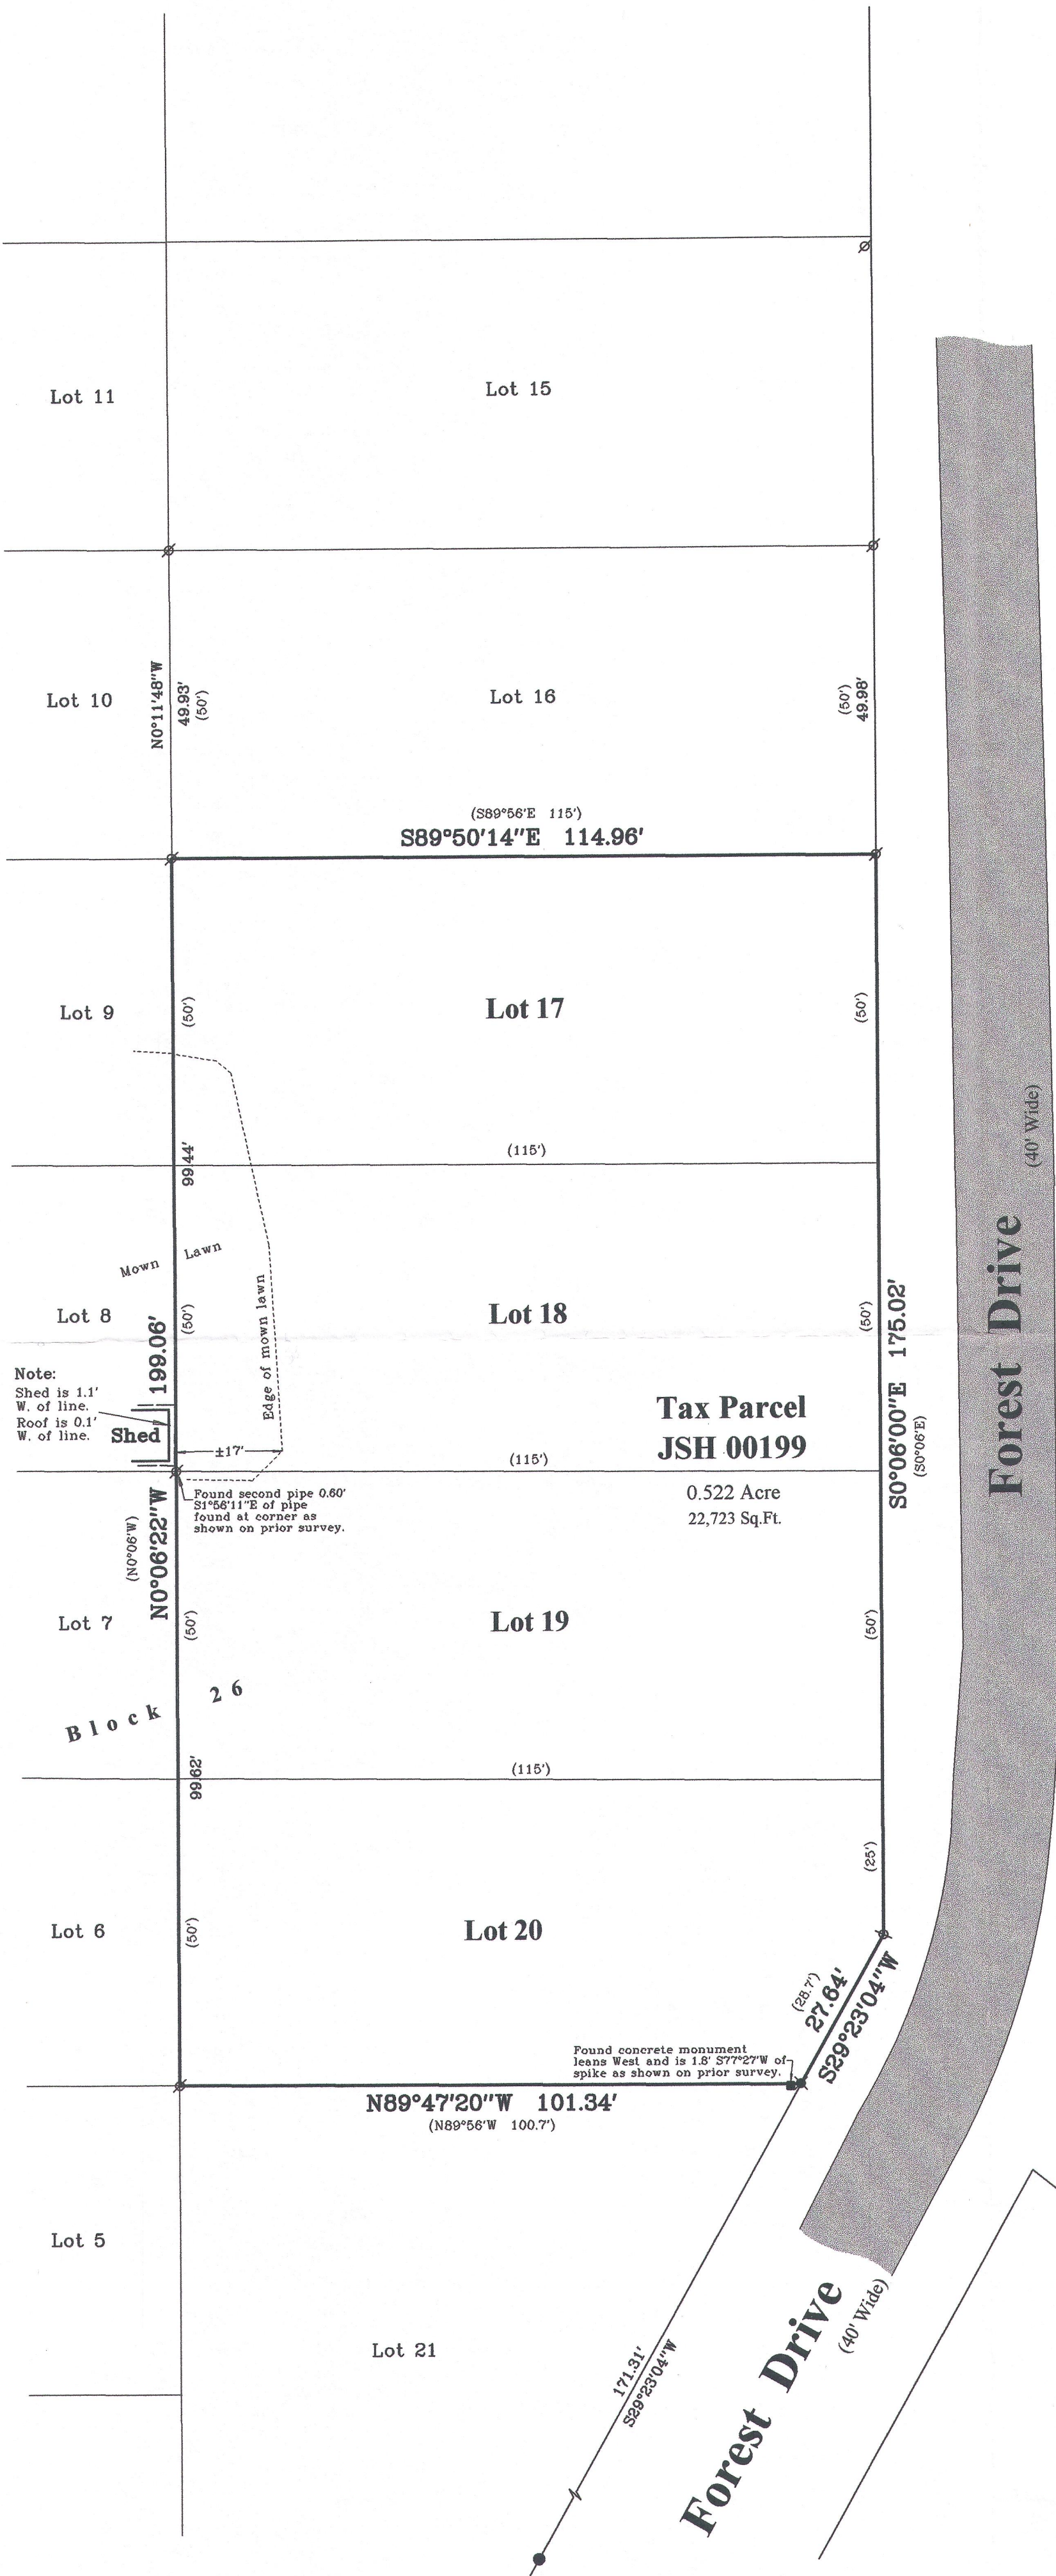

2014.057 Sheet 1 of 1 Sheets Drawing Name: t2n17e-2014057-2014057Plat.scj Job Reference Number 2014.057	Legend Found Concrete Monument Found Iron Pipe Found Iron Rod Found Posey Pin Found Spike Set Iron Pipe, 1" dia. Recorded Information Asphalt Surface	Jensen & Olson Land Surveying, LLC 45 South Wisconsin Street * P.O. Box 322 * Elkhorn, Wisconsin. 53121 Telephone: (262) 723-3434 * Facsimile: (262) 723-8044 Email: jensen.olson@elknet.net	Scale in Feet 1" = 20' 0' 10' 20' 40'	Survey Date: June 28, 2014. Revisions:
--	--	---	--	--

JSH-199
JSH-199A 217-4077