


APR 25 2013

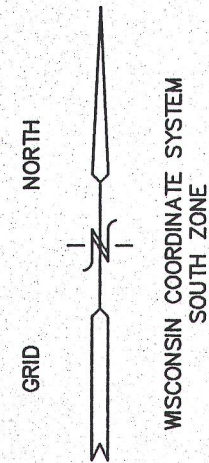

UNIT 15-15

UNIT 15-13




UNIT 15-12
27,662 S.F.

UNIT 15-11

PLAT OF SURVEY

UNIT 15-12
GENEVA NATIONAL CONDOMINIUM
NO. 15
LOCATED IN TOWN 2 NORTH, RANGE 17 EAST
WALWORTH COUNTY, WISCONSIN

● = FOUND IRON REBAR STAKE
● = SET IRON REBAR STAKE
(xxx) = RECORDED AS

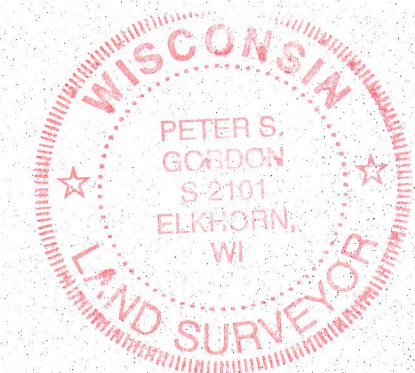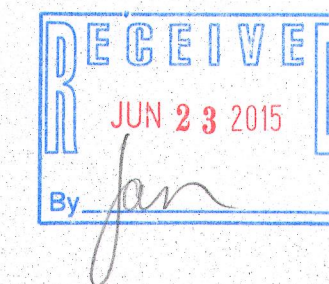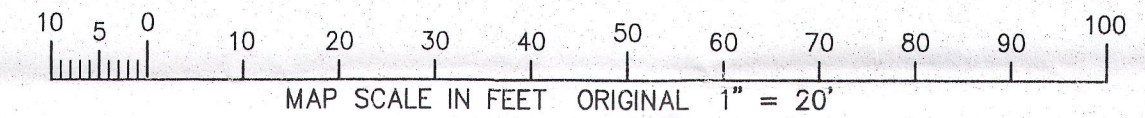


NOTE: COPIES OF THIS MAP TO WHICH THE FOLLOWING CERTIFICATE WILL APPLY SHOW SURVEYOR'S ORIGINAL SEAL AND SIGNATURE IN RED INK. COPIES BY ANY OTHER MEANS MAY HAVE ALTERATIONS WHICH DO NOT REPRESENT THE SURVEYOR'S WORK PRODUCT.

I HEREBY CERTIFY THAT THE ABOVE DESCRIBED PROPERTY HAS BEEN SURVEYED UNDER MY DIRECTION AND THAT THE ABOVE MAP IS A TRUE REPRESENTATION THEREOF AND SHOWS THE SIZE AND LOCATION OF THE PROPERTY AND ITS EXTERIOR BOUNDARIES. THIS SURVEY IS MADE FOR THE USE OF THE PRESENT OWNERS OF THE PROPERTY, AND ALSO THOSE WHO PURCHASE, MORTGAGE, OR GUARANTEE THE TITLE THERETO WITHIN ONE YEAR FROM THE DATE HEREOF.

DATED: MAY 1, 2001
PETER S. GORDON R.L.S. 2101

REVISED: 9/30/2014-KB
SITE, GRADIN, DRAINAGE &
EROSION CONTROL PLAN
REVISED: 12/1/2014-KB
TO ADJUST RESIDENCE LOCATION
REVISED: 12/5/2014-KB
TO ADJUST SETBACK NOTE
REVISED 04-27-2015
TO SHOW AS BUILT RESIDENCE

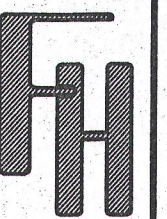

WEMBER RESIDENCE

WORK ORDERED BY
SUNRISE HOMES
PO BOX 1357
LAKE GENEVA, WI 53147

FARRIS, HANSEN & ASSOCIATES, INC.
Engineering, Architecture, Surveying
7 Ridgway Court P.O. Box 437
ELKHORN, WISCONSIN 53121
Office: (262) 723-2098
Fax: (262) 723-5886

REVISIONS

PROJECT NO.
3269-15-12.14.01
DATE:
04-04-01
SHEET NO.
1 OF 1

JGN 15-12

217-4081