


GEORGE T. DUNHAM
SURVEYING & SUBDIVIDING
DELAVAN, WISCONSIN

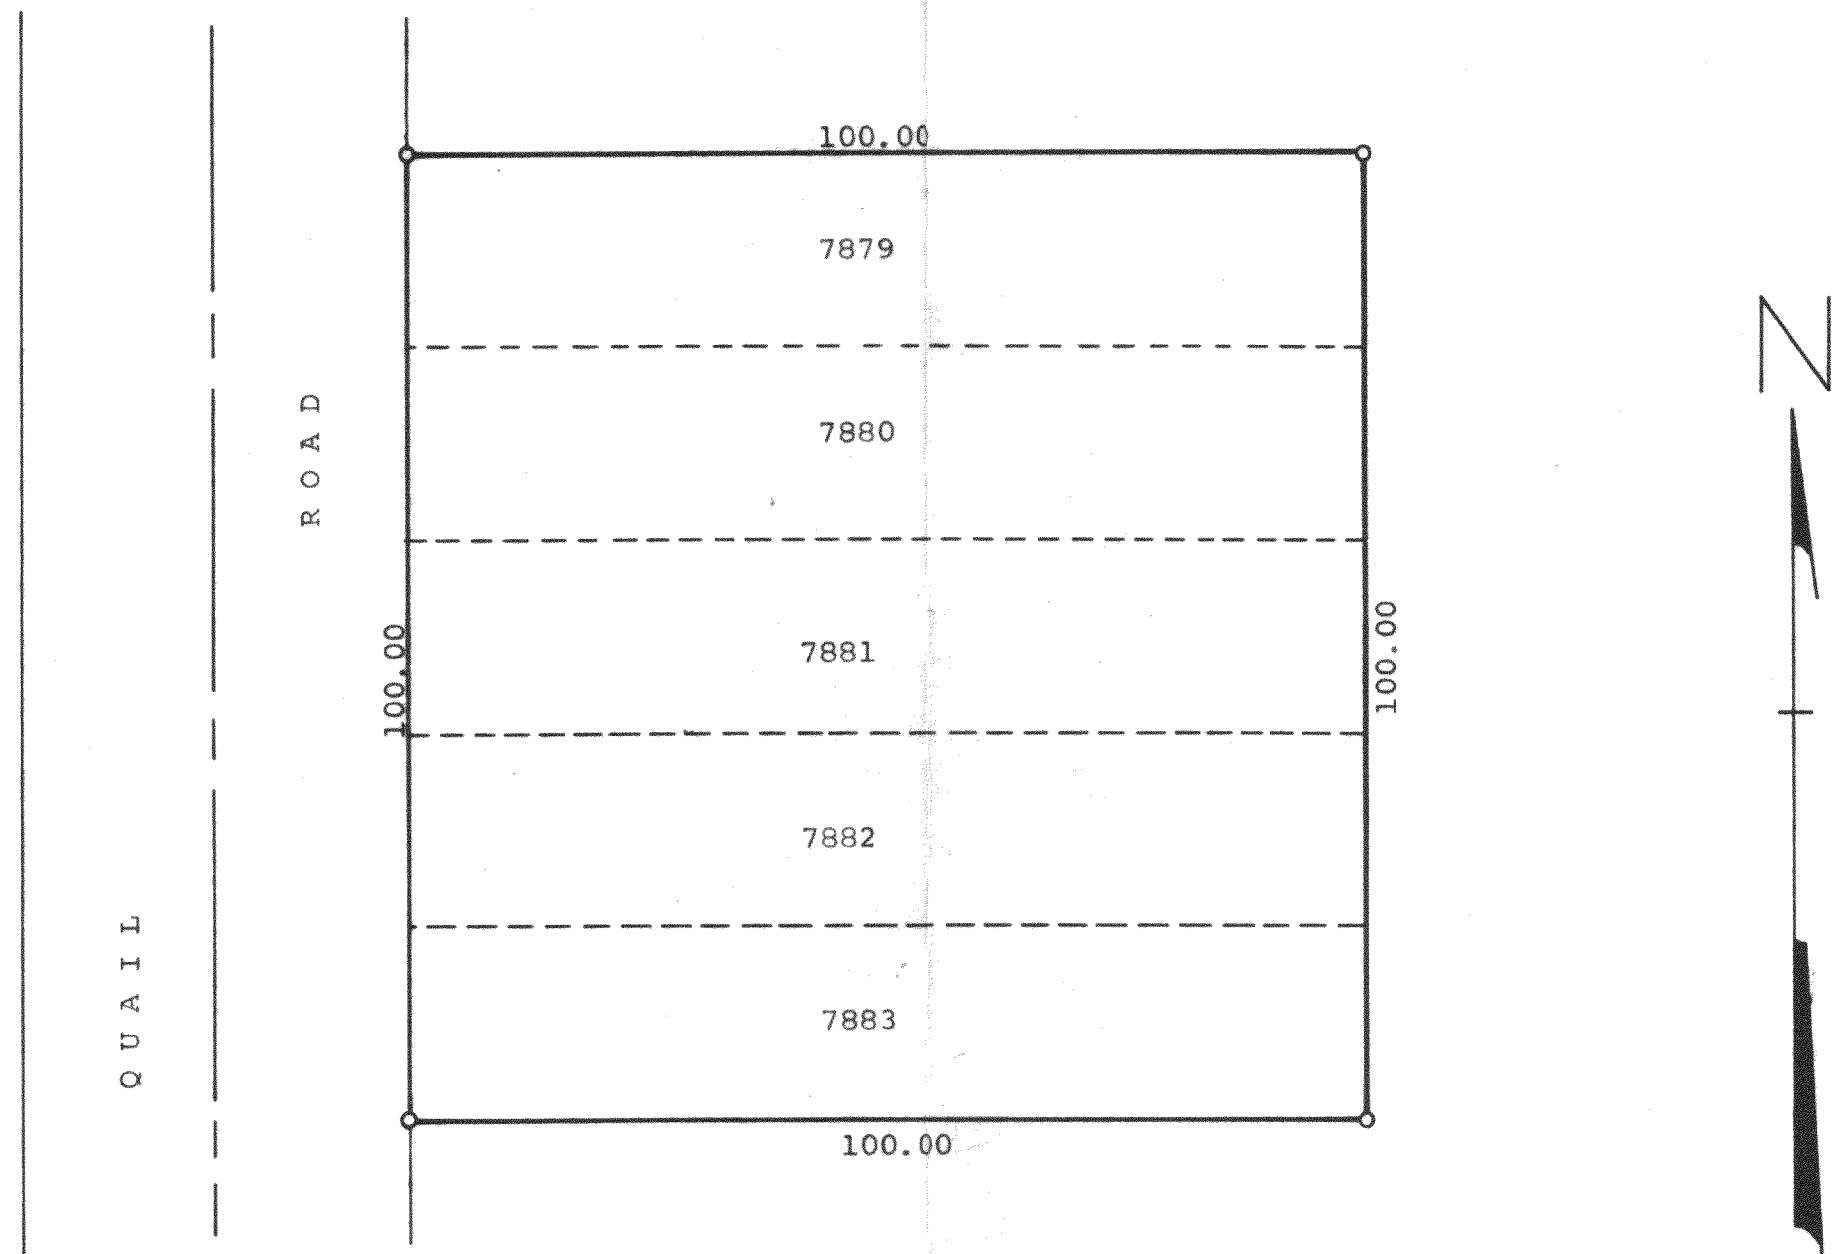

Scale - 1" = 20'
O = Iron Pipe

Plat of survey of Lots 7879-7883 inclusive of Lake
Como Beach Subdivision located in Section 28,
T2N, R17E, Walworth County, Wisconsin.
October 24, 1974

George T. Dunham
George T. Dunham, Surveyor

