

PLAT OF SURVEY

-OF-

UNIT 19-21 IN GENEVA NATIONAL CONDOMINIUM NO. 19, BEING A CONDOMINIUM CREATED UNDER THE CONDOMINIUM OWNERSHIP ACT OF THE STATE OF WISCONSIN BY A "DECLARATION OF CONDOMINIUM FOR GENEVA NATIONAL CONDOMINIUM NO. 19 CONDOMINIUM", DATED THE 22ND DAY OF MAY, 1990 AND RECORDED THE 31ST DAY OF MAY, 1990, IN THE OFFICE OF THE REGISTER OF DEEDS FOR WALWORTH COUNTY, WISCONSIN, IN VOLUME 488 OF RECORDS, AT PAGES 300 THROUGH 347 AS DOCUMENT NO. 194854 AND BY A CONDOMINIUM PLAT THEREFOR. SAID LAND BEING IN THE TOWN OF GENEVA, COUNTY OF WALWORTH AND STATE OF WISCONSIN.

SURVEY FOR: DEBBIE SCHROEDER OF KEEFE REAL ESTATE
 SURVEY ADDRESS: 1351 ST. ANDREWS ROAD, LAKE GENEVA, WI 53147

NOTE: REFER TO A CURRENT TITLE REPORT FOR EASEMENTS, RESTRICTIONS OR COVENANTS WHICH MAY AFFECT THIS PROPERTY.


CURVE DATA

C1

RADIUS = 692.00'
 CENTRAL ANGLE = 05°27'41" (05°27'10")
 CHORD = 65.94' (65.83')
 CHORD BEARING = S26°43'51"E (S26°40'30"E)




C1

RADIUS = 55.00'
 CENTRAL ANGLE = 58°03'02" (57°55'12")
 CHORD = 53.37' (53.26')
 CHORD BEARING = S01°58'02"W (S02°01'20"W)

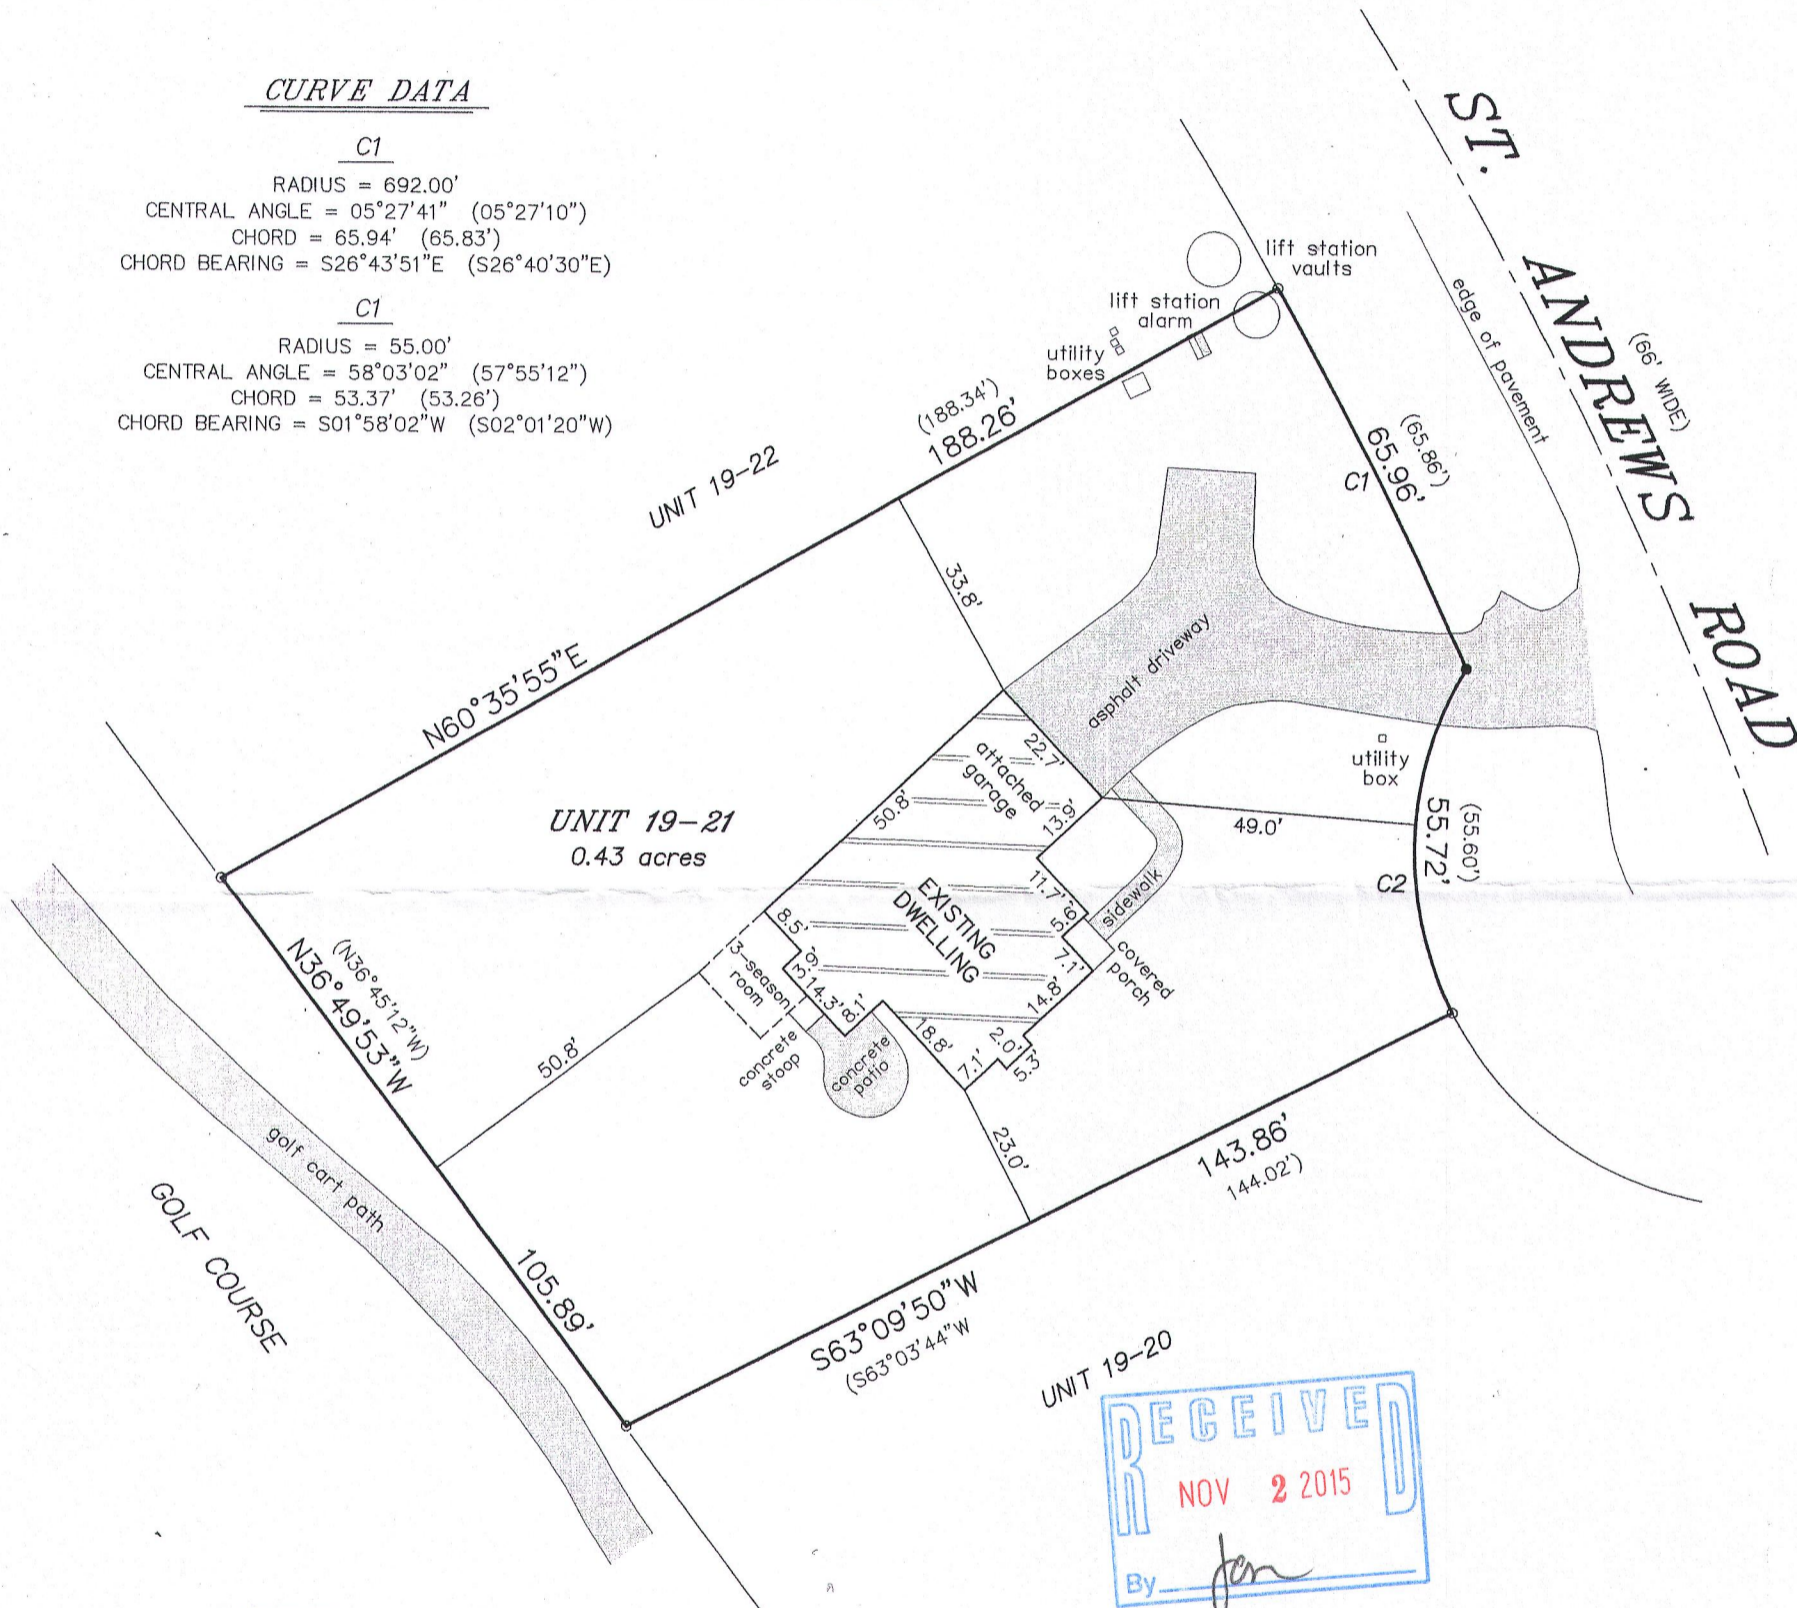

- LEGEND
- FOUND IRON ROD
 - SET MASONRY NAIL
 - () RECORDED AS


BEARINGS HEREON RELATE TO THE NORTH LINE OF UNIT 19-21. ASSUMED BEARING OF NORTH 60°35'55" EAST AS PLATTED.

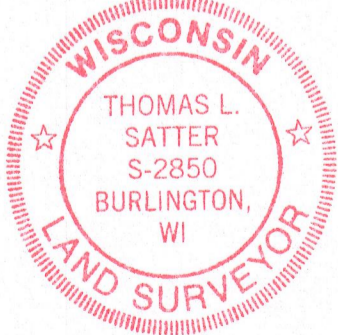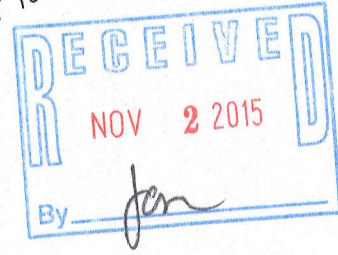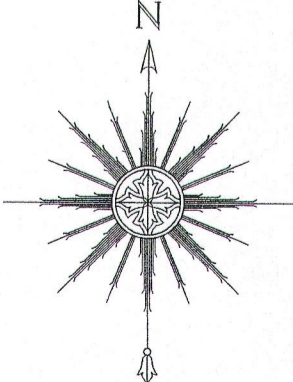

THIS IS NOT AN ORIGINAL PRINT UNLESS THIS SEAL IS RED.

Thomas L. Satter
 THOMAS L. SATTER S-2850

SATTER SURVEYING, LLC
 LAND SURVEYS, MAPPING AND PLANNING
 272 ORIGIN STREET
 BURLINGTON, WI 53105
 262-661-4239

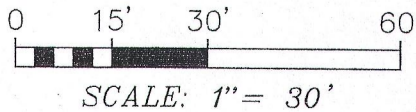

OCTOBER 2, 2015 091511
 DATE JOB NUMBER