

HAROLD H. KOLB

REGISTERED PROFESSIONAL LAND SURVEYOR
LAKE GENEVA, WISCONSIN



PLAT OF SURVEY OF

Lots 2156-2159, Block 35, Lake
Como Beach Subdivision, T 2 N,
R 17 E, Walworth County, Wisconsin.

Owner: Raymond Amundson

Accuracy: Distances: $\pm 0.01'$
Angles: $\pm 05''$

Error of Closure Less than $1/3000$

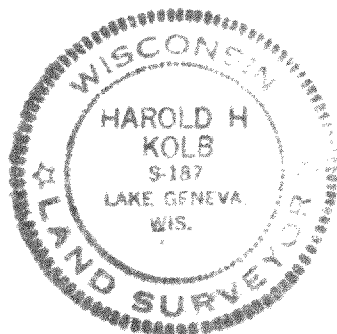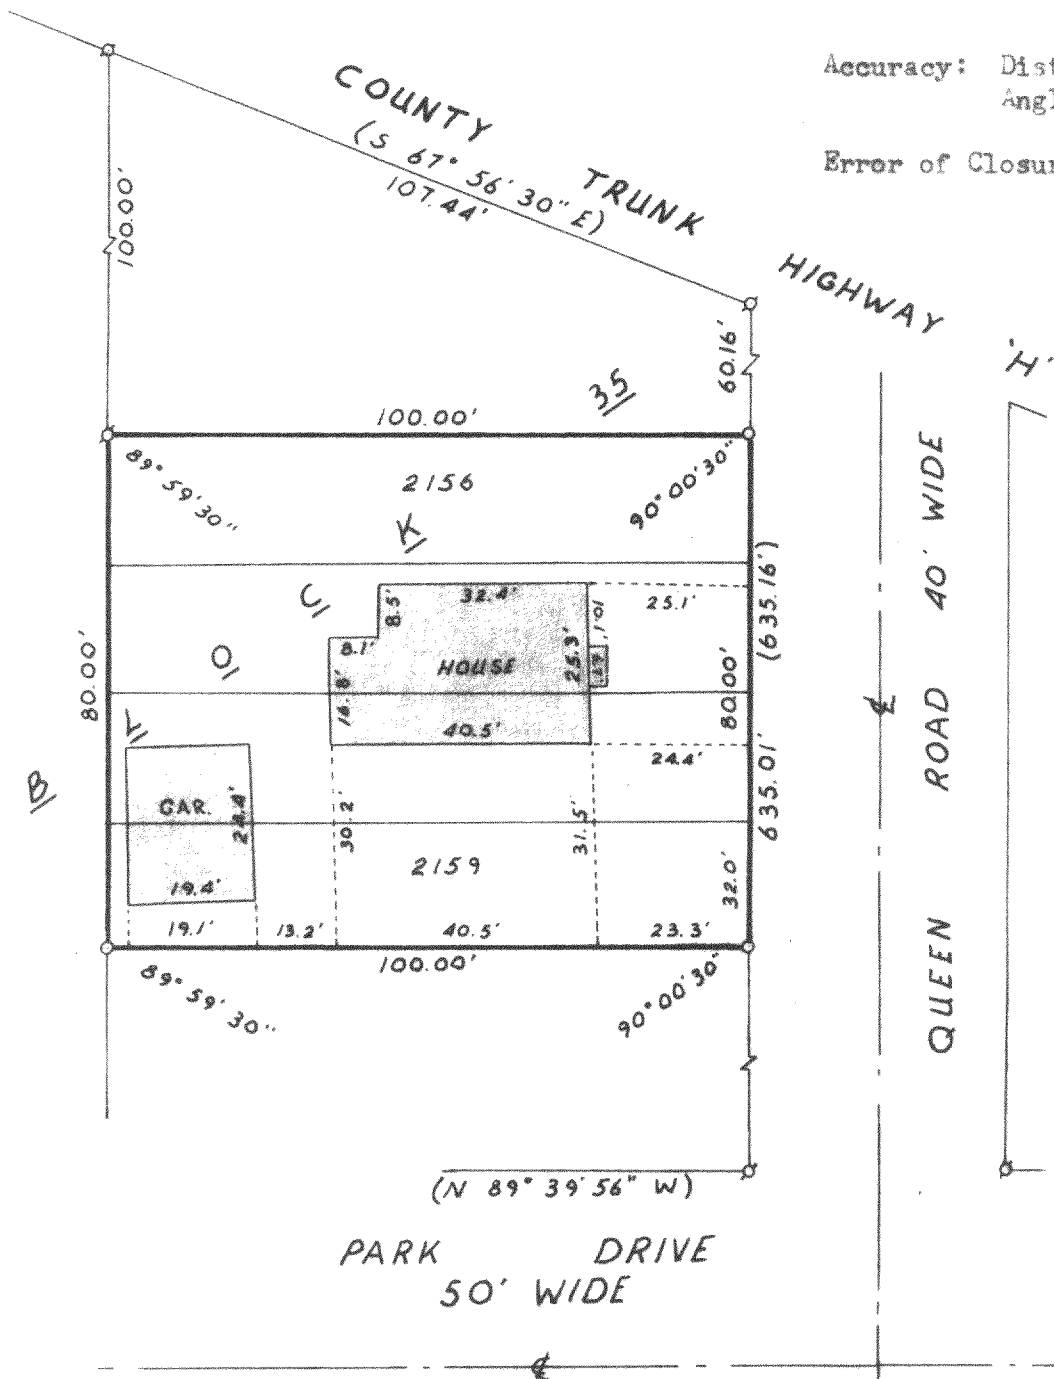

N



SCALE: 1" = 30'

LEGEND

- O — IRON PIPE PLACED.
- — CONCRETE MONUMENT, 5" DIA. x 30"
- σ — IRON PIPE FOUND
- () — AS PLATTED

Harold H. Kolb

HAROLD H. KOLB
WISCONSIN REGISTERED LAND SURVEYOR, S-187

DATE Sept. 27, 1974

217-417