


BOUNDARY SURVEY

LOTS 14 & 15 OF BLOCK 24 SUNSET HILLS SUBDIVISION


PART OF THE NE 1/4 OF THE SW 1/4 SECTION 33
TOWN 2 NORTH, RANGE 17 EAST
WALWORTH COUNTY, WISCONSIN

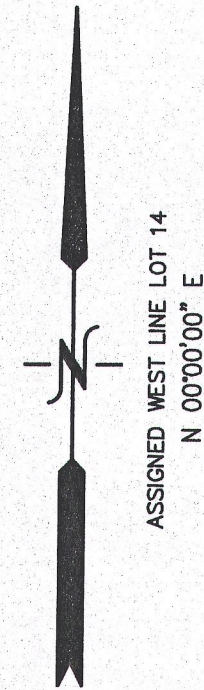


BENCH MARK
NAIL IN SIDE
POWER POLE
ELEV. = 1012.64'

KELLY ROAD (60' WIDE ROW)

EXTG. 12" CMP

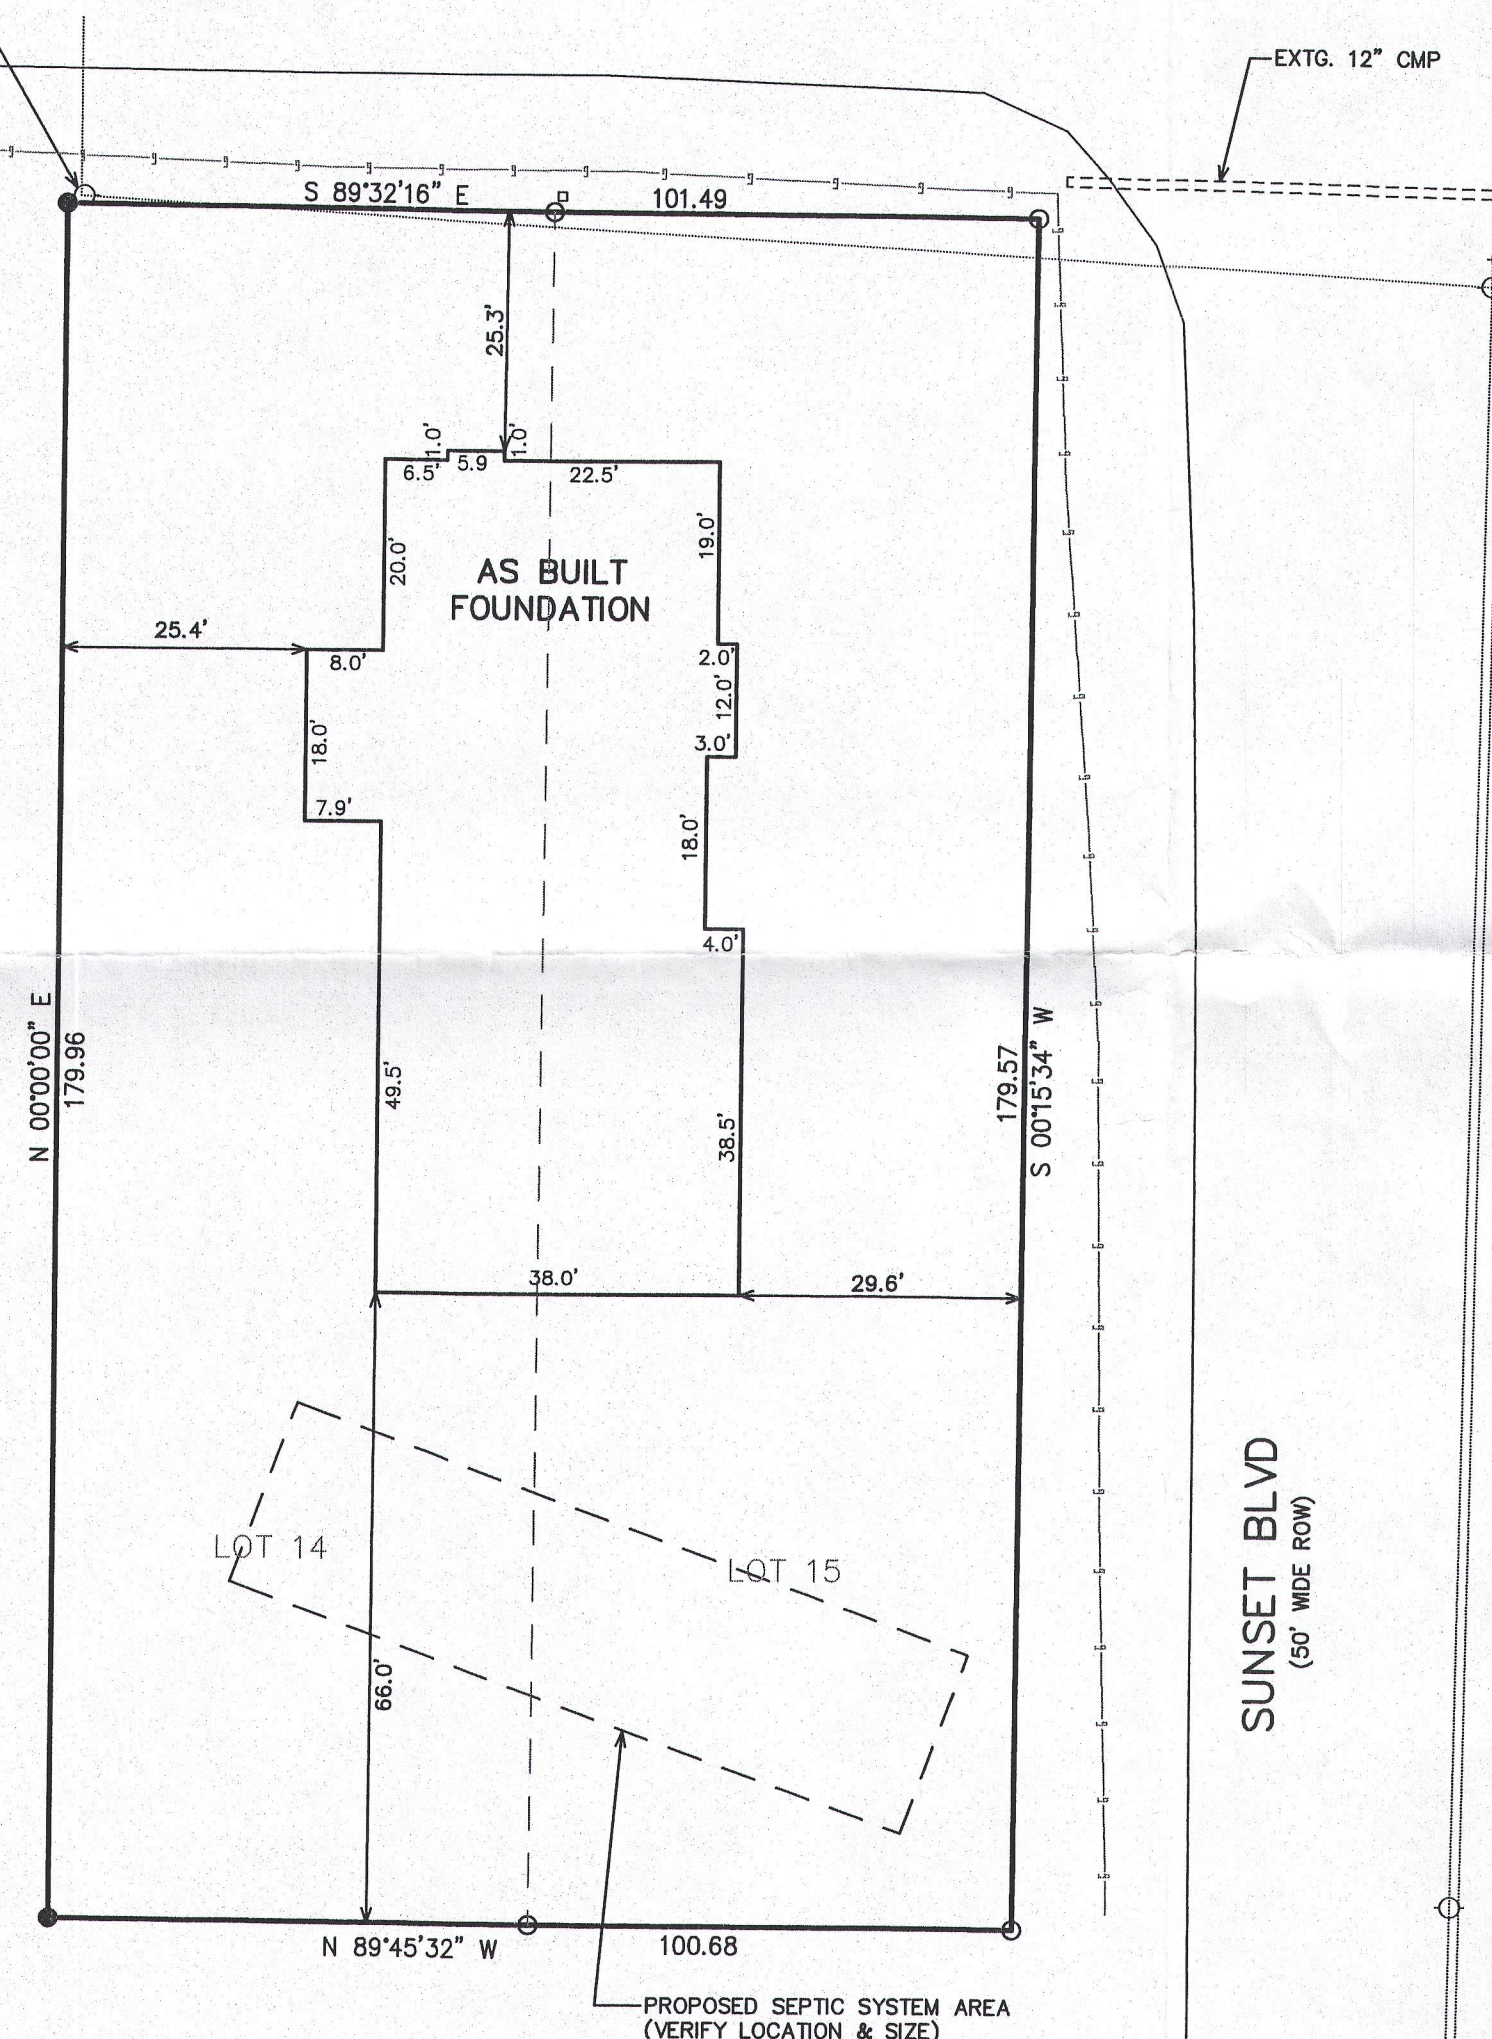

LEGEND
○ = FOUND IRON PIPE STAKE
● = FOUND IRON REBAR STAKE
(XXX) = RECORDED AS

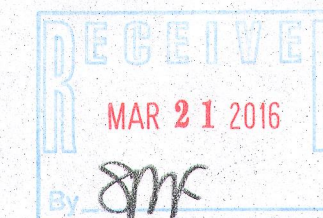


NOTE: COPIES OF THIS MAP TO WHICH THE FOLLOWING CERTIFICATE WILL APPLY SHOW THE SURVEYOR'S ORIGINAL SEAL AND SIGNATURE IN RED INK. COPIES BY ANY OTHER MEANS MAY HAVE ALTERATIONS WHICH DO NOT REPRESENT THE SURVEYOR'S WORK PRODUCT.

I HEREBY CERTIFY THAT THE ABOVE DESCRIBED PROPERTY HAS BEEN SURVEYED UNDER MY DIRECTION AND THAT THE ABOVE MAP IS A TRUE REPRESENTATION THEREOF AND SHOWS THE SIZE AND LOCATION OF THE PROPERTY AND ITS EXTERIOR BOUNDARIES. THIS SURVEY IS MADE FOR THE USE OF THE PRESENT OWNERS OF THE PROPERTY, AND ALSO THOSE WHO PURCHASE, MORTGAGE, OR GUARANTEE THE TITLE THERETO WITHIN ONE YEAR FROM THE DATE HEREOF.


DATE: SEPTEMBER 23, 2015

REVISED 11/20/2015-KB
ADJUST LOCATION OF PROPOSED
RESIDENCE

PETER S. GORDON P.L.S. 2101

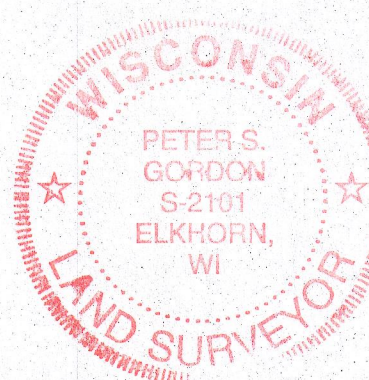

REVISED 12-30-2015
TO SHOW SIZE & LOCATION OF
AS BUILT FOUNDATION

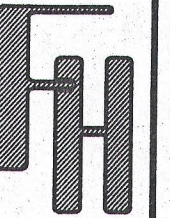

WORK ORDERED BY:
GENEVA BAY CONSTRUCTION
262 CENTER STREET
LAKE GENEVA, WI. 53147

FARRIS, HANSEN & ASSOCIATES, INC.
ENGINEERING - ARCHITECTURE - SURVEYING
7 RIDGWAY COURT P.O. BOX 437
ELKHORN, WISCONSIN 53121
OFFICE: (262) 723-2098 FAX: (262) 723-5886

REVISIONS

PROJECT NO.
9374
DATE:
09-23-2015
SHEET NO.
1 OF 1

DEC 30 2015

12/30/2015 X:\Projects\9374\DCAD\rebuild

MAP SCALE IN FEET ORIGINAL 1" = 20'

JSH-166 JSH-167

217 4179