



LAND-MARK SURVEYING
Mark L. Miritz
Wisconsin Professional Land Surveyor S-2582

N9330 Knuteson Drive
Whitewater, WI 53190
Phone: (262) 495-3284
MARKMIRITZ@
LAND-MARKSURVEYING.COM

OWNER: BASSO BUILDERS, INC.
495 SKYLINE DRIVE
LAKE GENEVA, WI 53147

PLAT OF SURVEY

LOTS 9182 THROUGH 9186, BOTH INCLUSIVE IN BLOCK 165, FOURTH
MAP OF LAKE COMO BEACH SUBDIVISION, LOCATED IN THE SOUTH-
EAST 1/4 OF SECTION 21, TOWN 2 NORTH, RANGE 17 EAST, GENEVA
TOWNSHIP, WALWORTH COUNTY, WISCONSIN.

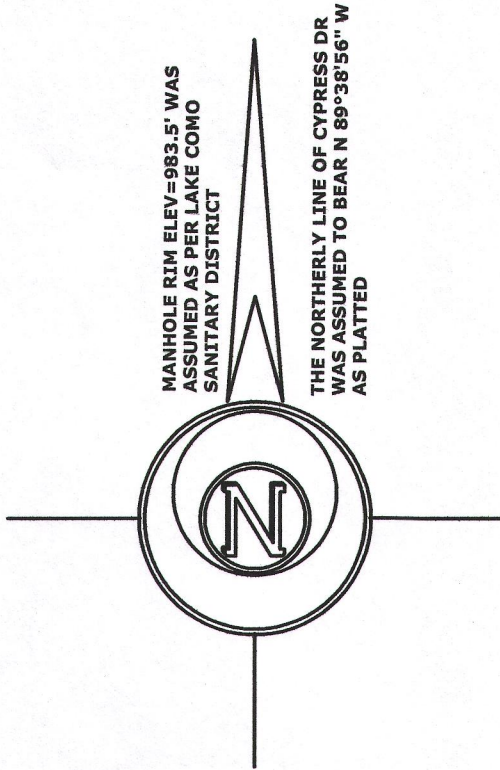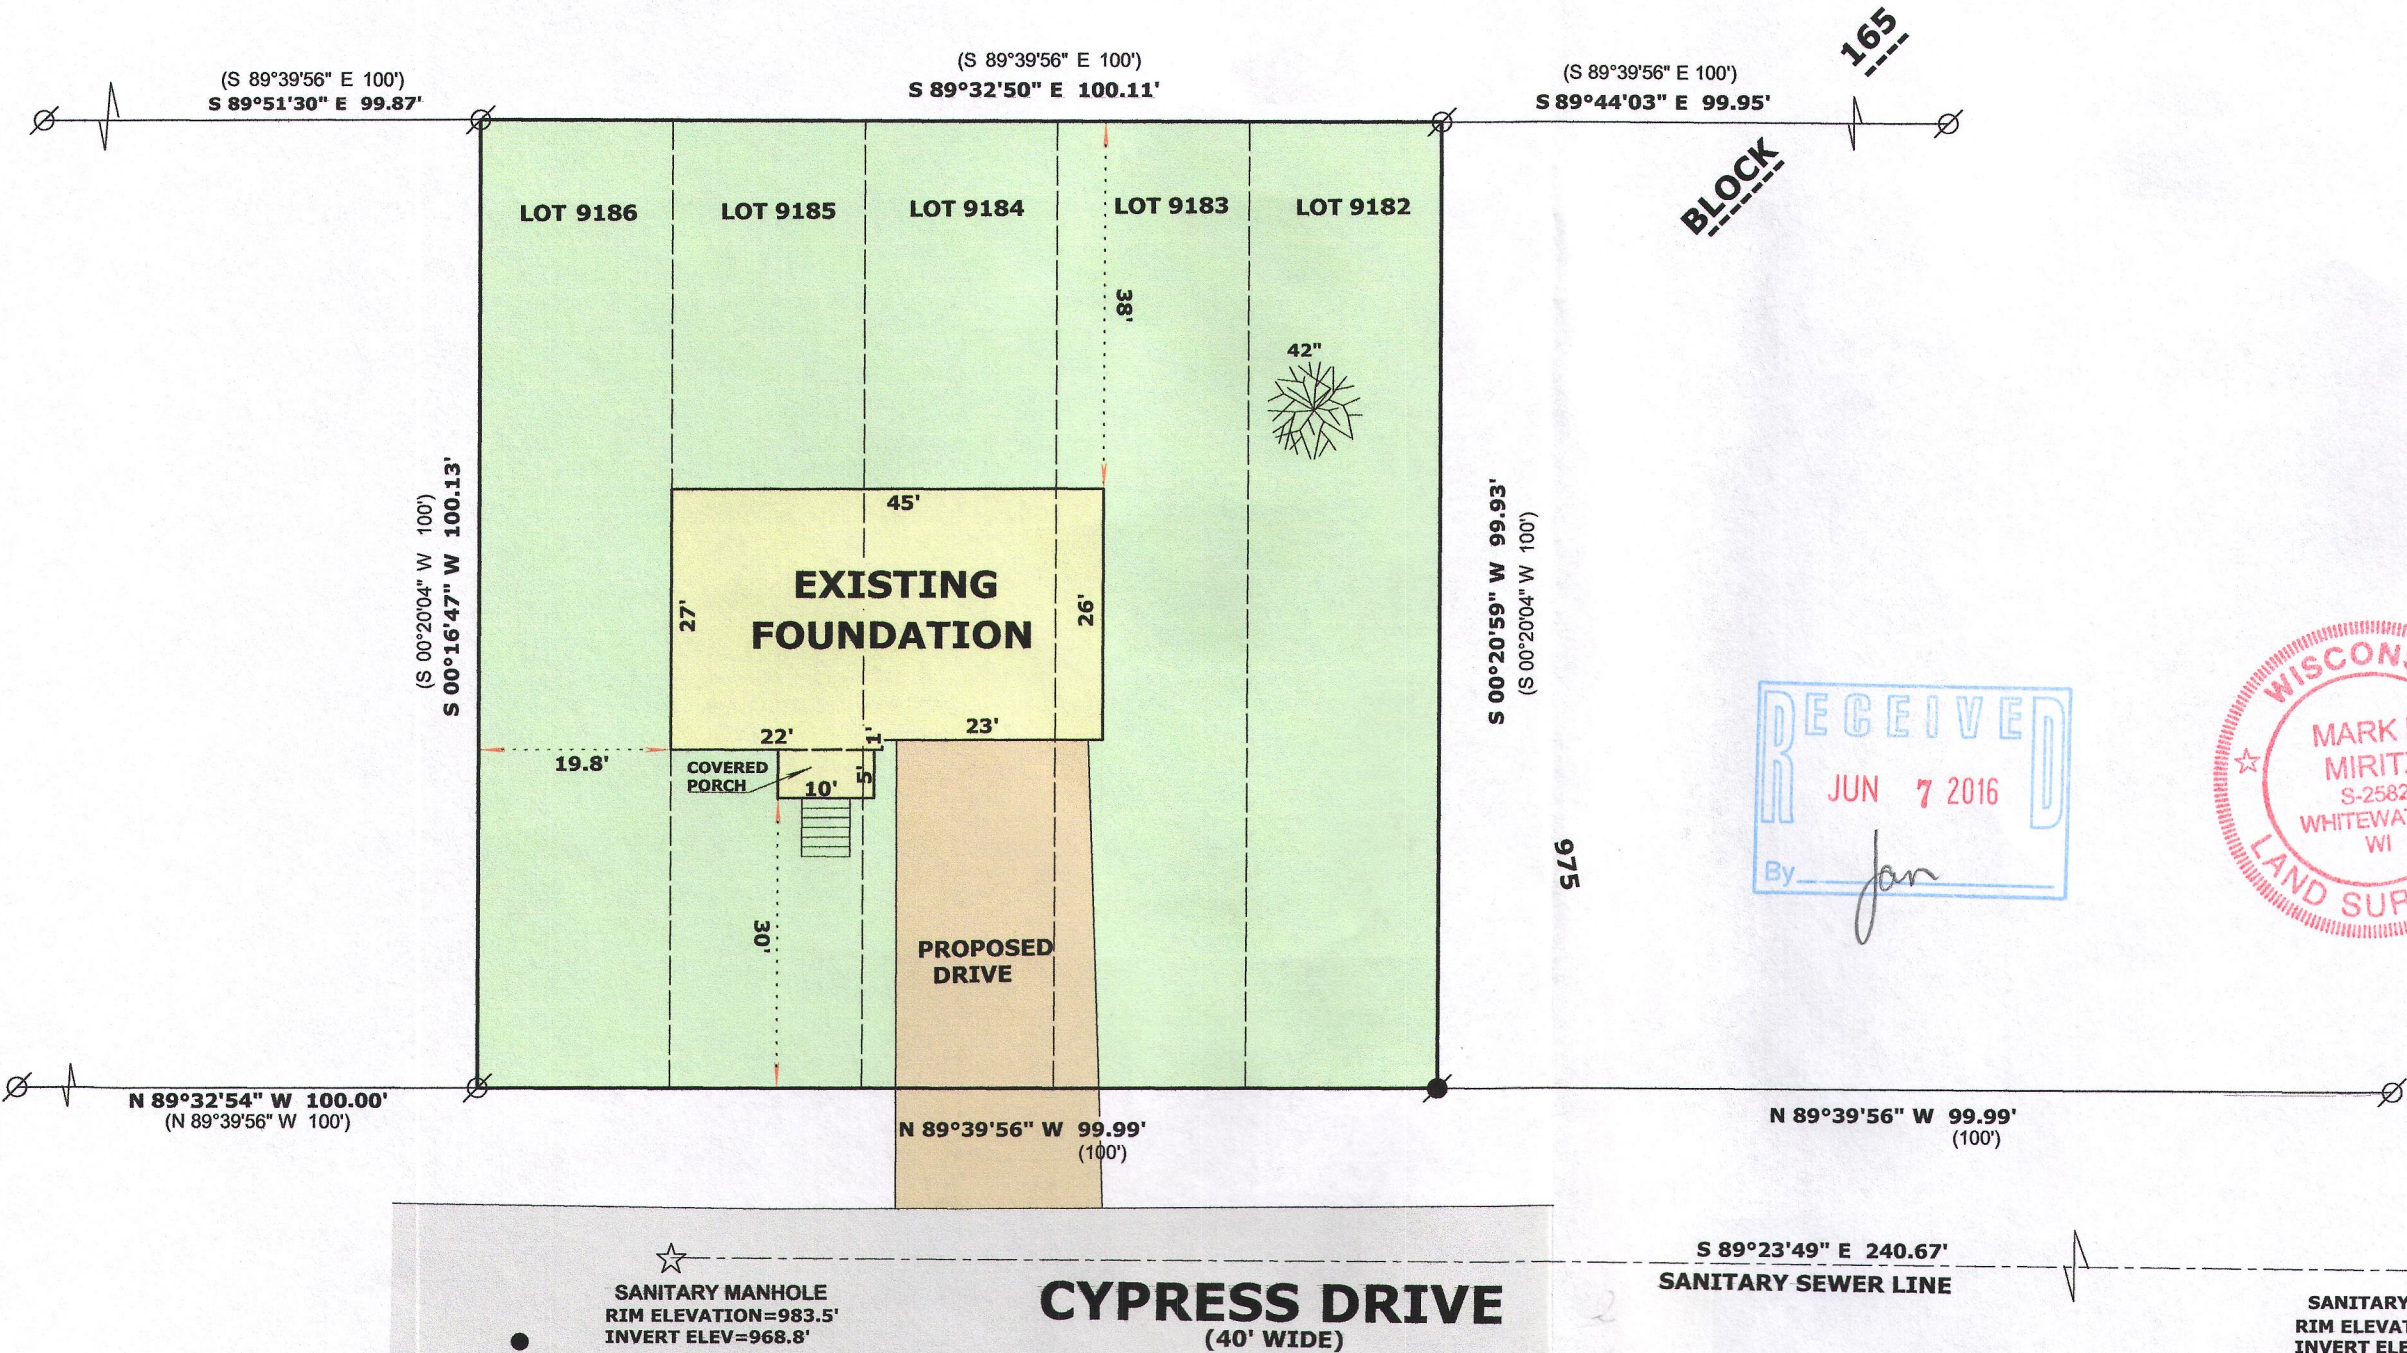

- LEGEND**
- FOUND IRON PIPE
 - FOUND IRON ROD
 - P.K. NAIL-BENCHMARK ELEV=984.40'
 - (x x) RECORDED AS DIMENSION

SCALE: 1 INCH = 20 FEET

"I hereby certify that the above described property has been surveyed by me or under my direction and that the above map is a true representation thereof and shows the size and location of the property, its exterior boundaries, the location of all visible structures and dimensions of all principal buildings thereon, boundary fences, apparent easements, roadways and visible encroachments, if any."

"This survey is made for the use of the present owners of the property, and also those who purchase, mortgage, or guarantee the title thereto within one year from date hereof."

MARK L. MIRITZ
WISCONSIN PROFESSIONAL
LAND SURVEYOR S-2582

DATE: JAN. 9, 2016 JOB NO. 16.102

REVISED APRIL 8, 2016 TO SHOW
EXISTING FOUNDATION "AS BUILT"

JLCB-1974

217-4201