


FARRIS, HANSEN, & ASSOCIATES, INC.
ENGINEERING, ARCHITECTURE, SURVEYING
7 RIDGWAY COURT — P.O. BOX 437, ELKHORN, WISCONSIN, 53121
PHONE: (262) 723-2098 FAX: (262) 723-5886

PLAT OF SURVEY
THE NORTH 1/2 OF LOT 10143 & LOTS 10144 THRU 10146 OF BLOCK 185
LAKE COMO BEACH SUBDIVISION
LOCATED IN THE TOWN OF GENEVA
WALWORTH COUNTY, WISCONSIN

— WORK ORDERED BY —
JOE KOMPARE
8130 W. 45th PLACE
LYONS, IL. 60534

SURVEYED AREA = 7000 S.F.
TAX PARCELS
JLCB-2191
JLCB-2192

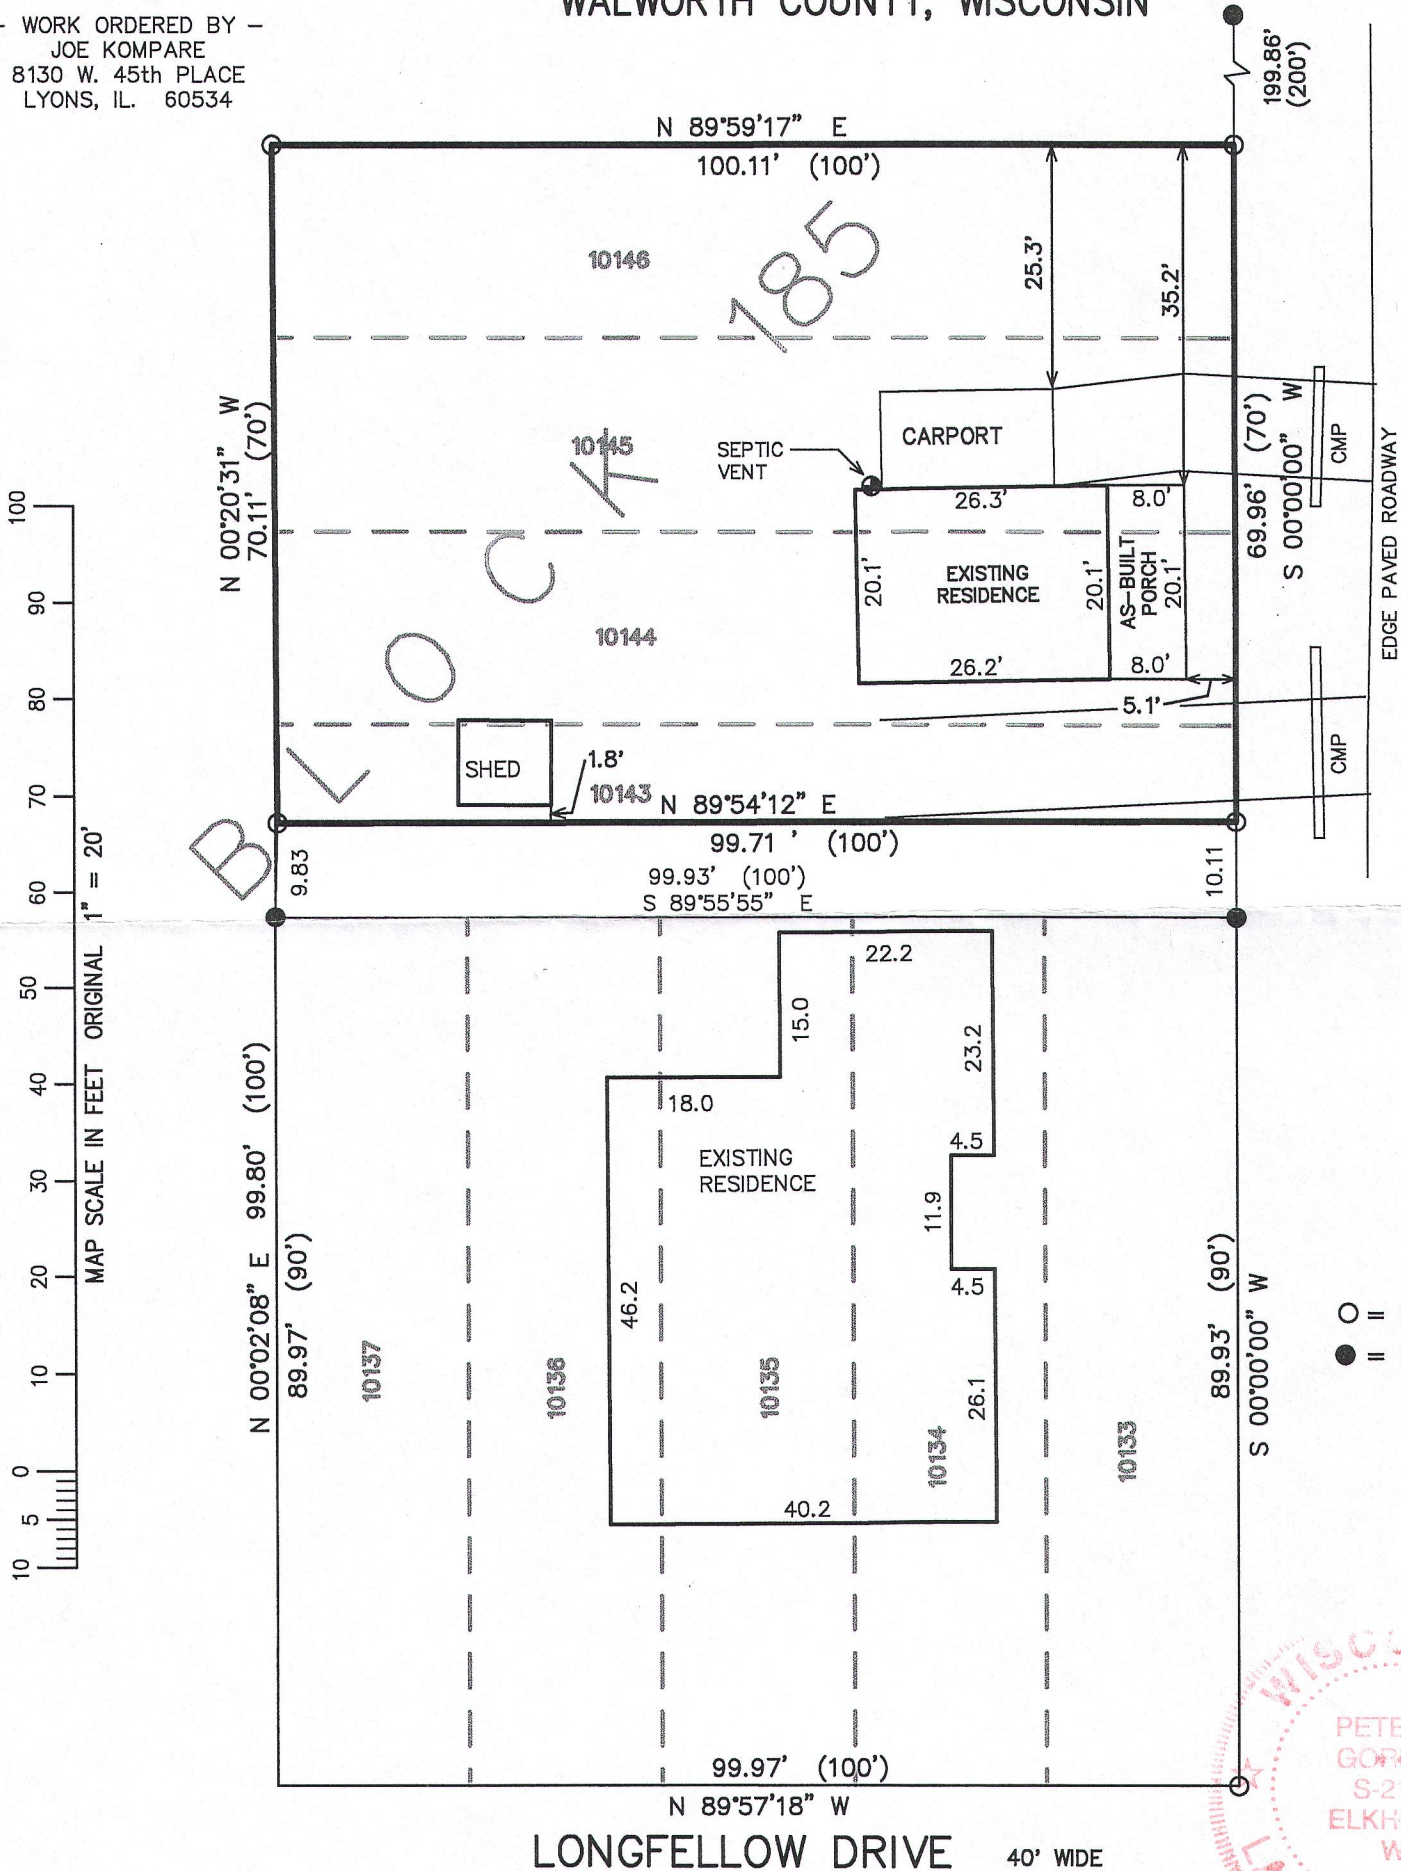

NOTE: COPIES OF THIS MAP TO WHICH THE FOLLOWING CERTIFICATE WILL APPLY SHOW SURVEYOR'S ORIGINAL SEAL AND SIGNATURE IN RED INK. COPIES BY ANY OTHER MEANS MAY HAVE ALTERATIONS WHICH DO NOT REPRESENT THE SURVEYOR'S WORK PRODUCT.


I HEREBY CERTIFY THAT THE ABOVE DESCRIBED PROPERTY HAS BEEN SURVEYED UNDER MY DIRECTION AND THAT THE ABOVE MAP IS A TRUE REPRESENTATION THEREOF AND SHOWS THE SIZE AND LOCATION OF THE PROPERTY AND ITS EXTERIOR BOUNDARIES. THIS SURVEY IS MADE FOR THE USE OF THE PRESENT OWNERS OF THE PROPERTY, AND ALSO THOSE WHO PURCHASE, MORTGAGE, OR GUARANTEE THE TITLE THERETO WITHIN ONE YEAR FROM THE DATE HEREOF.

DATED: 10/20/99

REVISED 10/29/99
CORRECT ADDRESS & LEGAL DESC.

REVISED 6/27/2016
TO SHOW SIZE & LOCATION OF
AS-BUILT PORCH

PETER S. GORDON R.L.S. 2101

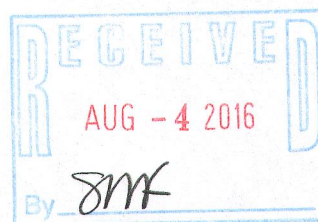

PROJECT 5419.16
DATE: 10-12-99
SHEET 1 OF 1

JLCB-2191

217-4212