

PLAT OF SURVEY

UNIT 05-11
GENEVA NATIONAL CONDOMINIUM
NO. 05
LOCATED IN TOWN 2 NORTH, RANGE 17 EAST
WALWORTH COUNTY, WISCONSIN



WORK ORDERED BY
FLAHERTY BUILDERS, INC.
9485 BORMET DRIVE
MOKENA, IL 60448



FARRIS, HANSEN & ASSOCIATES, INC.
Engineering & Surveying
7 Ridgway Court, P.O. Box 437
ELKHORN, WISCONSIN 53121
Office: (262) 723-2098
Fax: (262) 723-5866

REVISIONS
2/5/2016-KB
ADJUST SIZE &
LOCATION OF
PROPOSED RES.

PROJECT NO.
3269-05-11.15

DATE:
12-28-2015

SHEET NO.
1 OF 1

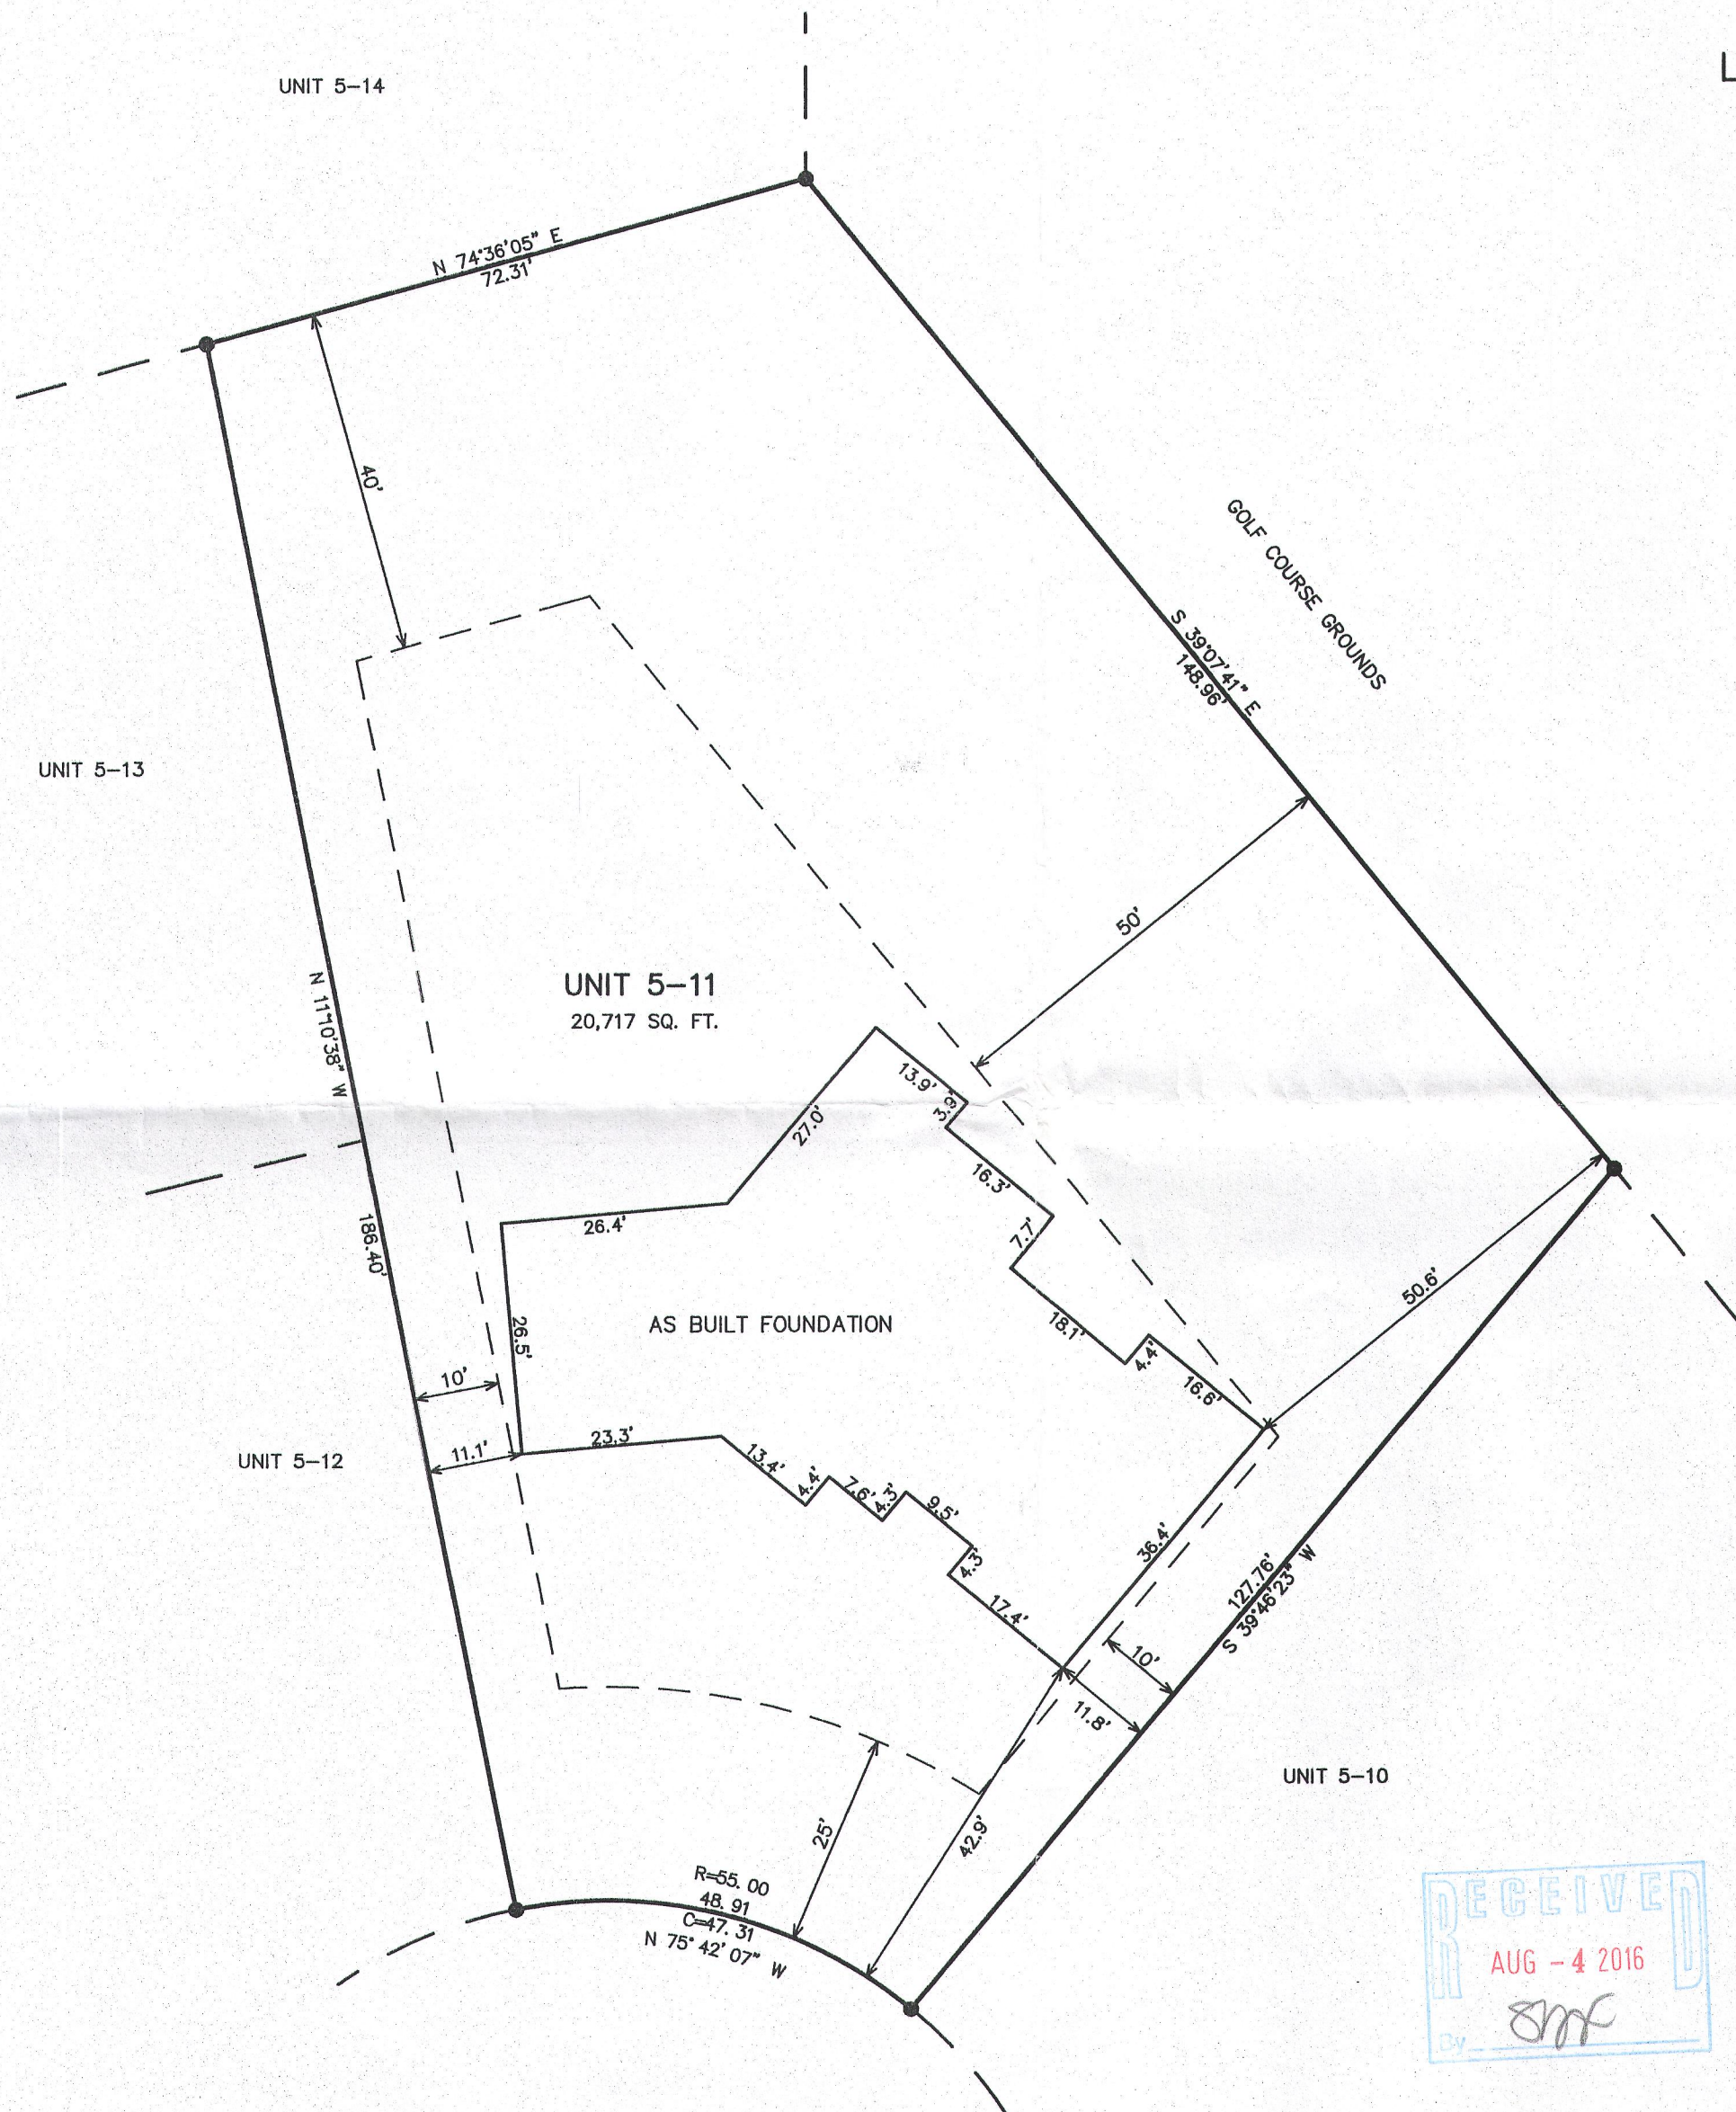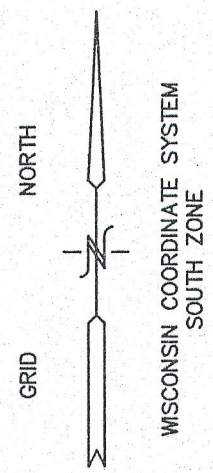


NOTE: COPIES OF THIS MAP TO WHICH THE FOLLOWING CERTIFICATE
WILL APPLY SHOW THE SURVEYOR'S ORIGINAL SEAL AND SIGNATURE
IN RED INK. COPIES BY ANY OTHER MEANS MAY HAVE ALTERATIONS
WHICH DO NOT REPRESENT THE SURVEYOR'S WORK PRODUCT.

I HEREBY CERTIFY THAT THE ABOVE DESCRIBED PROPERTY HAS BEEN
SURVEYED UNDER MY DIRECTION AND THAT THE ABOVE MAP IS A TRUE
REPRESENTATION THEREOF AND SHOWS THE SIZE AND LOCATION OF
THE PROPERTY AND ITS EXTERIOR BOUNDARIES. THIS SURVEY IS
MADE FOR THE USE OF THE PRESENT OWNERS OF THE PROPERTY, AND
ALSO THOSE WHO PURCHASE, MORTGAGE, OR GUARANTEE THE TITLE
THERE TO WITHIN ONE YEAR FROM THE DATE HEREOF.

DATED: OCTOBER 6, 2015

REVISED 07-05-2016
TO SHOW SIZE & LOCATION OF
AS BUILT FOUNDATION

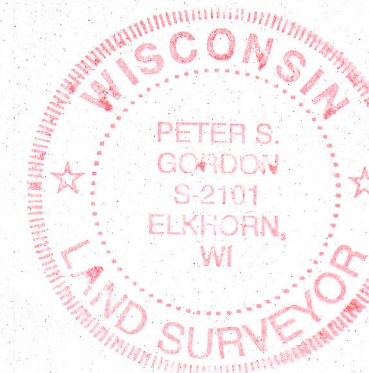

PETER S. GORDON P.L.S. 2101

JUL 05 2016

JGN-5-11

217-4218