



PLAT OF SURVEY UNIT 19-30

GENEVA NATIONAL CONDOMINIUM NO. 19
LOCATED IN TOWN 2 NORTH, RANGE 17 EAST,
WALWORTH COUNTY, WISCONSIN

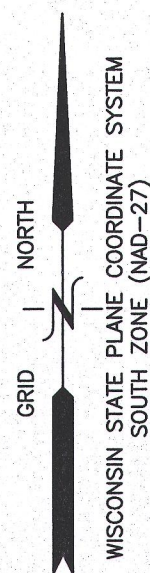

BENCH MARK
SOUTH RIM OF
SANITARY MANHOLE
ELEV.=1032.67'

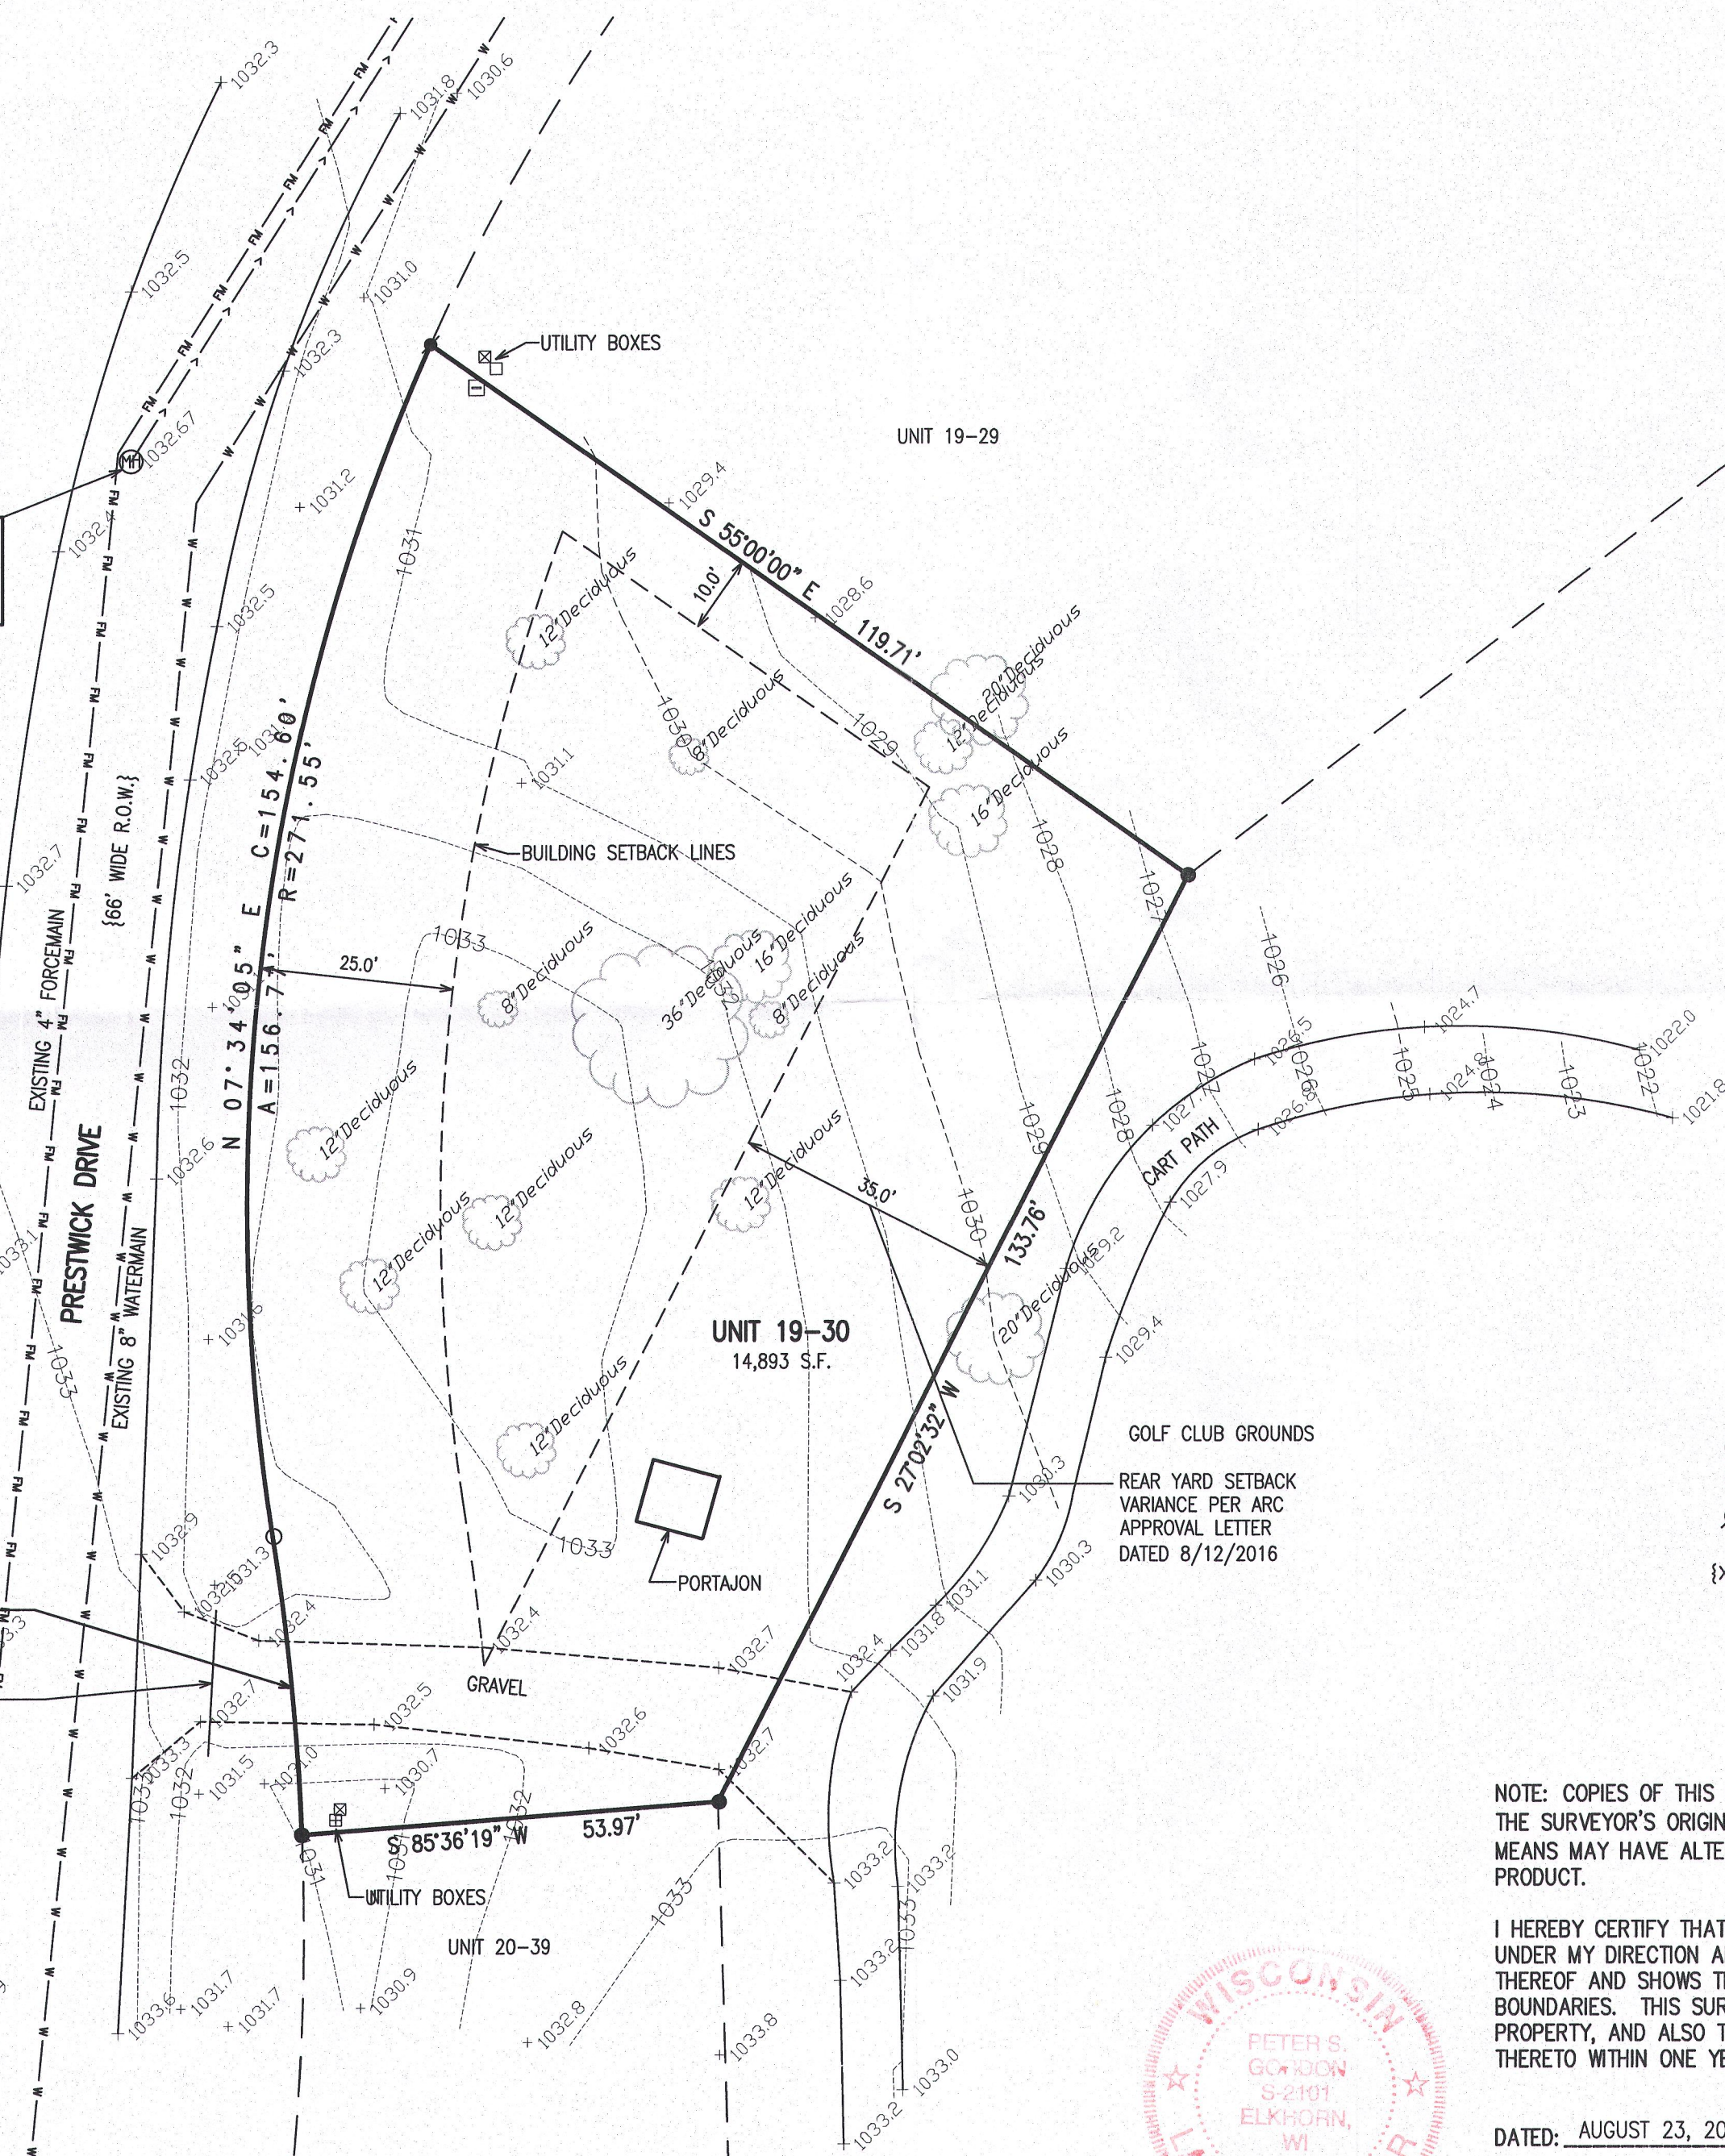

- LEGEND
- = FOUND IRON PIPE STAKE
 - = FOUND IRON REBAR STAKE, 1/2" DIA.
 - ⦿ = SET IRON REBAR STAKE, 3/4" x 24" x 1.60 lbs/ft
 - {XXX} = RECORDED AS




NOTE: COPIES OF THIS MAP TO WHICH THE FOLLOWING CERTIFICATE WILL APPLY SHOW THE SURVEYOR'S ORIGINAL SEAL AND SIGNATURE IN RED INK. COPIES BY ANY OTHER MEANS MAY HAVE ALTERATIONS WHICH DO NOT REPRESENT THE SURVEYOR'S WORK PRODUCT.

I HEREBY CERTIFY THAT THE ABOVE DESCRIBED PROPERTY HAS BEEN SURVEYED UNDER MY DIRECTION AND THAT THE ABOVE MAP IS A TRUE REPRESENTATION THEREOF AND SHOWS THE SIZE AND LOCATION OF THE PROPERTY AND ITS EXTERIOR BOUNDARIES. THIS SURVEY IS MADE FOR THE USE OF THE PRESENT OWNERS OF THE PROPERTY, AND ALSO THOSE WHO PURCHASE, MORTGAGE, OR GUARANTEE THE TITLE THERETO WITHIN ONE YEAR FROM THE DATE HEREOF.



DATED: AUGUST 23, 2016

Peter S. Gordon
PETER S. GORDON P.L.S. 2101

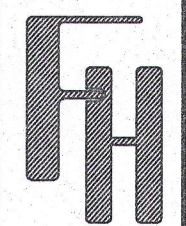

PLAT OF SURVEY

WORK ORDERED BY -
LOWELL MANAGEMENT SERVICES, INC.
PO BOX 926
LAKE GENEVA, WI 53147

FARRIS, HANSEN & ASSOCIATES, INC.
ENGINEERING - ARCHITECTURE - SURVEYING
7 RIDGWAY COURT P.O. BOX 437
ELKHORN, WISCONSIN 53121
OFFICE: (262) 723-2098 FAX: (262) 723-5886

REVISIONS

PROJECT NO.	3269-19-30
DATE:	8/23/2016
SHEET NO.	1 OF 1

X:\Projects\3269\CONDO_19\Unit_30\3269-19-30_16\ACAD\32691930.dwg

JAN 19-30

217-4043