




PREPARED FOR
MELANIE VENEMA
SHOREWEST REALTY
LAKE GENEVA WI.

PLAT OF SURVEY

OF

LOTS 5044-5048 BLOCK 89 OF LAKE COMO BEACH SUBDIVISION;
LOCATED IN TOWN 2 NORTH, RANGE 17 EAST, WALWORTH COUNTY,
WISCONSIN

PATHFINDER SURVEYING INC.
(formerly)
J.K. SURVEYING INC.
P.O BOX 322
LAKE GENEVA, WI. 53147
WWW.PATHFINDERSURVEYING.NET
262-248-8303

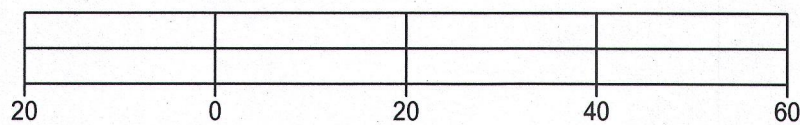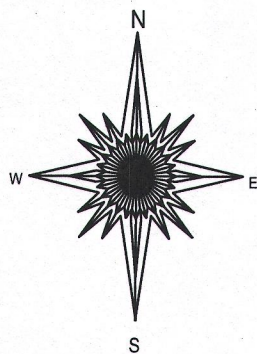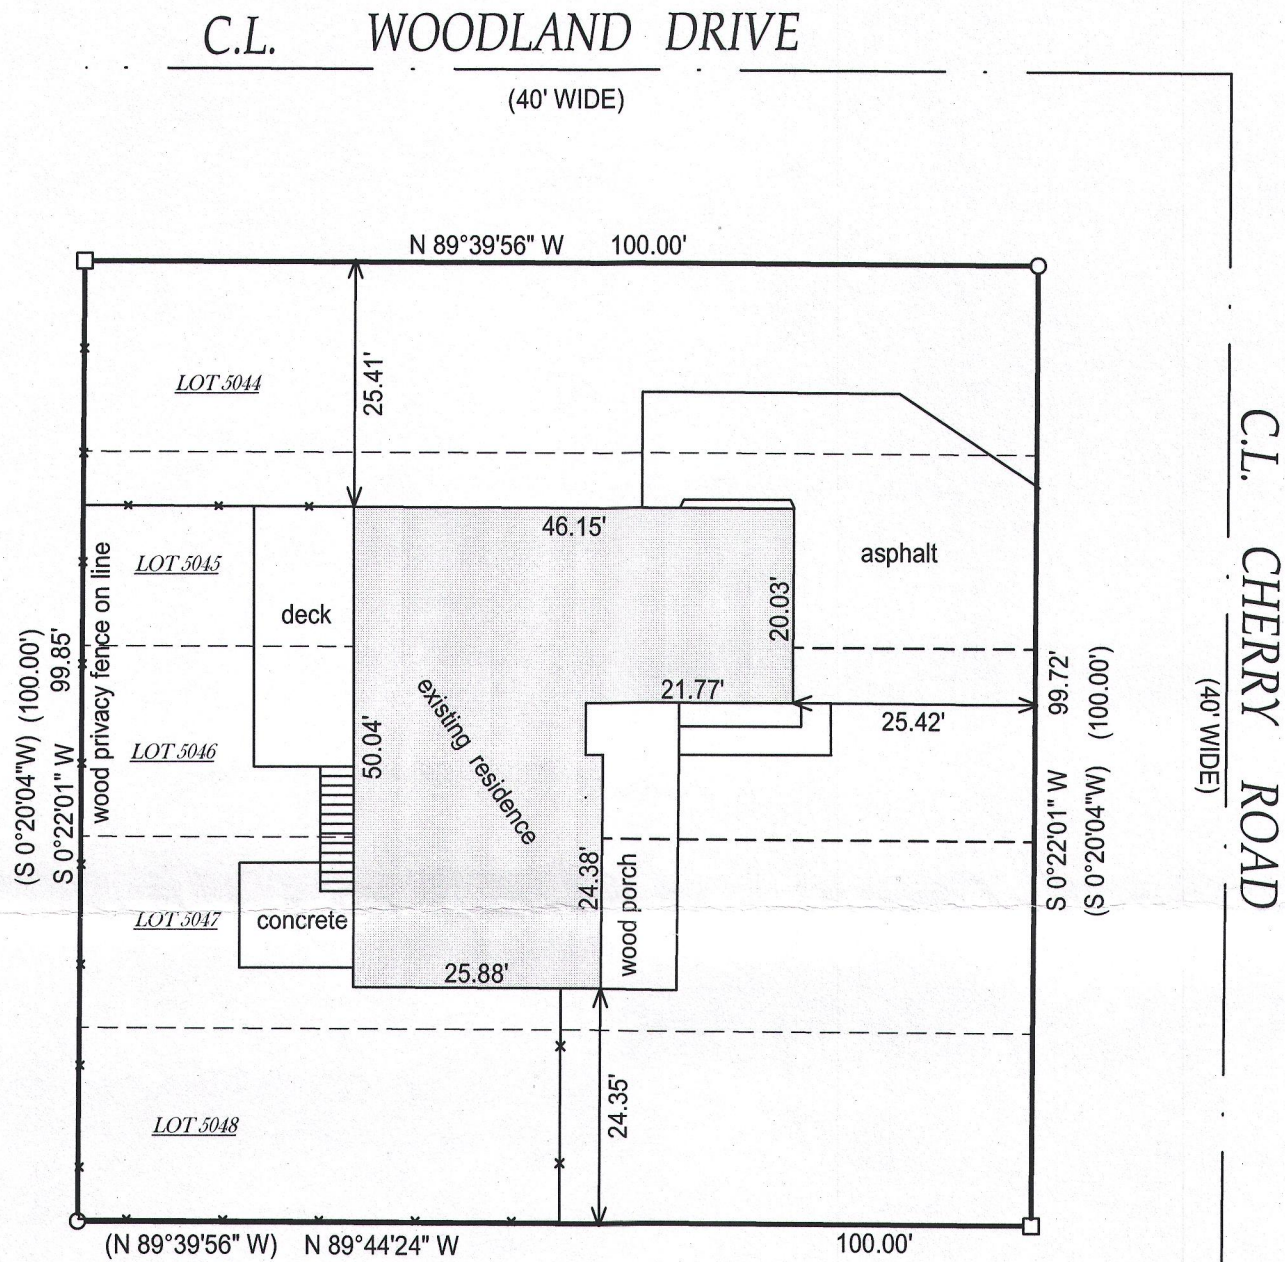

- () = recorded as
- = found iron bar
- = found iron pipe
- = set iron pipe
- = set iron bar

JOB# 02-081ud



SCALE: 1"=20'

TAX KEY # JLCB-1013

BASIS OF BEARING OF THIS PLAT: THE SUBDIVISION PLAT
OF RECORD.

"I hereby certify that I have surveyed the above described property and that
the above map is a true representation thereof and shows the size and
location of all visible structures, apparent easements and encroachments
if any."

This survey is made for the present owners of the property, and those who
purchase, mortgage, or guarantee the title thereto, within one year from
the date hereof.

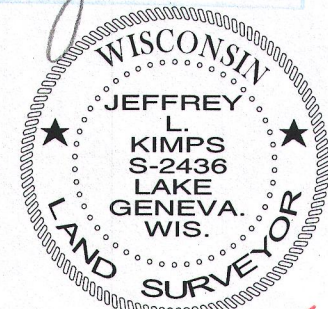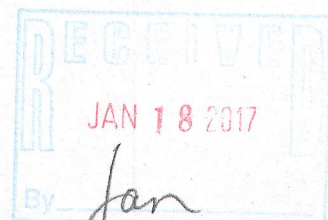

JEFFREY L KIMPS S-2436
Wisconsin Professional Land Surveyor
(original if signed in red)

DATED THIS 13TH DAY OF OCTOBER, 2016.