



PREPARED FOR:  
LAKE GENEVA AREA REALTY  
101 BROAD ST  
LAKE GENEVA, WI.

# PLAT OF SURVEY

-OF-

LOT 11 BLOCK 2 OF GENEVA BAY ESTATES LOCATED IN  
SECTION 35, TOWN 2 NORTH, RANGE 17 EAST TOWN OF  
GENEVA, AND SECTION 2, TOWN 1 NORTH, RANGE 17 EAST,  
TOWN OF LINN, WALWORTH COUNTY, WISCONSIN.

PATHFINDER SURVEYING INC.  
(formerly)  
J.K. SURVEYING INC.  
P.O BOX 322  
LAKE GENEVA, WI. 53147  
WWW.PATHFINDERSURVEYING.NET  
262-248-8303

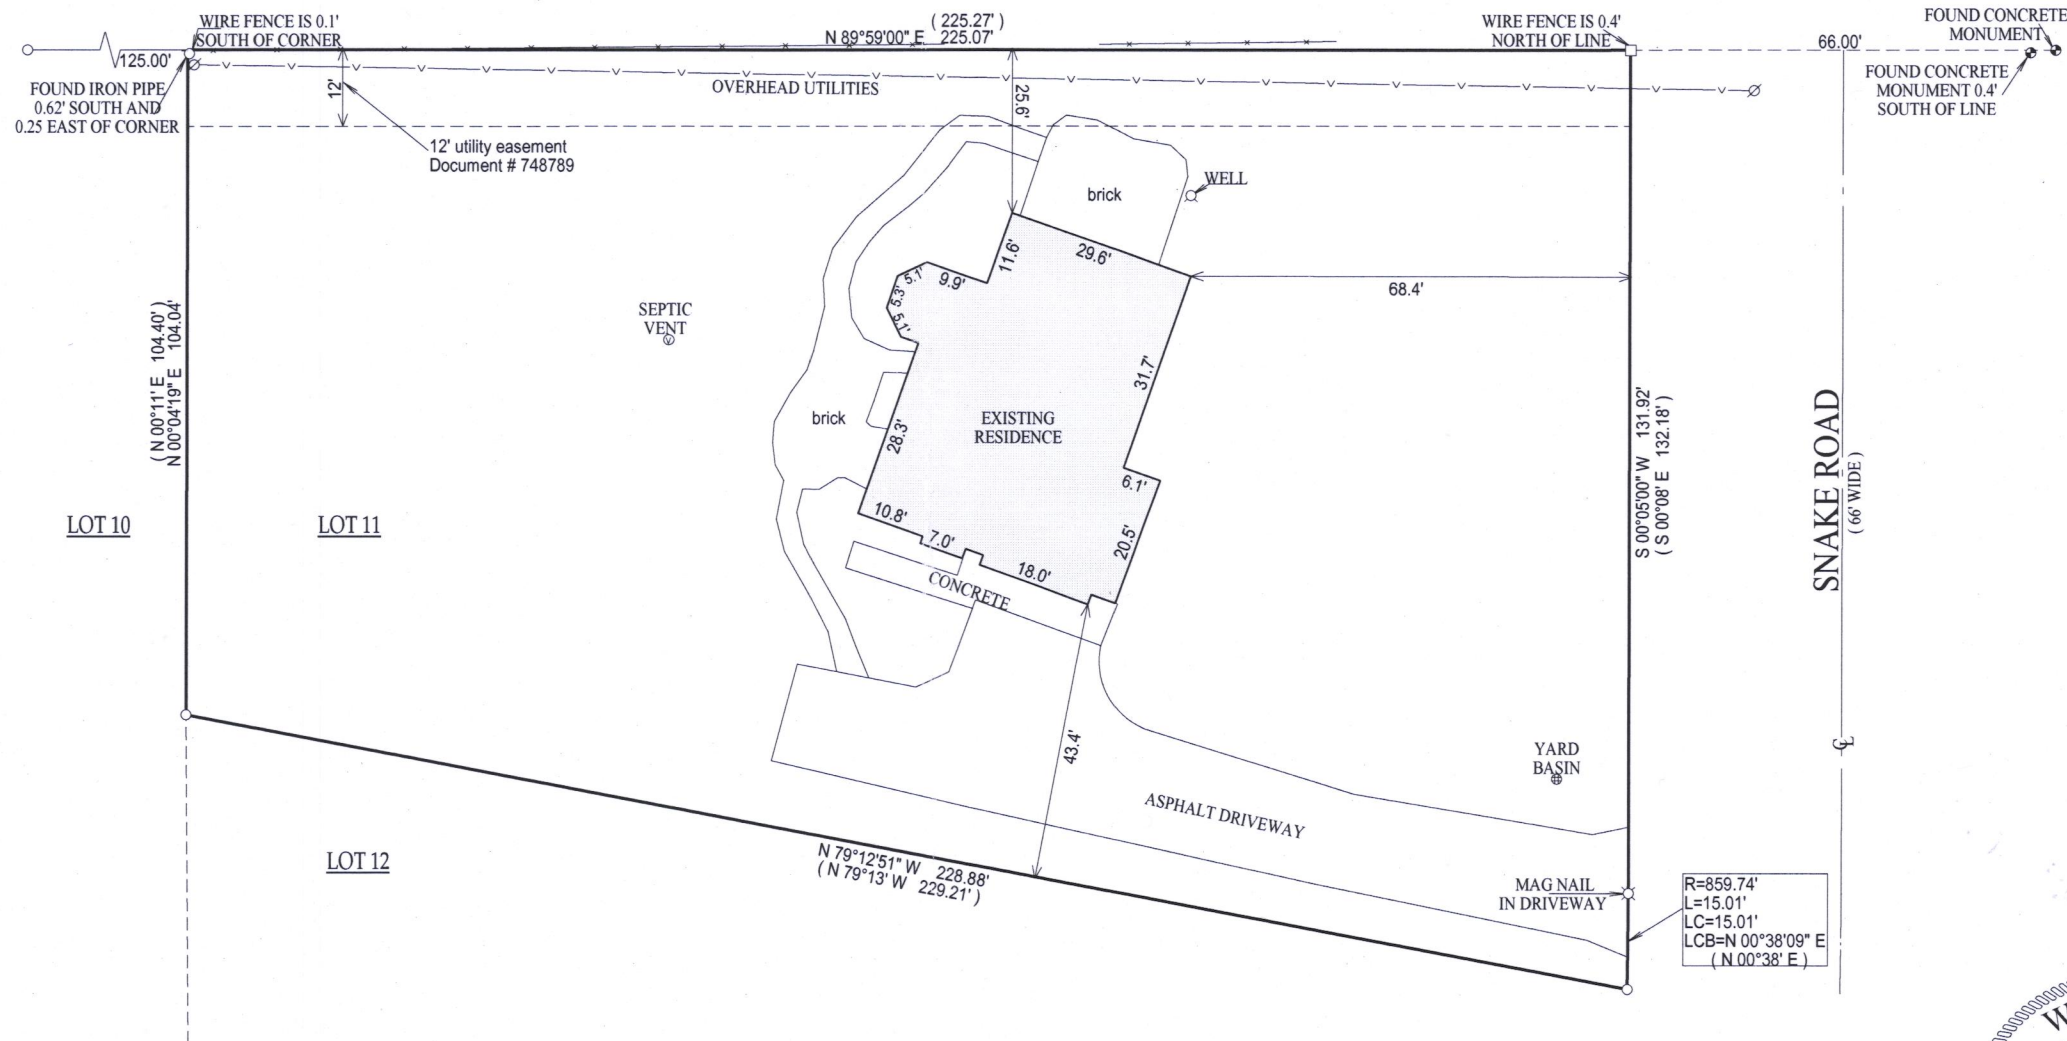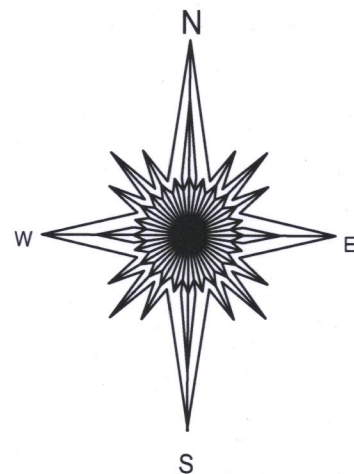

( ) = RECORDED AS

□ = FOUND IRON BAR

○ = FOUND IRON PIPE


● = SET IRON PIPE

■ = SET IRON BAR

SCALE: 1" = 30'

JOB #: 17-57



TAX ID #: JGBE 00039

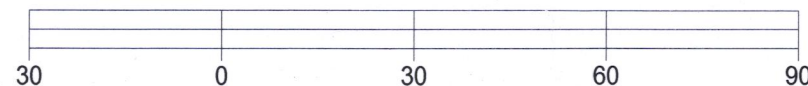

NOTE: BASIS OF BEARING IS RECORD PLAT.

"I hereby certify that the above described property was surveyed under my supervision and that the above map, to the best of my knowledge and belief, is a true representation thereof and shows the size and location of all visible structures, apparent easements and encroachments if any." This survey is made for the present owners of the property, and those who purchase, mortgage, or guarantee the title thereto, within one year from the date hereof.

ORIGINAL FIELD WORK THE 21st DAY OF JUNE, 2006.

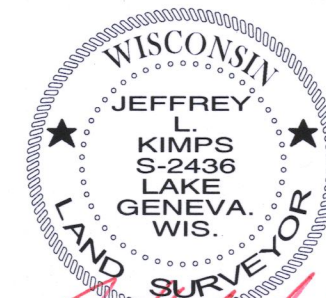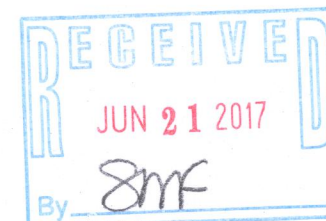

JEFFREY L. KIMPS S-2436  
Wisconsin Registered Land Surveyor  
(original if signed in red)  
DATED THIS 19TH DAY OF MARCH, 2017.

217-4320