

LAND-MARK SURVEYING

Mark L. Miritz
Wisconsin Professional Land Surveyor S-2582




N9330 Knuteson Drive
Whitewater, WI 53190
Phone: (262)495-3284
MARKMIRITZ@
LAND-MARKSURVEYING.COM

CENTER OF
SECTION
23-2-17


PLAT OF SURVEY

ORDERED BY:
MARK RANUM
FALCON REALTY
11430 W. BLUEMOUND RD.
SUITE 200
WAUWATOSA, WI 53226

LOT 2 OF CERTIFIED SURVEY MAP NO. 3727,
LOCATED IN PART OF THE SOUTHEAST 1/4 OF
THE SOUTHWEST 1/4 OF SECTION 23,
TOWN 2 NORTH, RANGE 17 EAST, TOWN OF
GENEVA, WALWORTH COUNTY, WISCONSIN.

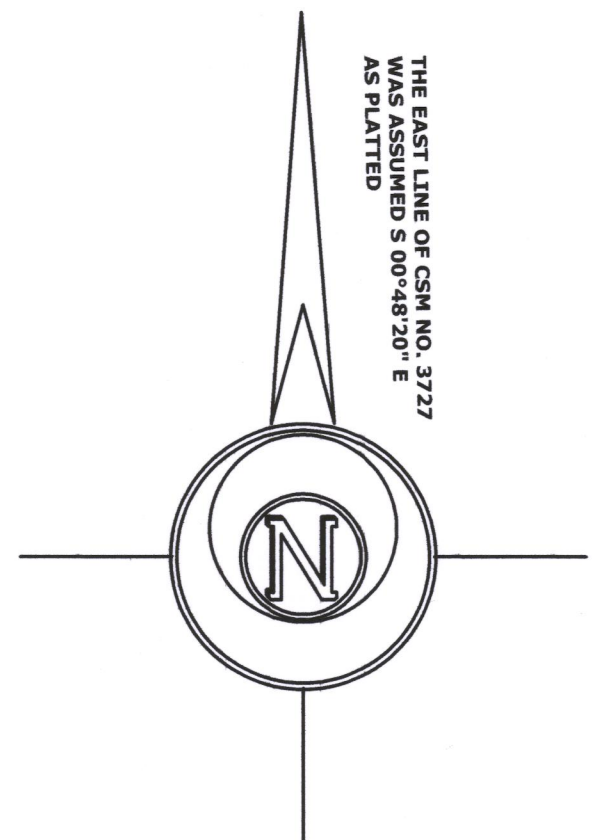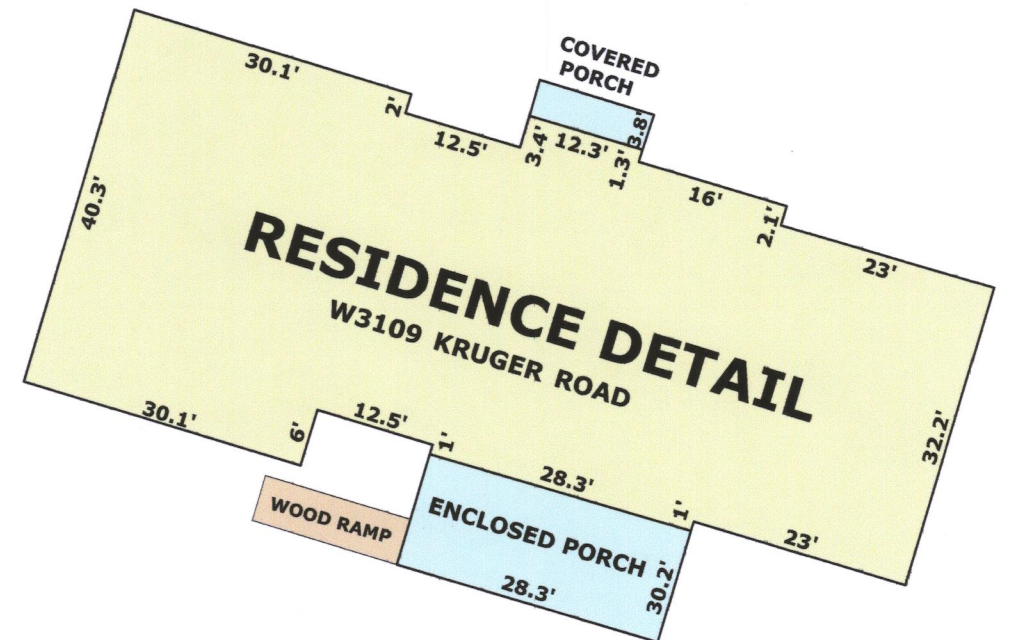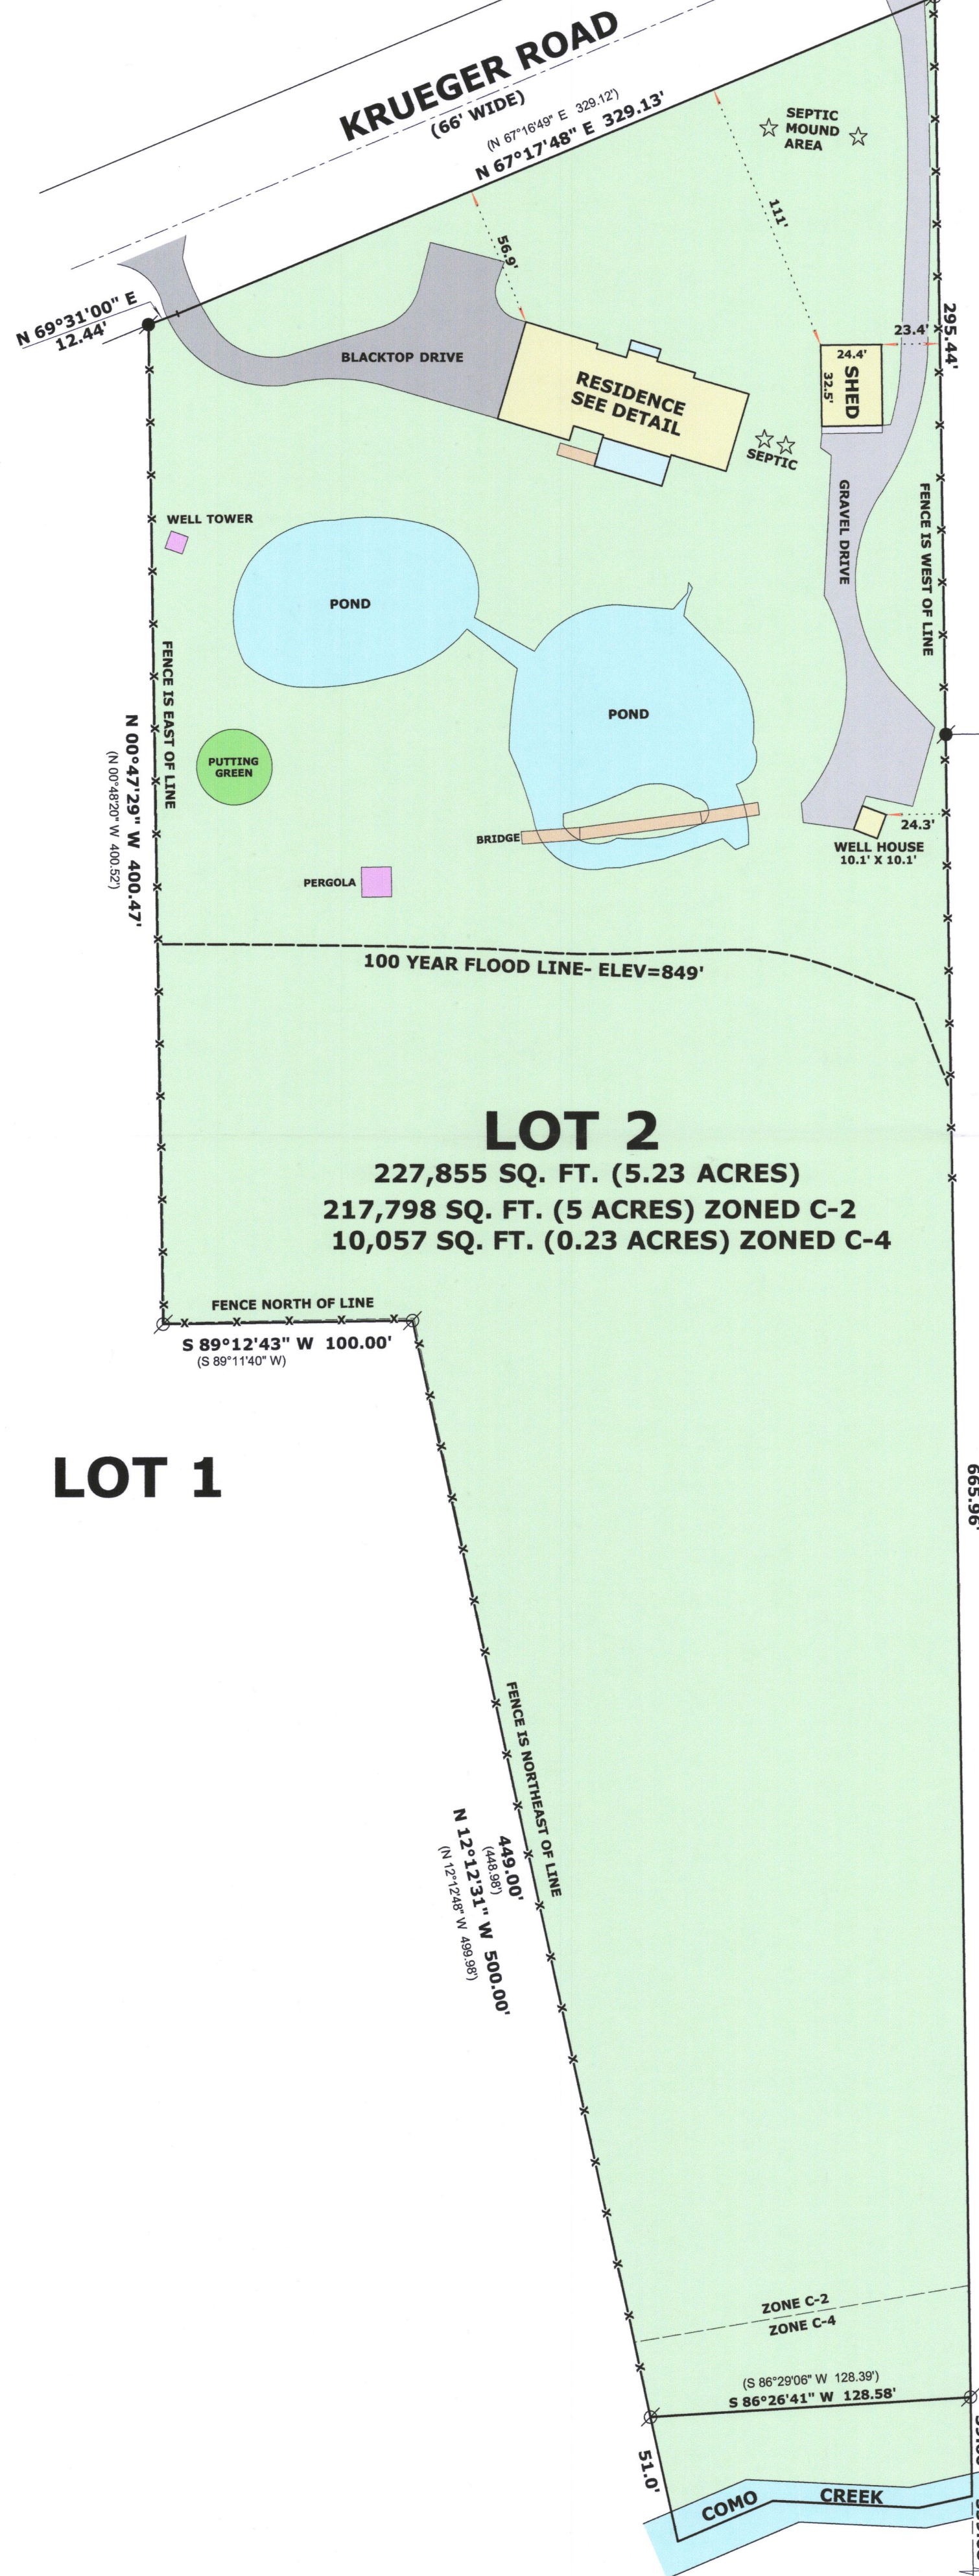

THE EAST LINE OF CSM NO. 3727
WAS ASSUMED S 00°48'20" E
AS PLATTED

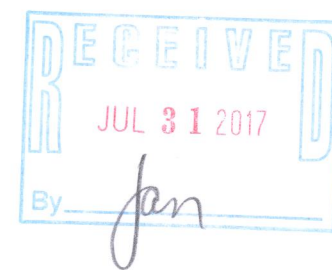

LEGEND

- FOUND IRON PIPE
- FOUND IRON ROD
- FOUND COUNTY MONUMENT
- (xx) RECORDED AS DIMENSION
- EXISTING SPLIT RAIL FENCE

SCALE: 1 INCH = 100 FEET

"I hereby certify that the above described property has been surveyed by me or under my direction and that the above map is a true representation thereof and shows the size and location of the property, its exterior boundaries, the location of all visible structures and dimensions of all principal buildings thereon, boundary fences, apparent easements, roadways and visible encroachments, if any."

"This survey is made for the use of the present owners of the property, and also those who purchase, mortgage, or guarantee the title thereto within one year from date hereof."

MARK L. MIRITZ
WISCONSIN PROFESSIONAL
LAND SURVEYOR S-2582

DATE: APRIL 15, 2017

JOB NO. 17.314

REVISED LEGAL
DESCRIPTION
APRIL 17, 2017

JA3727-2

217-4332