

**N9330 Knuteson Drive
Whitewater, WI 53190
Phone:(262)495-3284
MarkMiritz@
Land-MarkSurveying.com**


LEGAL DESCRIPTION

LOCATED IN THE SOUTHWEST 1/4, OF THE SOUTHWEST 1/4, SECTION 22,
TOWNSHIP 2 NORTH, RANGE 17 EAST, IN THE TOWN OF GENEVA,
WALWORTH COUNTY, WISCONSIN.

**LOTS 2467 THRU 2476 (INCLUSIVE), BLOCK 44, OF LAKE COMO BEACH
SECOND MAP.**

**OWNER: SUSAN L. MEISENHOLDER
199 W. NORTH AVE.
WEST CHICAGO, IL. 60185**

PARK DR.

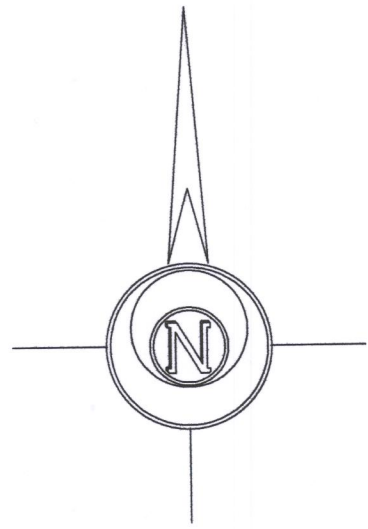

BASIS OF BEARINGS:
THE WEST LINE OF ROSEWOOD ROAD
BEING S 00°20'04" W

94.83' (95')

S 00°20'04" W 200.14' (200')

ROSEWOOD ROAD

BENCHMARK: S. RIM OF MANHOLE
ELEVATION: 941.80

LEGEND

 **FOUND IRON PIPE**
 **FOUND IRON ROD**
 **RECORDED AS DIMENSION**

SCALE: 1 INCH = 20 FEET

"I hereby certify that the above described property has been surveyed by me or under my direction and that the above map is a true representation thereof and shows the size and location of the property, its exterior boundaries, the location of all visible structures and dimensions of all easements, roadways and visible encroachments, if any."

"This survey is made for the use of the present owners of the property, and also those who purchase, mortgage, or guarantee the title thereto within one year from date hereof."

Mark L. Mirtz
MARK L. MIRITZ
WISCONSIN PROFESSIONAL
LAND SURVEYOR S-2582

DATE: April 4, 2017 JOB NO. 17.404

REVISED JULY 12, 2017 TO SHOW
FOUNDATION "AS BUILT"

JLCB-423

217-4335