


MAY 08 2017

5/8/2017 X:\Projects\9336\DCAD\ASBLT C

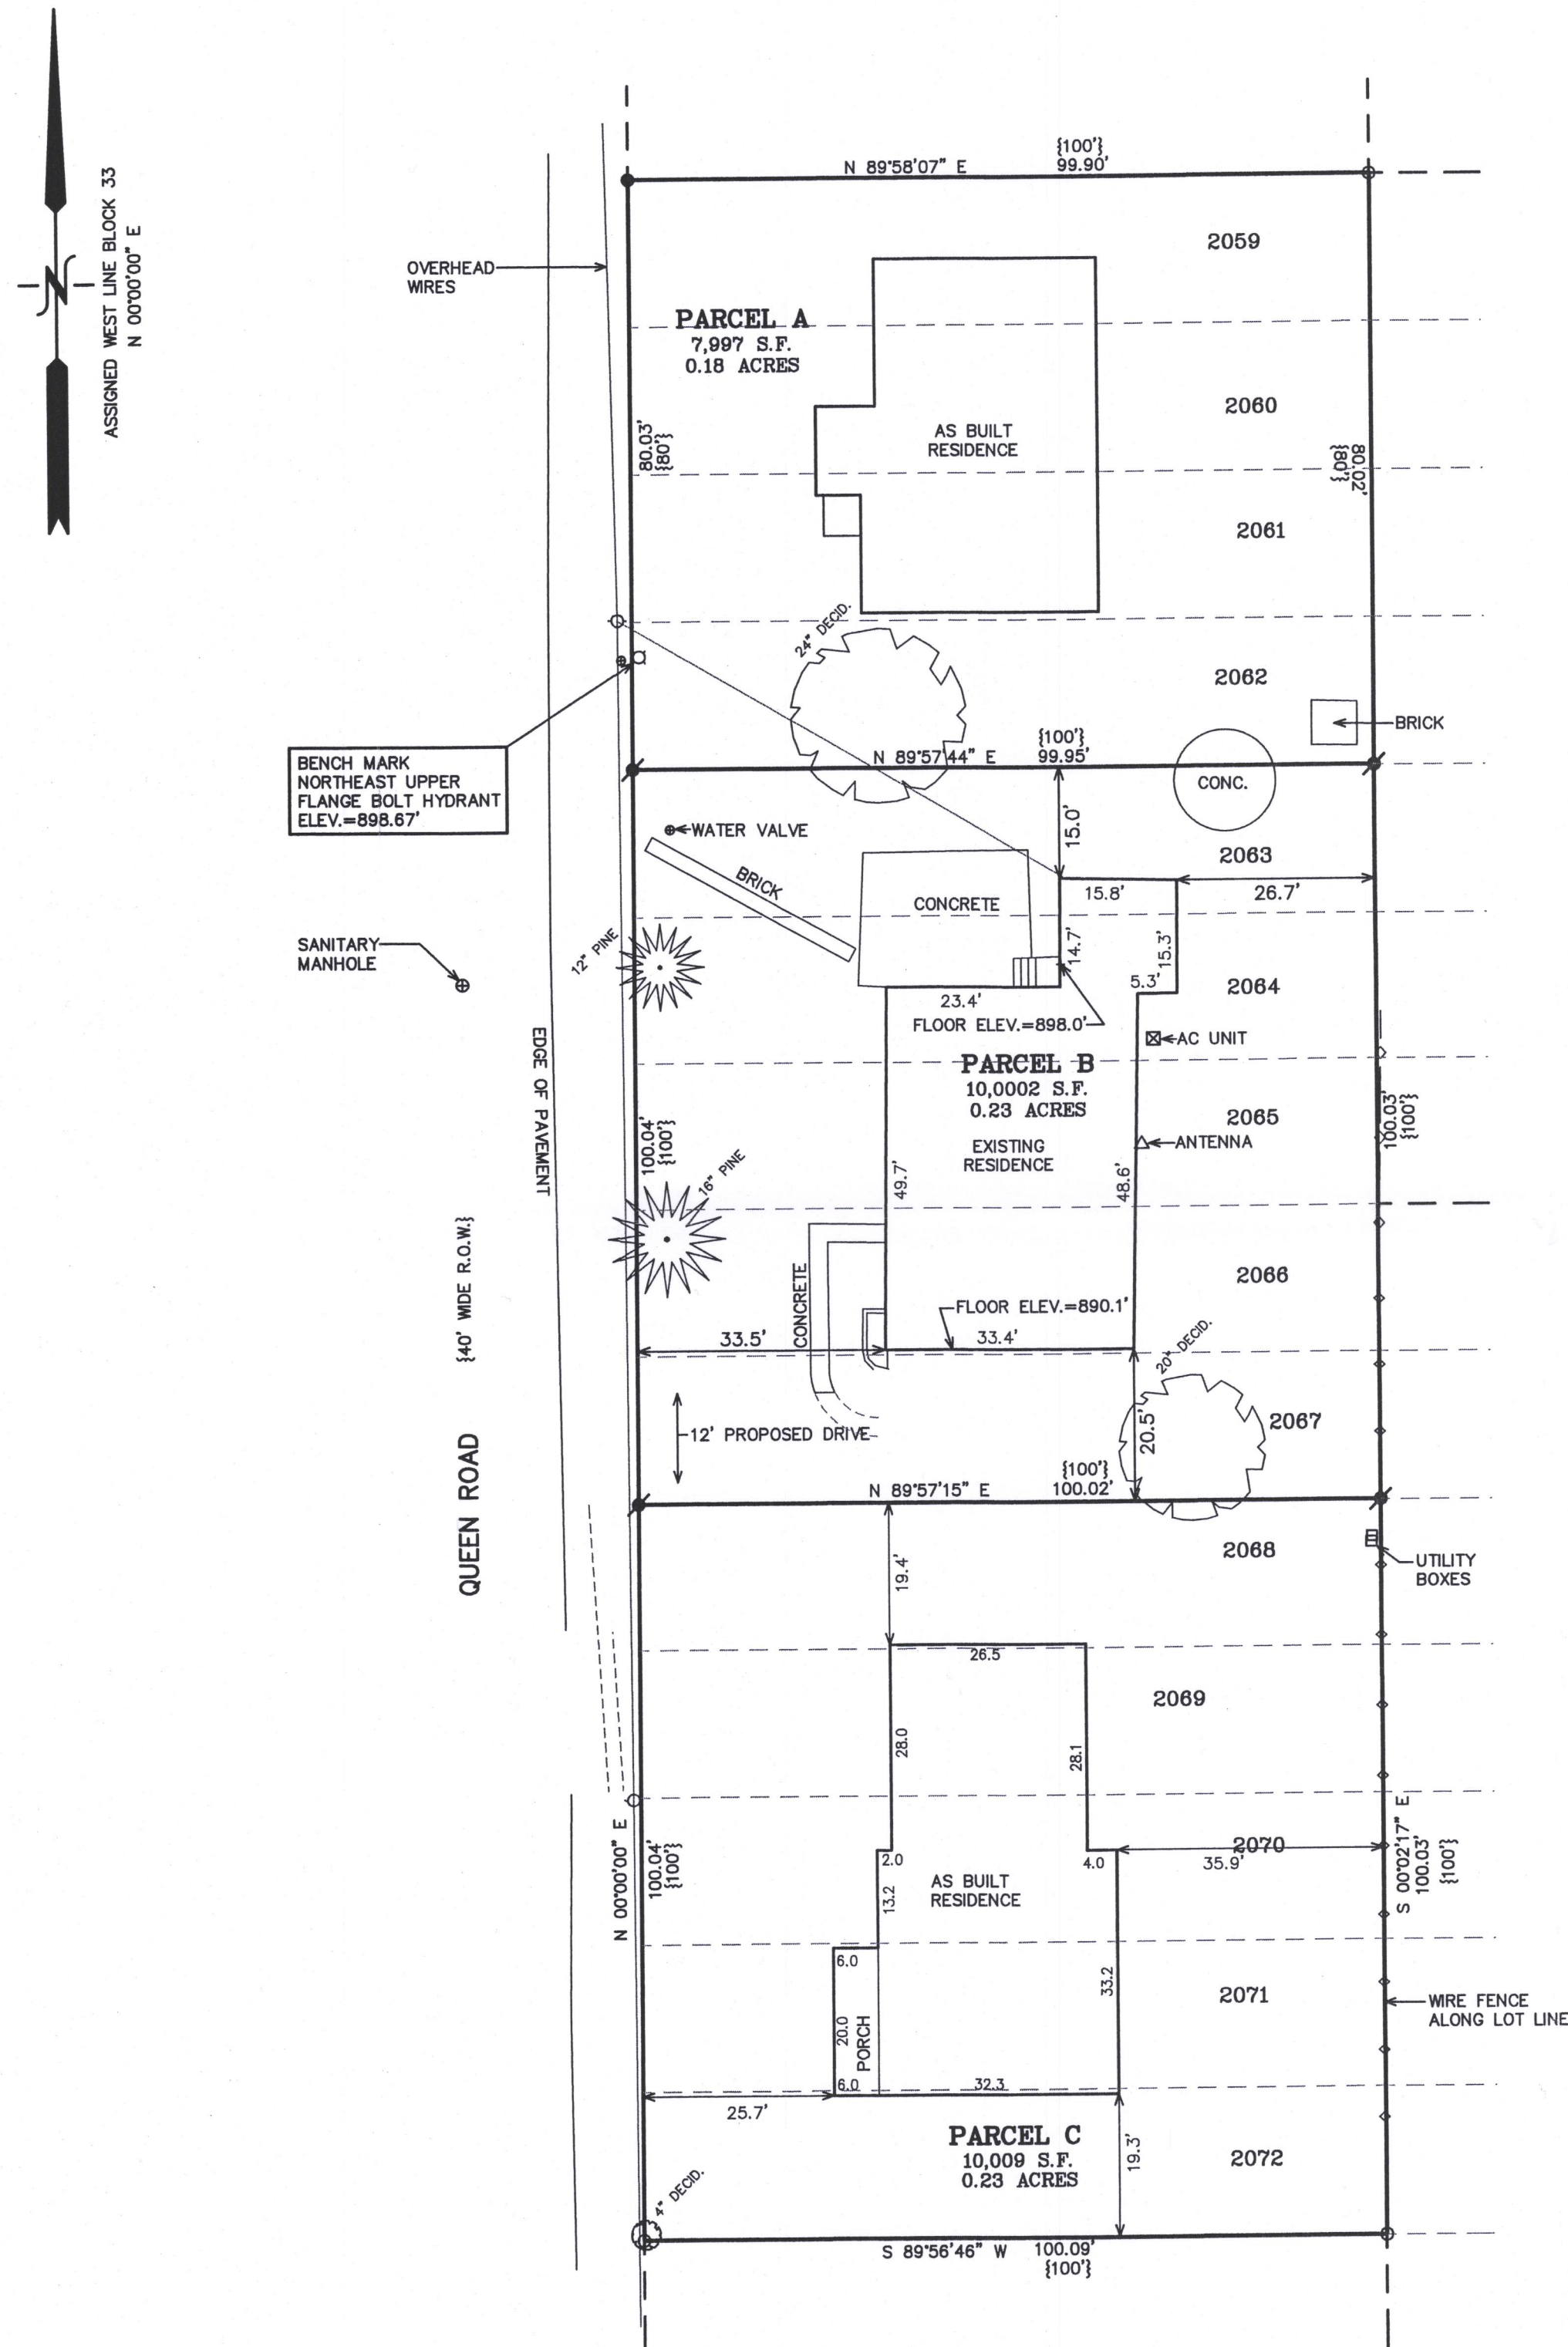

PLAT OF SURVEY

LOTS 2068-2072, BLOCK 33 OF LAKE COMO BEACH SUBDIVISION

LOCATED IN SECTIONS 22 & 27, TOWN 2 NORTH, RANGE 17 EAST, WALWORTH COUNTY, WISCONSIN

LEGAL DESCRIPTION - PARCEL C

LOTS 2068-2072, BLOCK 33 OF LAKE COMO BEACH SUBDIVISION, RECORDED AS DOCUMENT NO. P255830 (VOLUME 5, PAGE 50), LOCATED IN PART OF SECTIONS 22 AND 27, TOWN 2 NORTH, RANGE 17 EAST, WALWORTH COUNTY, WISCONSIN.

LEGAL DESCRIPTION - PARCEL A


LOTS 2059-2062, BLOCK 33 OF LAKE COMO BEACH SUBDIVISION, RECORDED AS DOCUMENT NO. P255830 (VOLUME 5, PAGE 50), LOCATED IN PART OF SECTIONS 22 AND 27, TOWN 2 NORTH, RANGE 17 EAST, WALWORTH COUNTY, WISCONSIN.

LEGAL DESCRIPTION - PARCEL B

LOTS 2063-2067, BLOCK 33 OF LAKE COMO BEACH SUBDIVISION, RECORDED AS DOCUMENT NO. P255830 (VOLUME 5, PAGE 50), LOCATED IN PART OF SECTIONS 22 AND 27, TOWN 2 NORTH, RANGE 17 EAST, WALWORTH COUNTY, WISCONSIN.

LEGEND

- O = IRON PIPE STAKE FOUND
- = IRON REBAR STAKE FOUND
- ⚡ = IRON REBAR STAKE SET, 3/4"
- {xxx} = RECORDED AS

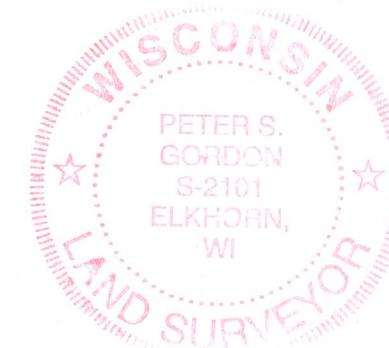

NOTE: COPIES OF THIS MAP TO WHICH THE FOLLOWING CERTIFICATE WILL APPLY SHOW THE SURVEYOR'S ORIGINAL SEAL AND SIGNATURE IN RED INK. COPIES BY ANY OTHER MEANS MAY HAVE ALTERATIONS WHICH DO NOT REPRESENT THE SURVEYOR'S WORK PRODUCT.


I HEREBY CERTIFY THAT THE ABOVE DESCRIBED PROPERTY HAS BEEN SURVEYED UNDER MY DIRECTION AND THAT THE ABOVE MAP IS A TRUE REPRESENTATION THEREOF AND SHOWS THE SIZE AND LOCATION OF THE PROPERTY AND ITS EXTERIOR BOUNDARIES. THIS SURVEY IS MADE FOR THE USE OF THE PRESENT OWNERS OF THE PROPERTY, AND ALSO THOSE WHO PURCHASE, MORTGAGE, OR GUARANTEE THE TITLE THERETO WITHIN ONE YEAR FROM THE DATE HEREOF.

REVISED 05-08-2017
TO SHOW AS BUILT RESIDENCE
PARCEL C

DATED: AUGUST 5, 2015

REVISED 9/16/2016-KB
SITE, GRADING, DRAINAGE &
EROSION CONTROL PLAN

PETER S. GORDON P.L.S. 2101

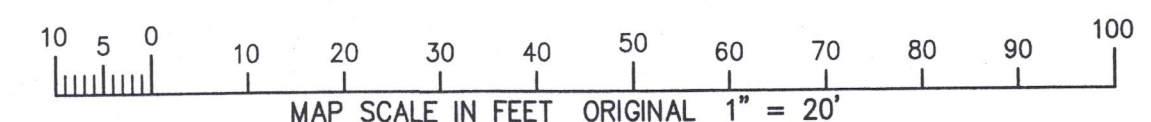

JLCB-347
JLCB-347A
JLCB-347B

217-4339



WORK ORDERED BY -
RYAN BUILDERS
N3298 CHERRY ROAD
LAKE GENEVA, WI 53147

FARRIS, HANSEN & ASSOCIATES, INC.
ENGINEERING - ARCHITECTURE - SURVEYING
7 RIDGWAY COURT P.O. BOX 437
ELKHORN, WISCONSIN 53121
OFFICE: (262) 723-2098 FAX: (262) 723-5886

REVISIONS

PROJECT NO.
9336
DATE:
8/4/2015
SHEET NO.
1 OF 1