
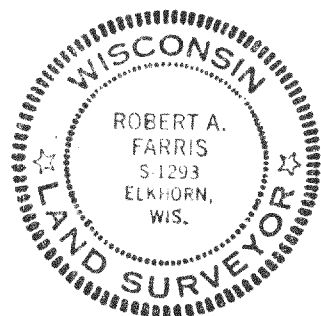


FARRIS, HANSEN & COOPER, INC.

ENGINEERING, SURVEYING AND LAND PLANNING
715 W. WALWORTH ST. - P.O. BOX 487 - ELKHORN, WI 53121

CLUB HOUSE DRIVE - 50' WIDE

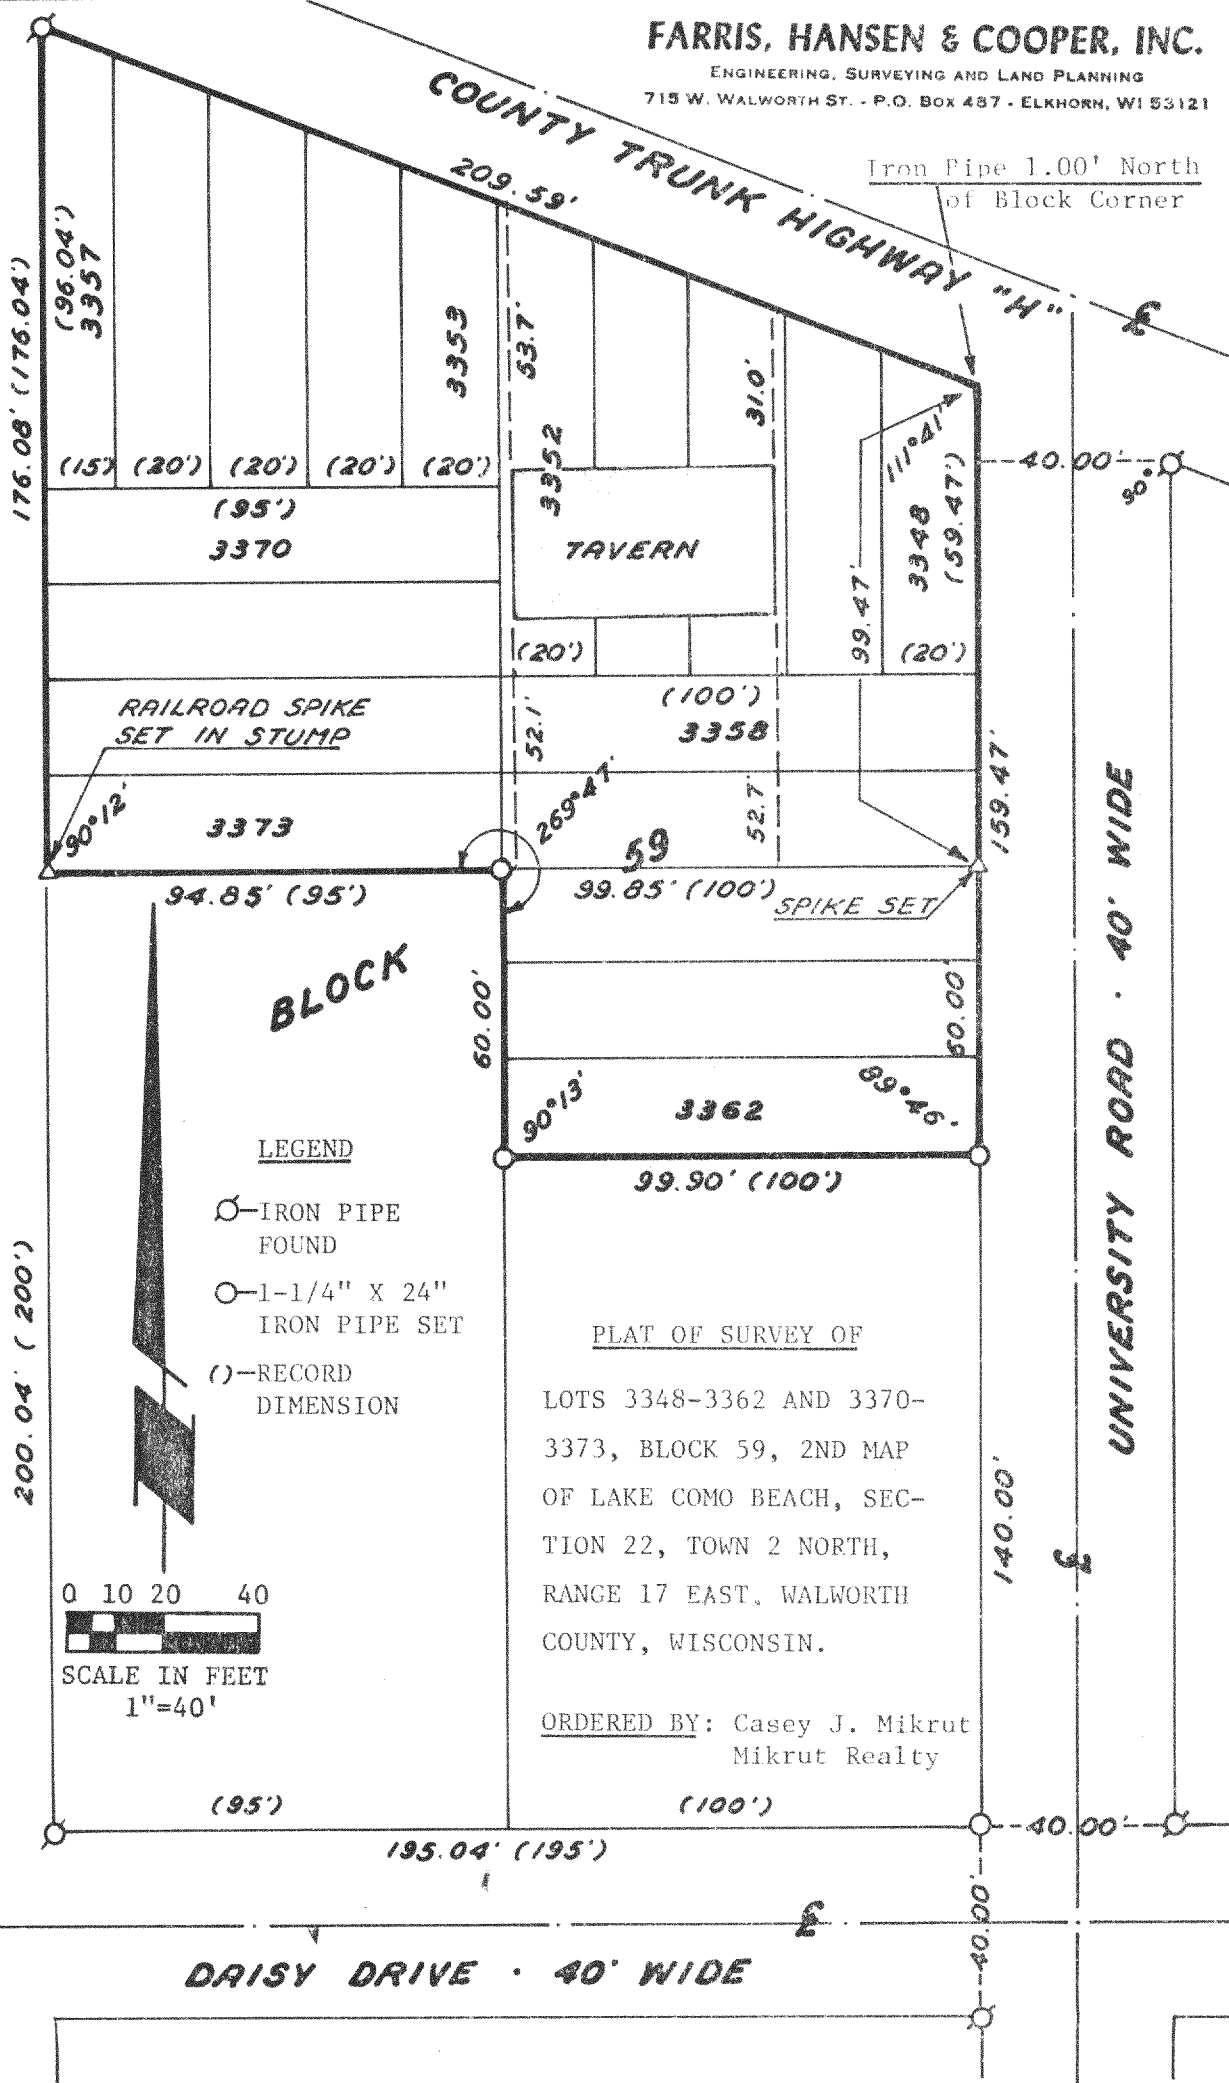

I HEREBY CERTIFY that I have surveyed the property described hereon and that this Plat of Survey is a true and accurate representation of the lot lines and the buildings thereon to the best of my professional knowledge and belief.

Robert A. Farris

Robert A. Farris, Wis. Reg. Surveyor, S-1293

Dated this 23 day of MAY, 1979.

PROJ. NO. 1521

JLKB-618

217-435