

PREPARED FOR
LYNETTE PHILLIPS
@PROPERTIES
LAKE GENEVA WI.


PLAT OF SURVEY

- OF -

PATHFINDER SURVEYING INC.
(formerly)
J.K. SURVEYING INC.
P.O BOX 322
LAKE GENEVA, WI. 53147
WWW.PATHFINDERSURVEYING.NET
262-248-8303

LOTS 8250 THRU 8254 AND LOTS 8279 THRU 8283, BLOCK 141,
FOURTH MAP OF LAKE COMO BEACH, ACCORDING TO THE
RECORDED PLAT THEREOF, LOCATED IN THE TOWN OF GENEVA,
COUNTY OF WALWORTH AND STATE OF WISCONSIN.

PARK DRIVE

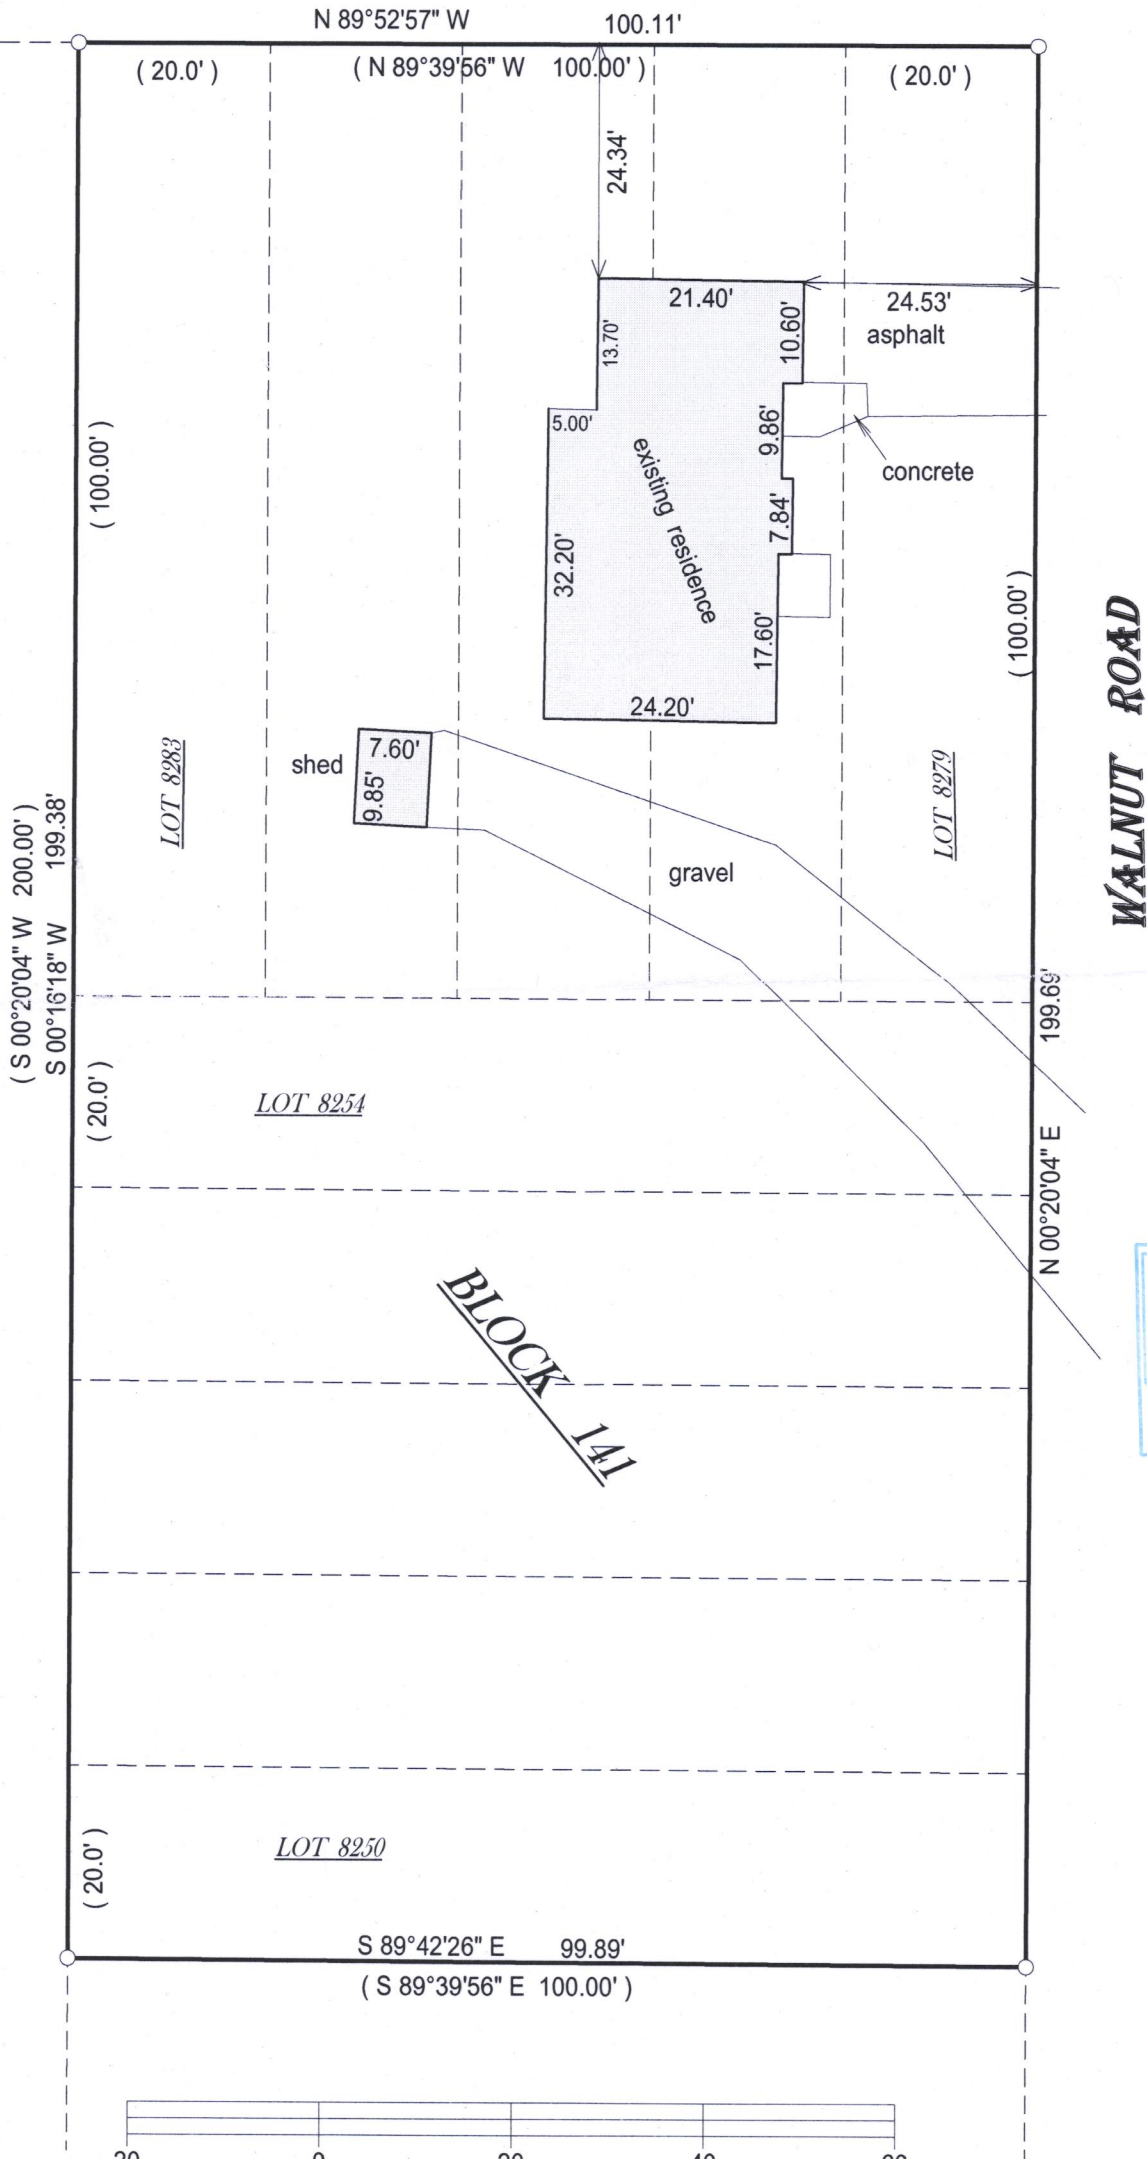


- () = recorded as
- = found iron bar
- = found iron pipe
- = set iron pipe
- = set iron bar

SCALE 1" = 20'

JOB # 17-210

TAX ID # JLCB 01770


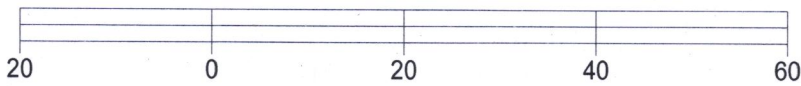


BASIS OF BEARING OF THIS PLAT: THE SUBDIVISION PLAT OF RECORD.
THE WEST LINE OF WALNUT WAS ASSUMED TO BEAR N 00°20'04" E
AS MONUMENTED.

I hereby certify that I have surveyed the above- described property and the
above map is a true representation thereof and shows the size and
location of the property, its exterior boundaries, the location and
dimensions of all structures thereon, fences, apparant easements and
roadways and visible encroachments if any.

This survey is made for the present owners of the property, and those who
purchase, mortgage, or guarantee the title thereto, within one year from
the date hereof.

DATED THIS 27TH DAY OF JULY, 2017.

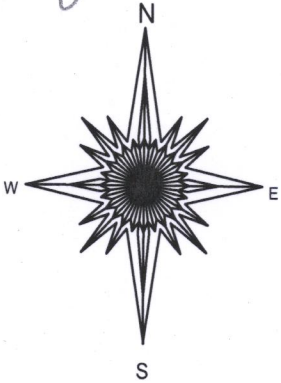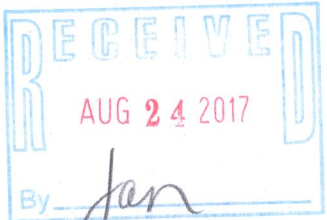

JEFFREY L KIMPS S - 2436
Wisconsin Professional Land Surveyor
(original if signed in red)

217-4357