


PREPARED FOR  
JANIS HARTLEY  
KEEFE REAL ESTATE  
LAKE GENEVA WI.

# PLAT OF SURVEY

- OF -

PATHFINDER SURVEYING INC.  
(formerly)  
J.K. SURVEYING INC.  
P.O BOX 322  
LAKE GENEVA, WI. 53147  
WWW.PATHFINDERSURVEYING.NET  
262-248-8303

LOTS 6300 THRU 6303, INCLUSIVE, BLOCK 109 OF LAKE COMO BEACH SUBDIVISION, BEING A  
SUBDIVISION LOCATED IN SECTIONS 21, 22, 27, 28 AND 29, T2N, R17E, OF THE 4TH PRINCIPAL  
MERIDIAN, GENEVA TOWNSHIP, WALWORTH COUNTY, WISCONSIN.

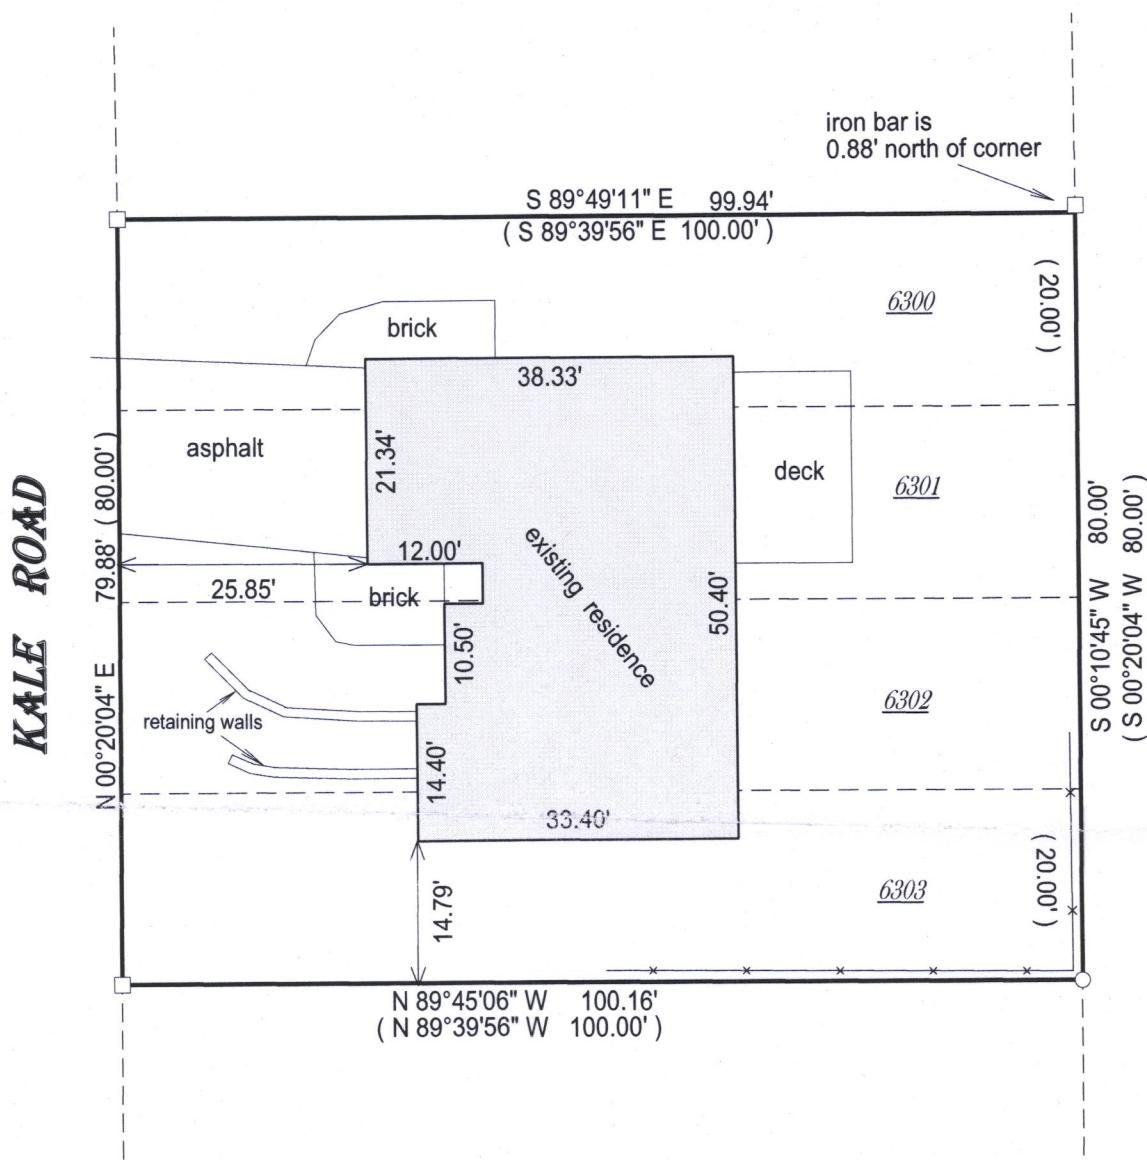

( ) = recorded as

= found iron bar

= found iron pipe


= set iron pipe

= set iron bar

SCALE 1" = 20'

JOB # 17-196

TAX ID # JLCB 01306

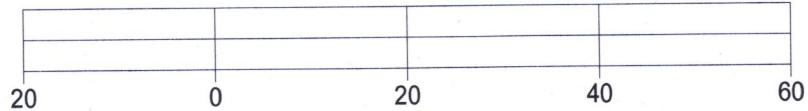

BASIS OF BEARING OF THIS PLAT: THE SUBDIVISION PLAT OF RECORD.

I hereby certify that I have surveyed the above- described property and the  
above map is a true representation thereof and shows the size and  
location of the property, its exterior boundaries, the location and  
dimensions of all structures thereon, fences, apparent easements and  
roadways and visible encroachments if any.

This survey is made for the present owners of the property, and those who  
purchase, mortgage, or guarantee the title thereto, within one year from  
the date hereof.

DATED THIS 14TH DAY OF JULY, 2017.



JEFFREY L. KIMPS S-2436  
Wisconsin Professional Land Surveyor  
(original if signed in red)

217-4358